

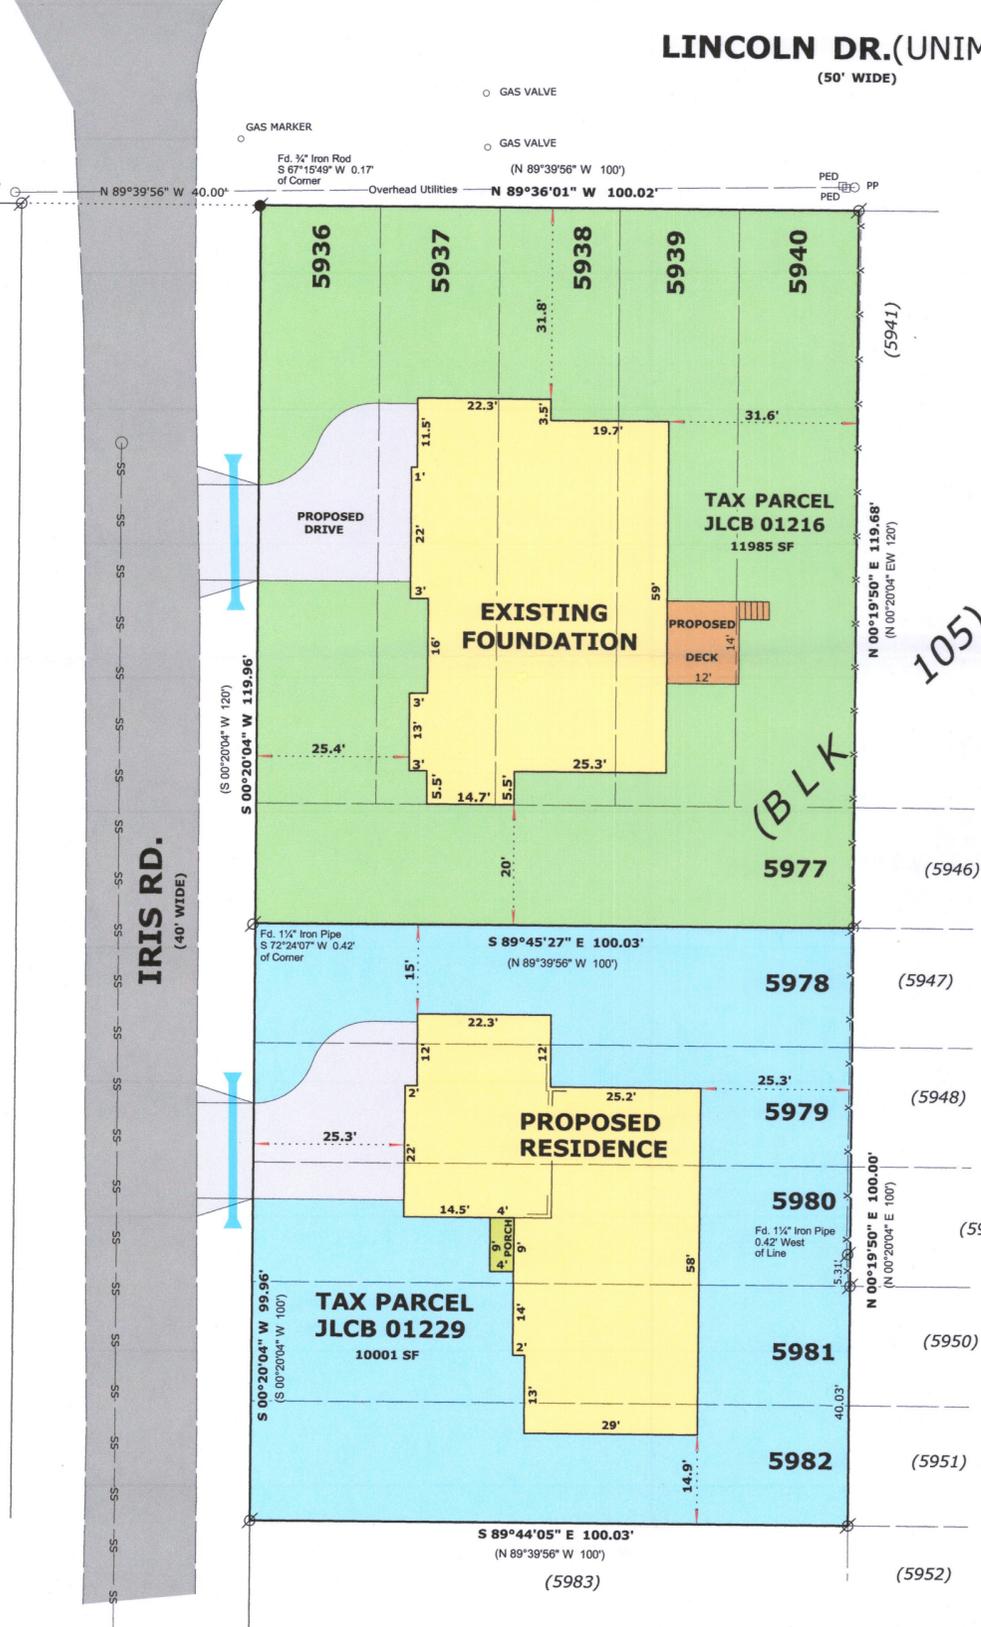


PLAT OF SURVEY

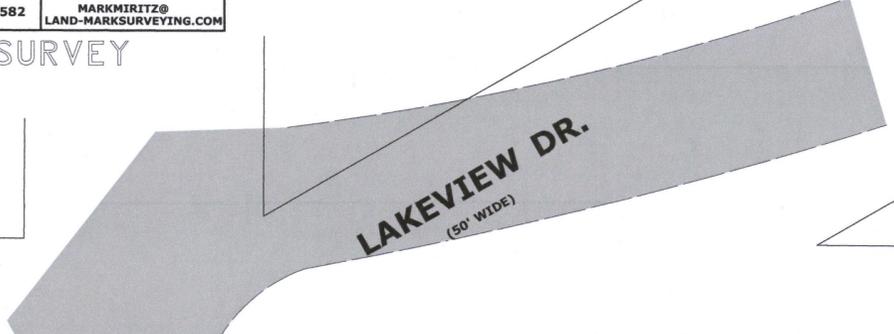

LEGAL DESCRIPTION
 (Tax Parcel JLCB 01216)
 LOCATED IN THE SOUTHWEST 1/4 OF THE NORTHEAST 1/4, SECTION 28,
 TOWNSHIP 2 NORTH, RANGE 15 EAST, IN THE TOWN OF GENEVA, WALWORTH
 COUNTY, WISCONSIN
 LOTS 5936 THRU 5940 (INCLUSIVE) AND LOT 5977, ALL IN BLOCK 105,
 LAKE COMO BEACH MAP NO. 1

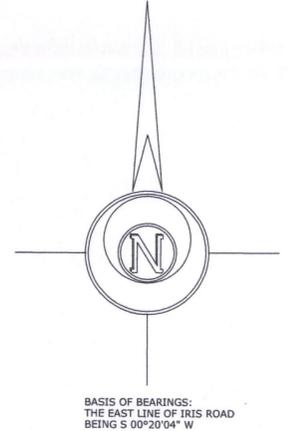

LEGAL DESCRIPTION
 (Tax Parcel JLCB 01229)
 LOCATED IN THE SOUTHWEST 1/4 OF THE NORTHEAST 1/4, SECTION 28,
 TOWNSHIP 2 NORTH, RANGE 15 EAST, IN THE TOWN OF GENEVA, WALWORTH
 COUNTY, WISCONSIN
 LOTS 5978 THRU 5982 (INCLUSIVE), ALL IN BLOCK 105, LAKE COMO
 BEACH MAP NO. 1



ORDERED BY:
 Basso Builders Inc.
 405 Skyline Dr.
 Lake Geneva, WI 53147

- LEGEND**
- FOUND IRON PIPE
 - FOUND IRON ROD
 - RECORDED AS DIMENSION
 - EXISTING FENCE



SCALE: 1 INCH = 20 FEET
 "I hereby certify that the above described property has been surveyed by me or under my direction and that the above map is a true representation thereof and shows the size and location of the property, its exterior boundaries, the location of all visible structures and dimensions of all principal buildings thereon, boundary fences, apparent easements, roadways and visible encroachments, if any."
 "This survey is made for the use of the present owners of the property, and also those who purchase, mortgage, or guarantee the title thereto within one year from date hereof."

Mark L. Miritz
 MARK L. MIRITZ
 WISCONSIN PROFESSIONAL
 LAND SURVEYOR S-2582

REVISED AUGUST 31, 2022 TO
 SHOW FOUNDATION "AS BUILT"

JLCB-0116 JLCB-1229

217-5014