
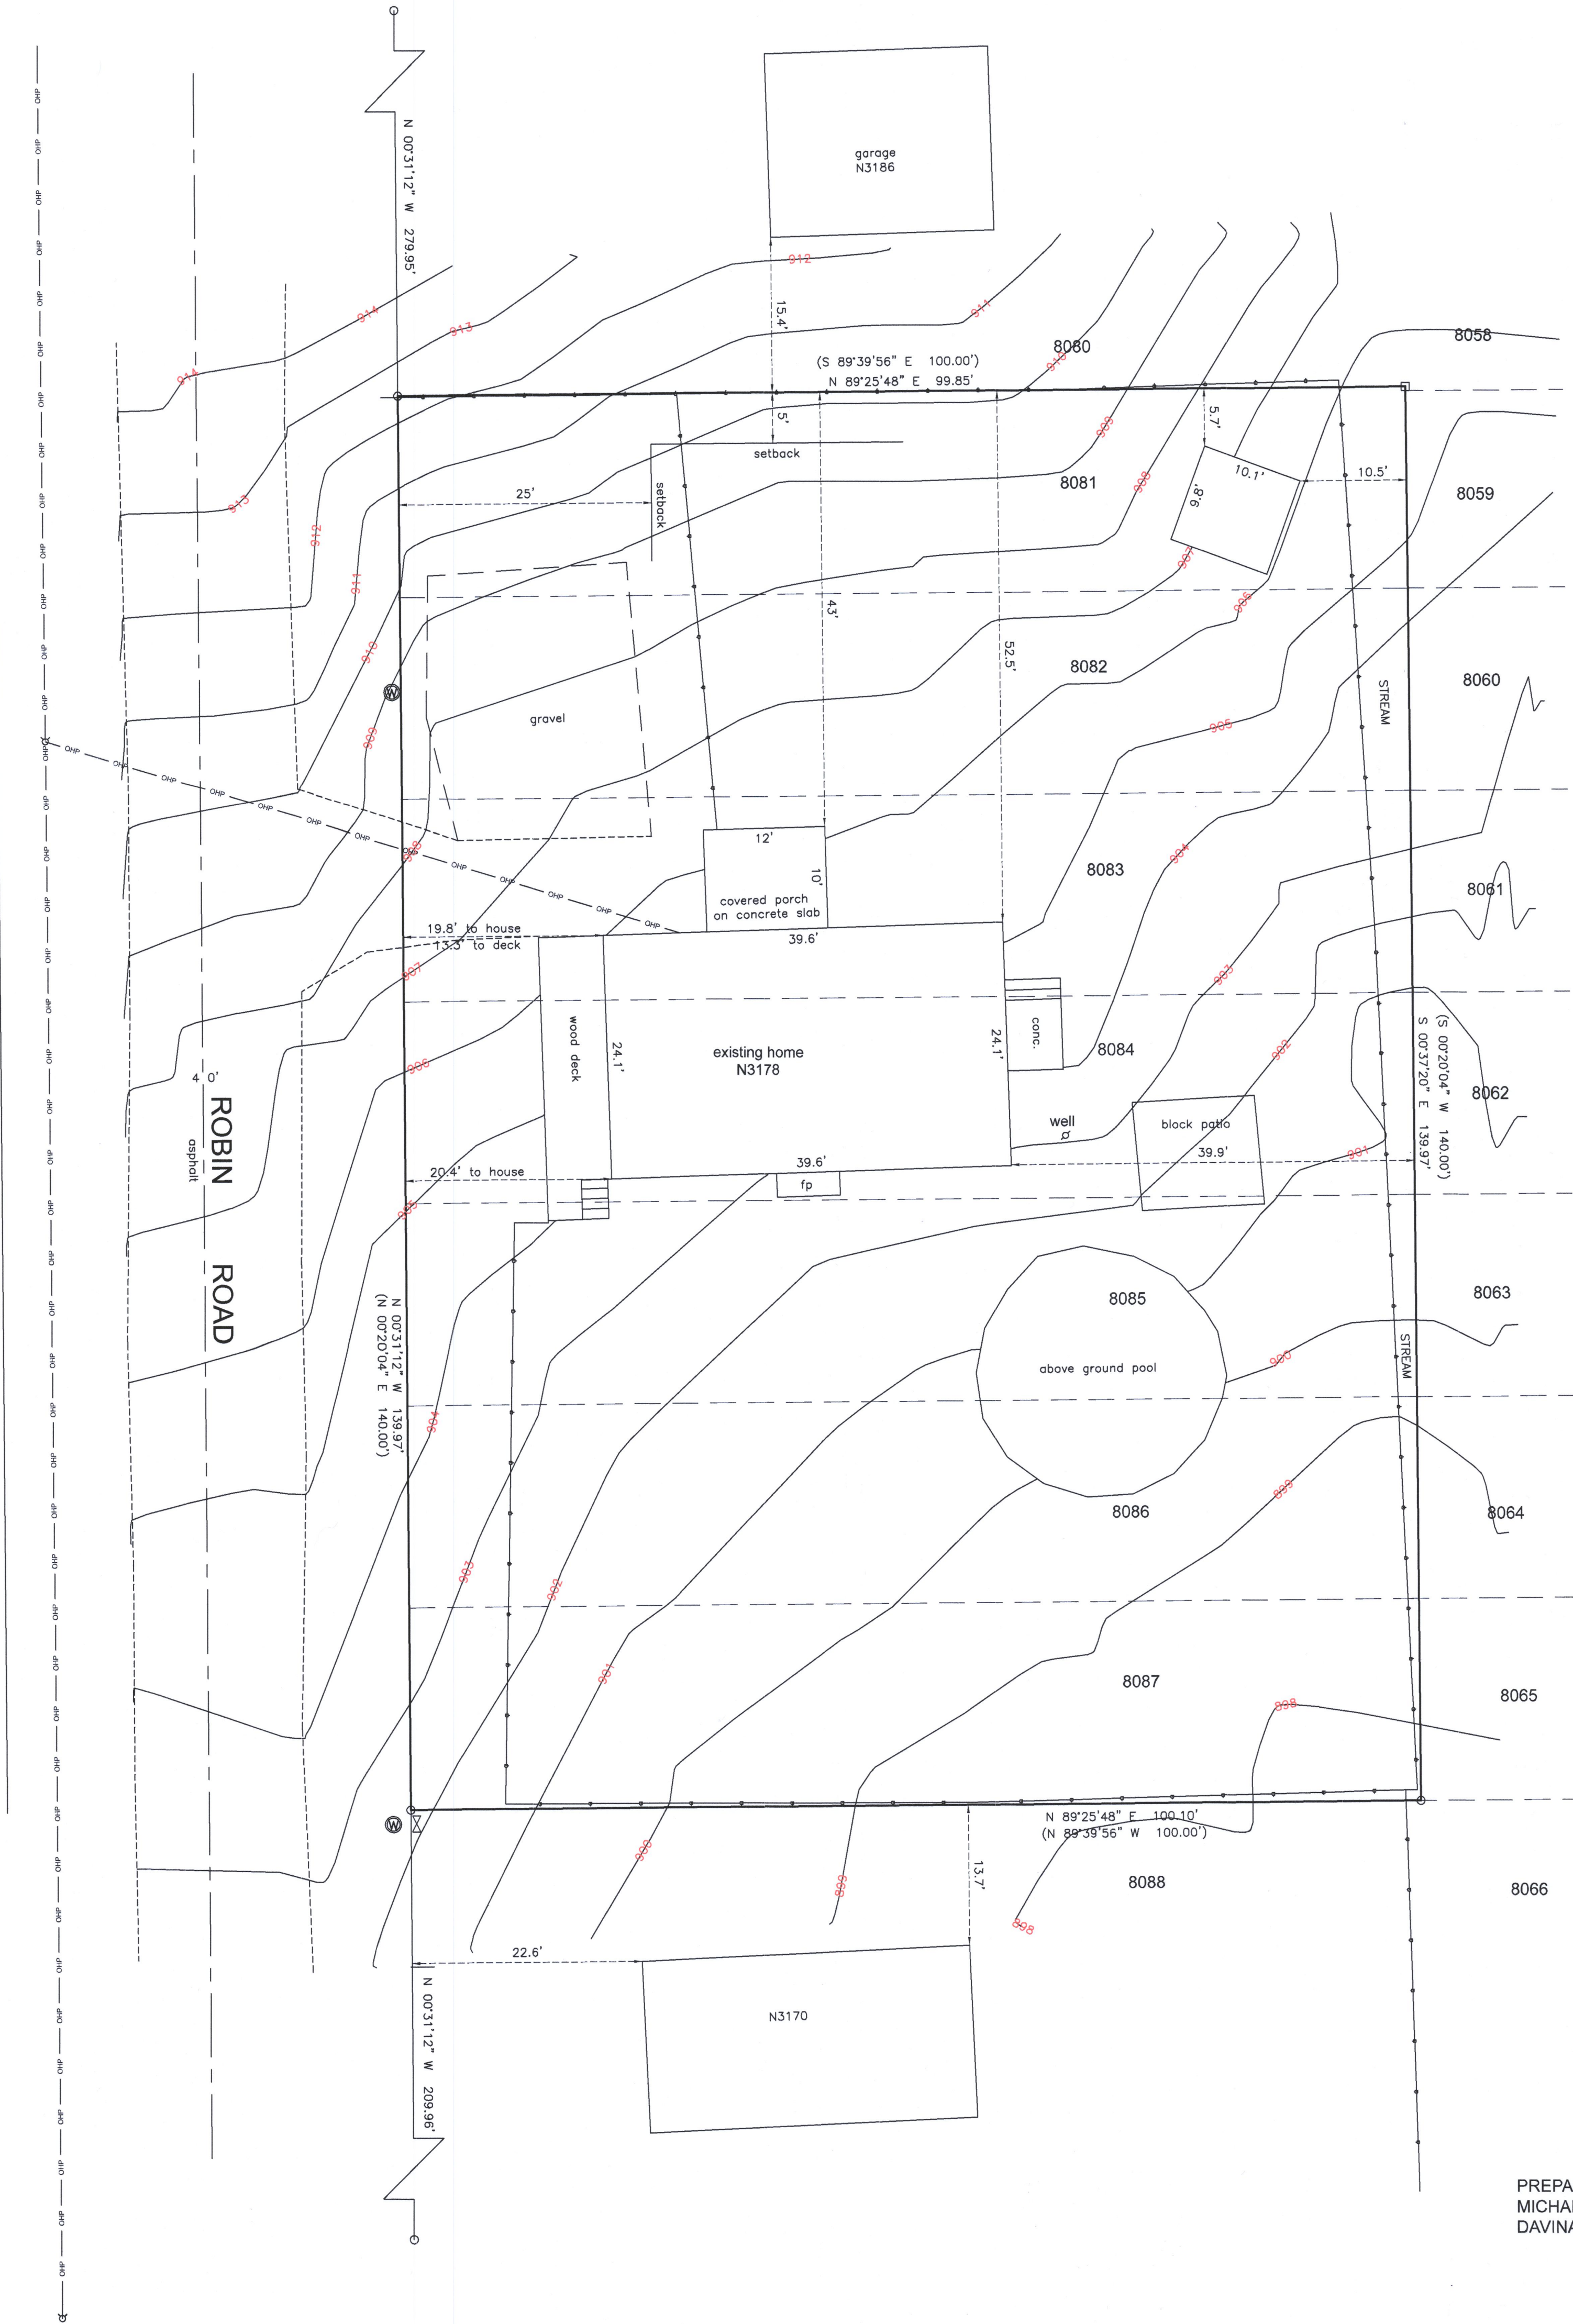
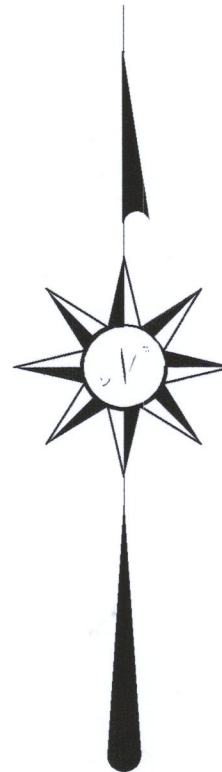


PLAT OF SURVEY


Lots 8081 through 8087 in Block 137 of LAKE COMO BEACH, being a part of Section 21 & 28, in Town 2 North, Range 17 East, in the Town of Geneva, Walworth County, Wisconsin.

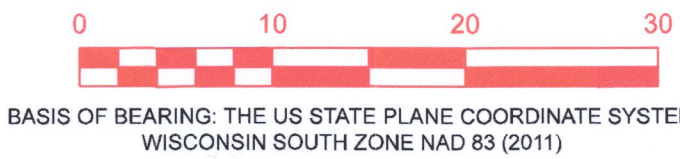

I HEREBY CERTIFY THAT I HAVE SURVEYED THE ABOVE DESCRIBED PROPERTY AND THE ABOVE MAP IS A TRUE REPRESENTATION THEREOF AND SHOWS THE SIZE AND LOCATION OF THE PROPERTY, ITS EXTERIOR BOUNDARIES, THE LOCATION AND DIMENSIONS OF ALL STRUCTURES THEREON, FENCES, APPARENT EASEMENTS, ROADWAYS, AND VISIBLE ENCROACHMENTS, IF ANY.

THIS SURVEY IS MADE FOR THE PRESENT OWNERS OF THE PROPERTY AND THOSE WHO PURCHASE, MORTGAGE, OR GUARANTEE THE TITLE THERETO WITHIN ONE YEAR FROM THIS DATE HEREOF.

DATED THIS 1ST DAY OF SEPTEMBER 2022

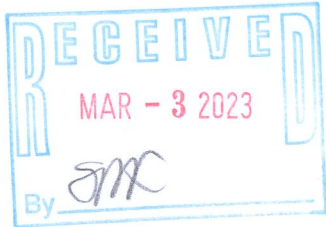


- (XXX) = RECORDED AS
 - = FOUND IRON PIPE
 - = SET IRON PIPE
 - = FOUND IRON BAR
 - CHP — = OVERHEAD UTILITY LINES
- SCALE 1" = 10'
- JOB NO. 2022-024
- TAX ID # JLCB 01722

0.3214 Acres
Soils - Ph, MyC
Zoning R2
Shoreland

PREPARED FOR:
MICHAEL RACINE
DAVINA RACINE

LAKELAND SURVEYORS LLC
P O BOX 188
DELAVAN, WI 53545
262-475-9567
email: lakelandsurveyors@outlook.com

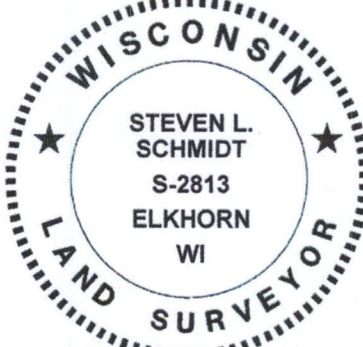

Steven L. Schmidt

STEVEN L. SCHMIDT S - 2813
Wisconsin Professional Land Surveyor

217-5059