


LOCATION: Lake Geneva, Wisconsin
PREPARED FOR: Mike Zinsky
PROPERTY DESCRIPTION: (As-Surveyed)
 Lots 1, 2, 3, and 4, of Certified Survey Map No.: 4328, being a part of
 the Southeast $\frac{1}{4}$ of Section 34, also being a part of the Northwest $\frac{1}{4}$,
 Township 2 North, Range 17 East, located in the Town of Geneva, Walworth
 County, Wisconsin.
CURRENT OWNER: Dreamfield, LLC
TAX ID: JA 432800001, JA 432800002, JA 432800003, JA 432800004
Survey No. 22.8001.03
February 16, 2023

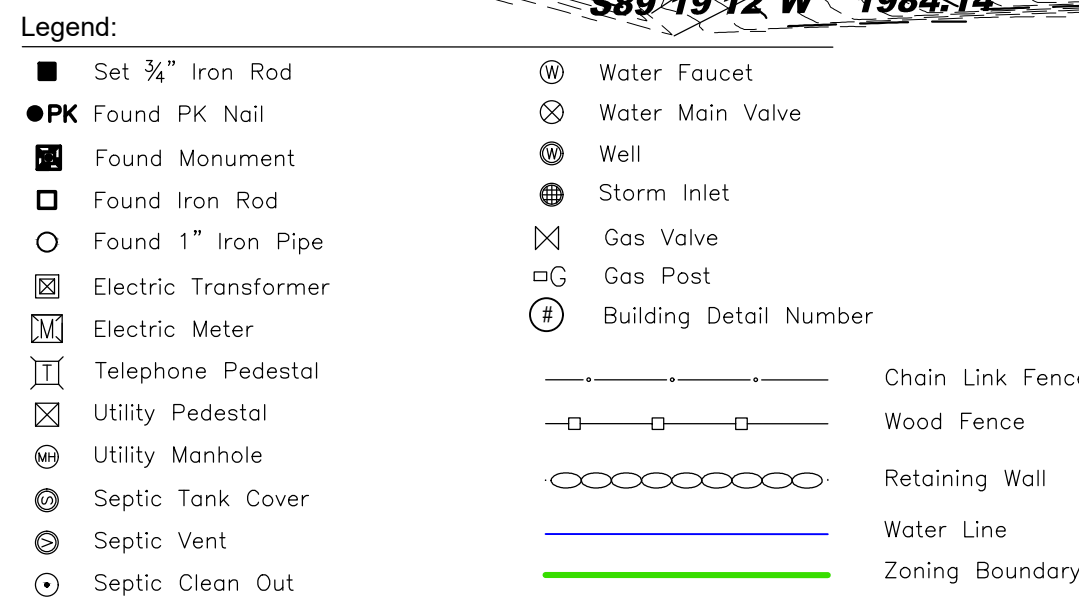

Rick R. Hillmann, Professional Land Surveyor, S-3005