


HAROLD H. KOLB

REGISTERED PROFESSIONAL LAND SURVEYOR
LAKE GENEVA, WISCONSIN

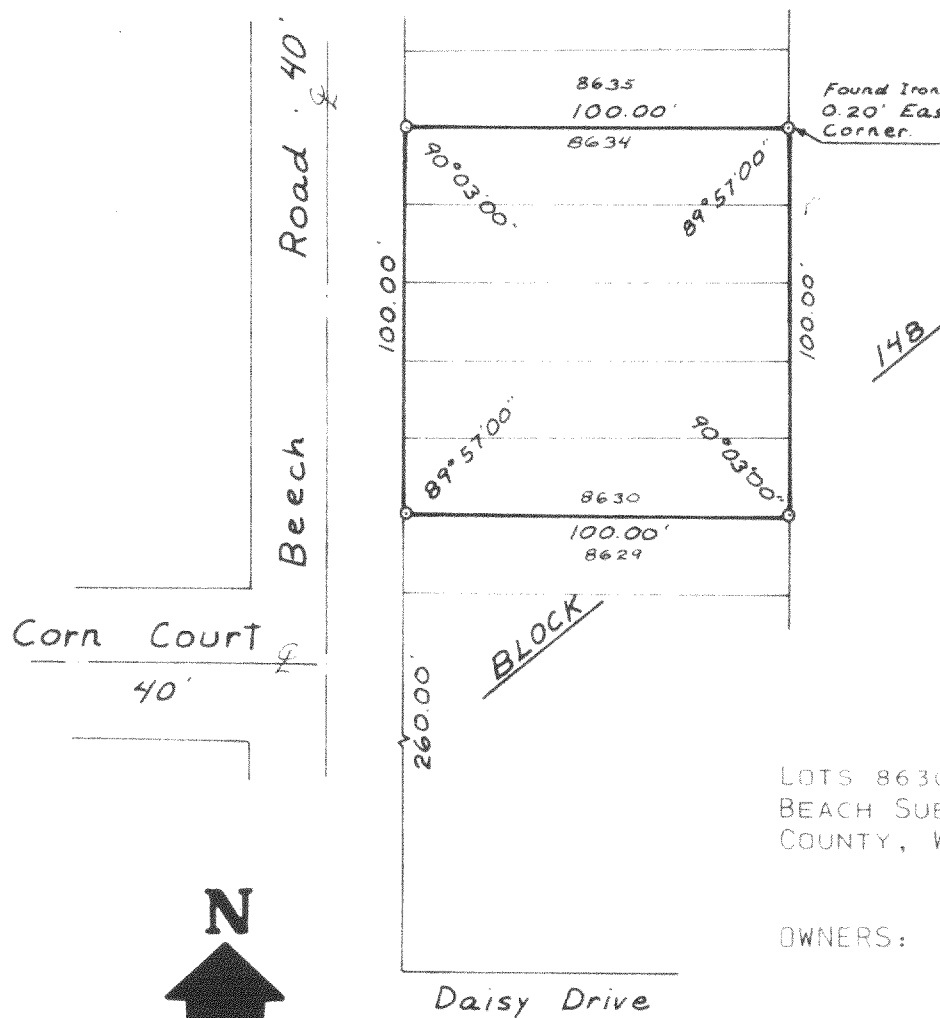

PLAT OF SURVEY OF

LOTS 8630-8634, BLOCK 148, LAKE COMO
BEACH SUBDIVISION, T2N, R17E, WALWORTH
COUNTY, WISCONSIN.

OWNERS: PATRICK AND FRIEDA GIUDICE

ACCURACY: DISTANCES $\pm 0.01'$
ANGLES $\pm 05''$

ERROR OF CLOSURE--LESS THAN ONE PART
IN 3000


Scale 1"=50'

LEGEND

- ϕ — IRON PIPE FOUND
- $\circ$ — IRON PIPE PLACED
- $\bullet$ — CONCRETE MONUMENT
- $\times$ — SPIKE

I, HAROLD H. KOLB, DO HEREBY CERTIFY THAT I HAVE
SURVEYED THE PROPERTY HEREON DESCRIBED ACCORDING
TO THE OFFICIAL RECORDS, AND THAT THE PLAT HEREON
IS A CORRECT REPRESENTATION OF THE LOT LINES.

HAROLD H. KOLB
WISCONSIN REGISTERED LAND SURVEYOR, S-187
DATE Sept 3, 1976

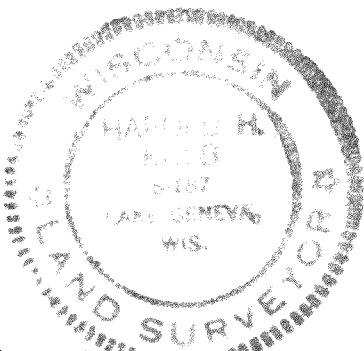

JLCB-1846

217-518