


PLAT OF SURVEY OF

I certify that I have surveyed the above described property and that the plat shown hereon is an accurate survey & a true representation thereof and correctly shows the exterior boundary lines and all divisions of said property.


July 12, 1977


 THOMAS P.A. JENSEN
 JENSEN SURVEYING AND MAPPING
 ELKHORN, WISCONSIN

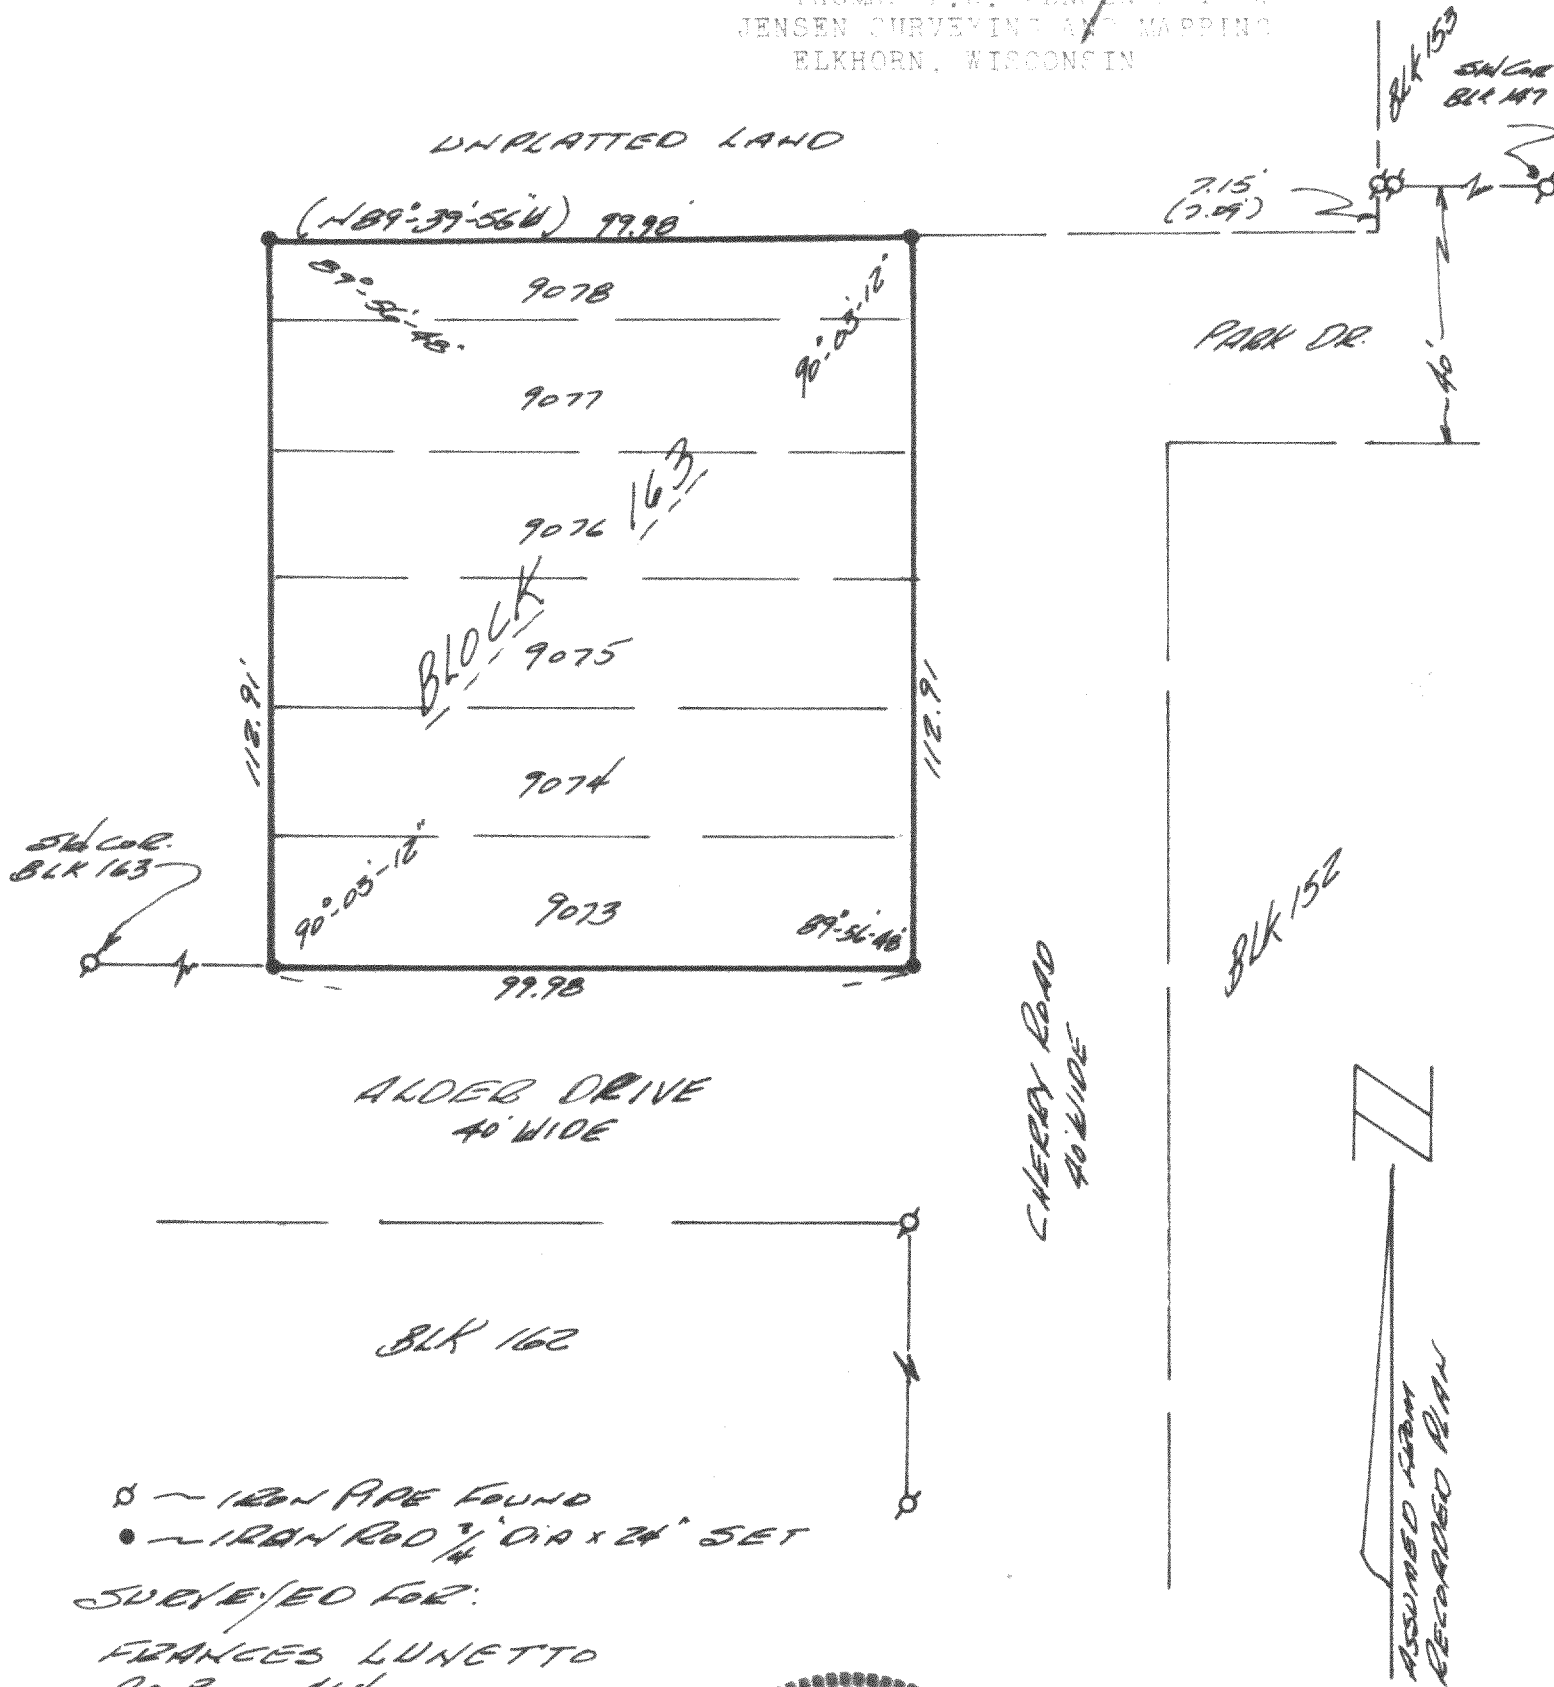

Q ~ IRON PIPE FOUND
• ~ IRON ROD $\frac{3}{4}$ " DIA x 24" SET
SURVEILED FOR:
FRANCES LUNETTO
P.O. Box 464
LAKE GEVANA, WIS

P.O. # 1917.030

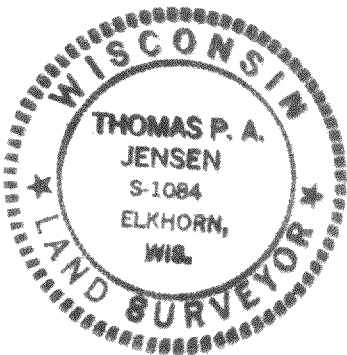

SCALE 1" = 30'

JLCB-195/

217-528