


KOLB LAND CONSULTING, INC.
LAND SURVEYING • SUBDIVIDING • LAND PLANNING

LAKE GENEVA, WISCONSIN 53147


WHITEWATER, WISCONSIN 53190

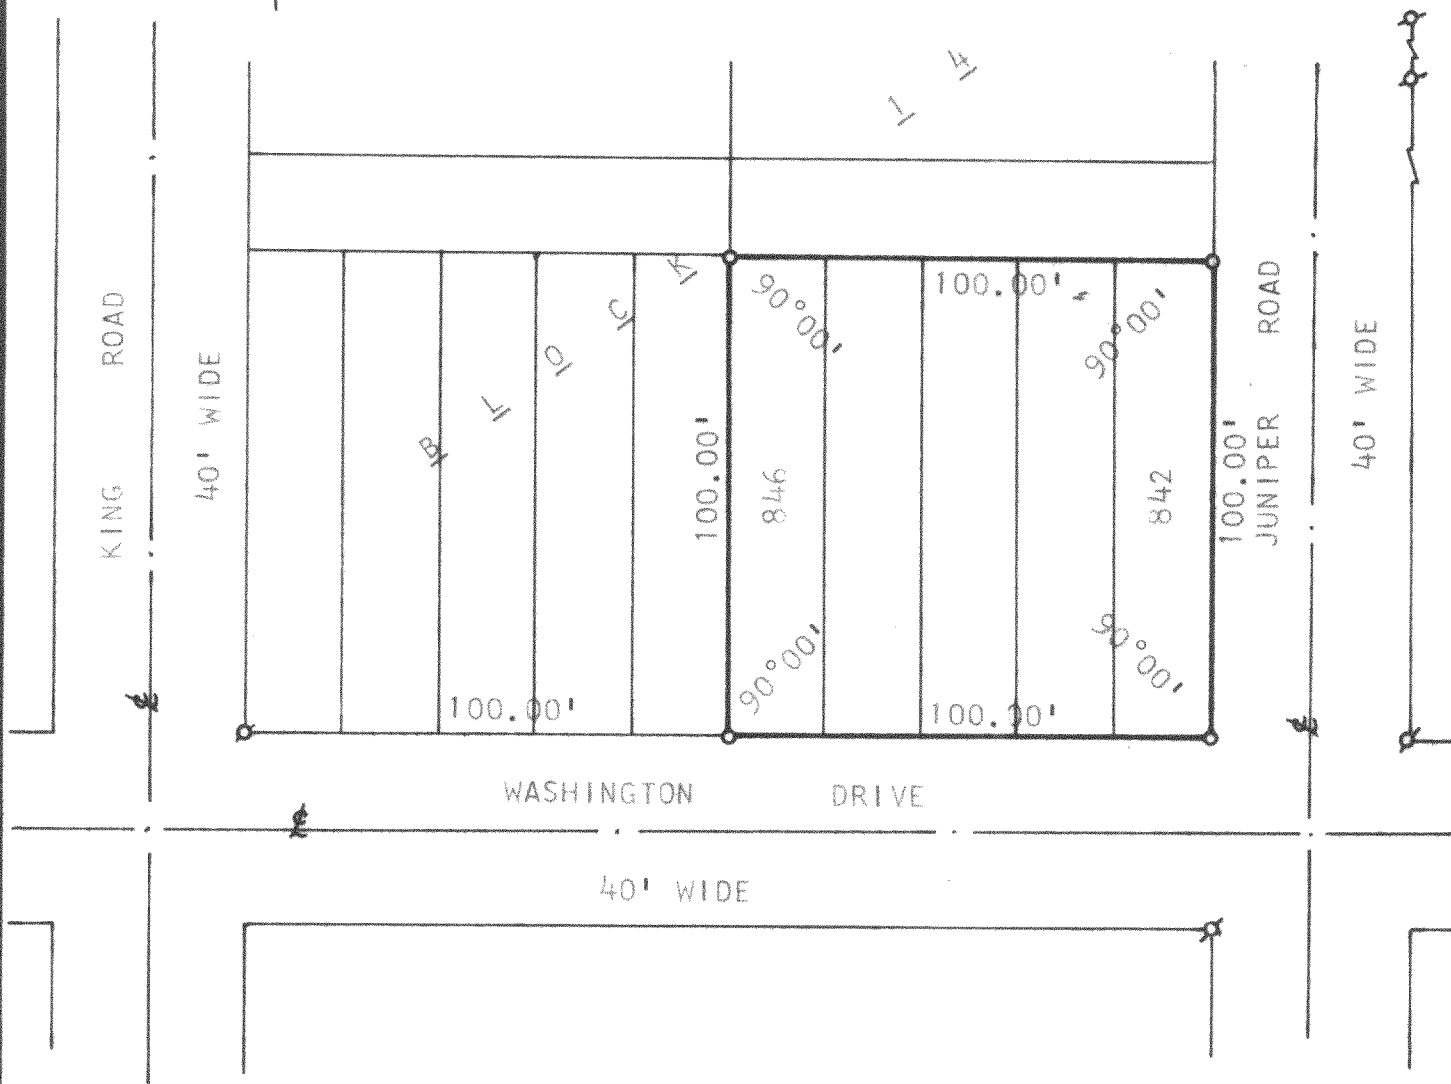

PLAT OF SURVEY OF

LOTS 842-846, BLOCK 14, LAKE COMO BEACH SUBDIVISION,
LOCATED IN T 2 N, R 17 E, WALWORTH COUNTY, WISCONSIN.

ORDERED BY: JOHN E. POHLE
909 HENRY STREET
LAKE GENEVA, WISCONSIN 53147

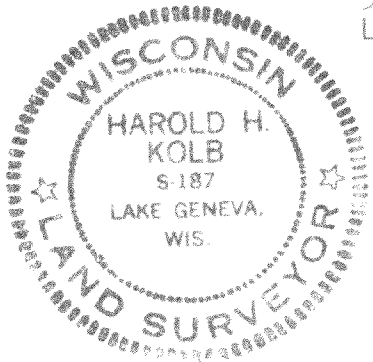

SCALE: 1"=40'

Ø-IRON PIPE FOUND
○-IRON PIPE PLACED

I, HAROLD H. KOLB, DO HEREBY CERTIFY THAT
I HAVE SURVEYED THE PROPERTY HEREON DESCRIBED
ACCORDING TO THE OFFICIAL RECORDS, AND THAT
THIS PLAT IS A CORRECT REPRESENTATION OF THE
LOT LINES TO THE BEST OF MY KNOWLEDGE AND
BELIEF.

Harold H. Kolb

HAROLD H. KOLB
WISCONSIN REGISTERED LAND SURVEYOR, S-187

DATE April 16, 1979

JCCB-93F

217-535 K