
KOLB LAND CONSULTING, INC.

LAND SURVEYING . SUBDIVIDING . LAND PLANNING

LAKE GENEVA, WISCONSIN 53147

WHITEWATER, WISCONSIN 53190

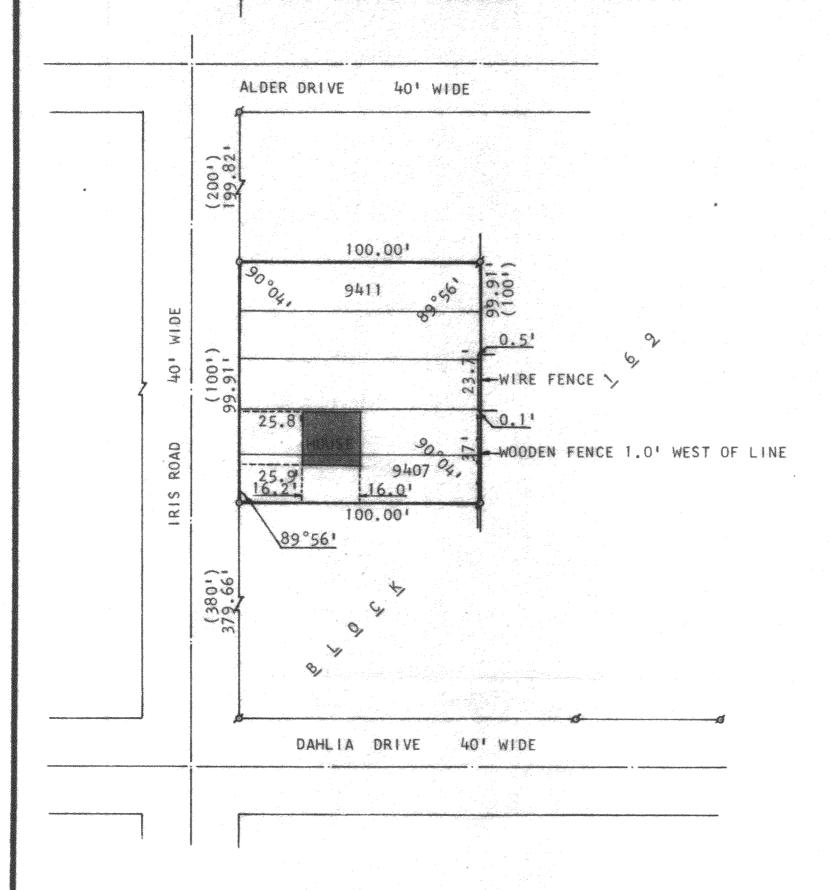

PLAT OF SURVEY OF

LOTS 9407-9411, BLOCK 169, LAKE COMO BEACH SUBDIVISION, LOCATED IN T 2 N, R 17 E, WALWORTH COUNTY, WISCONSIN.

ORDERED BY: CENTURY 21-ARLENE REDELL SKANDIA REALTY 611 MAIN STREET LAKE GENEVA, WIS. 53147



SCALE: 1"=40"

ø-IRON PIPE FOUND •-IRON PIPE PLACED ()-RECORDED AS



I, HAROLD H. KOLB, DO HEREBY CERTIFY THAT I HAVE SURVEYED THE PROPERTY HEREON DESCRIBED ACCORDING TO THE OFFICIAL RECORDS, AND THAT THE PLAT HEREON IS A CORRECT REPRESENTATION OF THE LOT LINES TO THE BEST OF MY KNOWLEDGE AND BELIEF.

HAROLD H. KOLB WISCONSIN REGISTERED LAND SURVEYOR, S-187

JLKB-2028