

PLAT OF SURVEY OF LOTS 11138 TO 11142, INCLUSIVE,
BLOCK 201, 5TH MAP OF LAKE COMO BEACH, LOCATED IN
THE NE $\frac{1}{4}$ OF SECTION 21, T2N R1E, WAL. CO. WIS.

I CERTIFY THAT I SURVEYED THE ABOVE DESCRIBED PROPERTY &
THAT THE PLAT SHOWN HEREON IS AN ACCURATE SURVEY &
A TRUE REPRESENTATION THEREON & CORRECTLY SHOWS
THE BOUNDARY LINES OF SAID PROPERTY



OCT 8, 1977

Thomas P. Jensen S-1084

JENSEN SURVEYING & MAPPING
ELKHORN, WISCONSIN

OWNER: M. WOJCIOWICZ

SURVEYED FOR: AUTUMN HOMES
SPRING GROVE, ILL. 60081

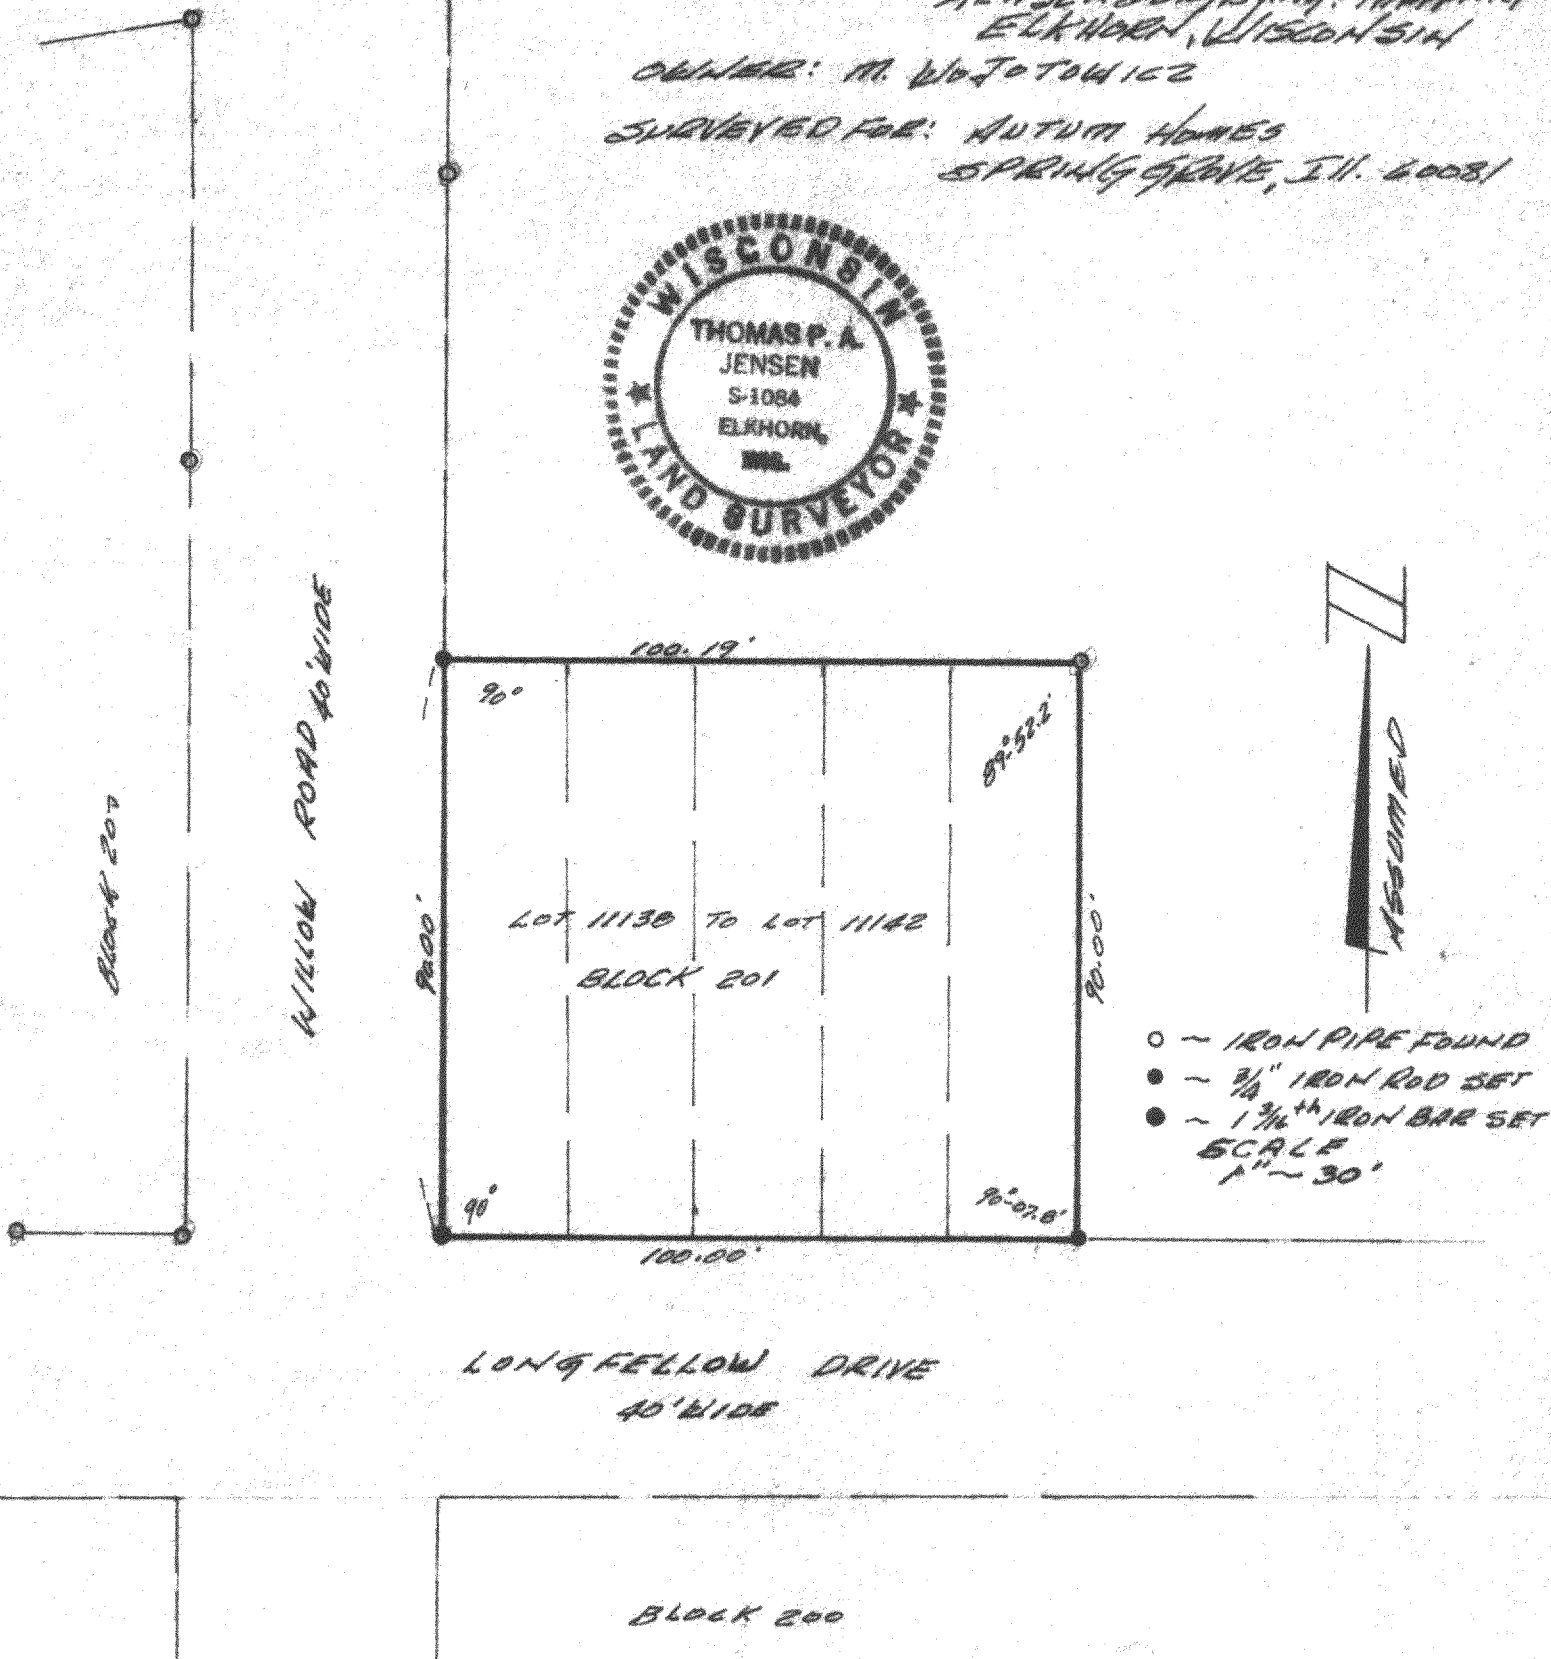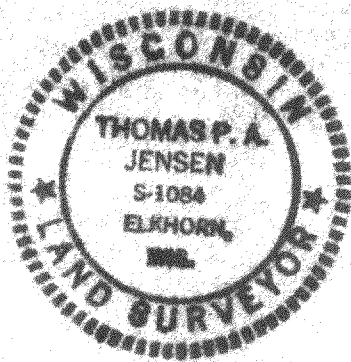

1977.054

217-550