



PLAT OF SURVEY OF LOTS 4213-4216 & 4185-4189,
BLOCK 72 LAKE COMO BEACH SUBDIVISION,
TOWN OF GENEVA, WALWORTH CO., WISCONSIN

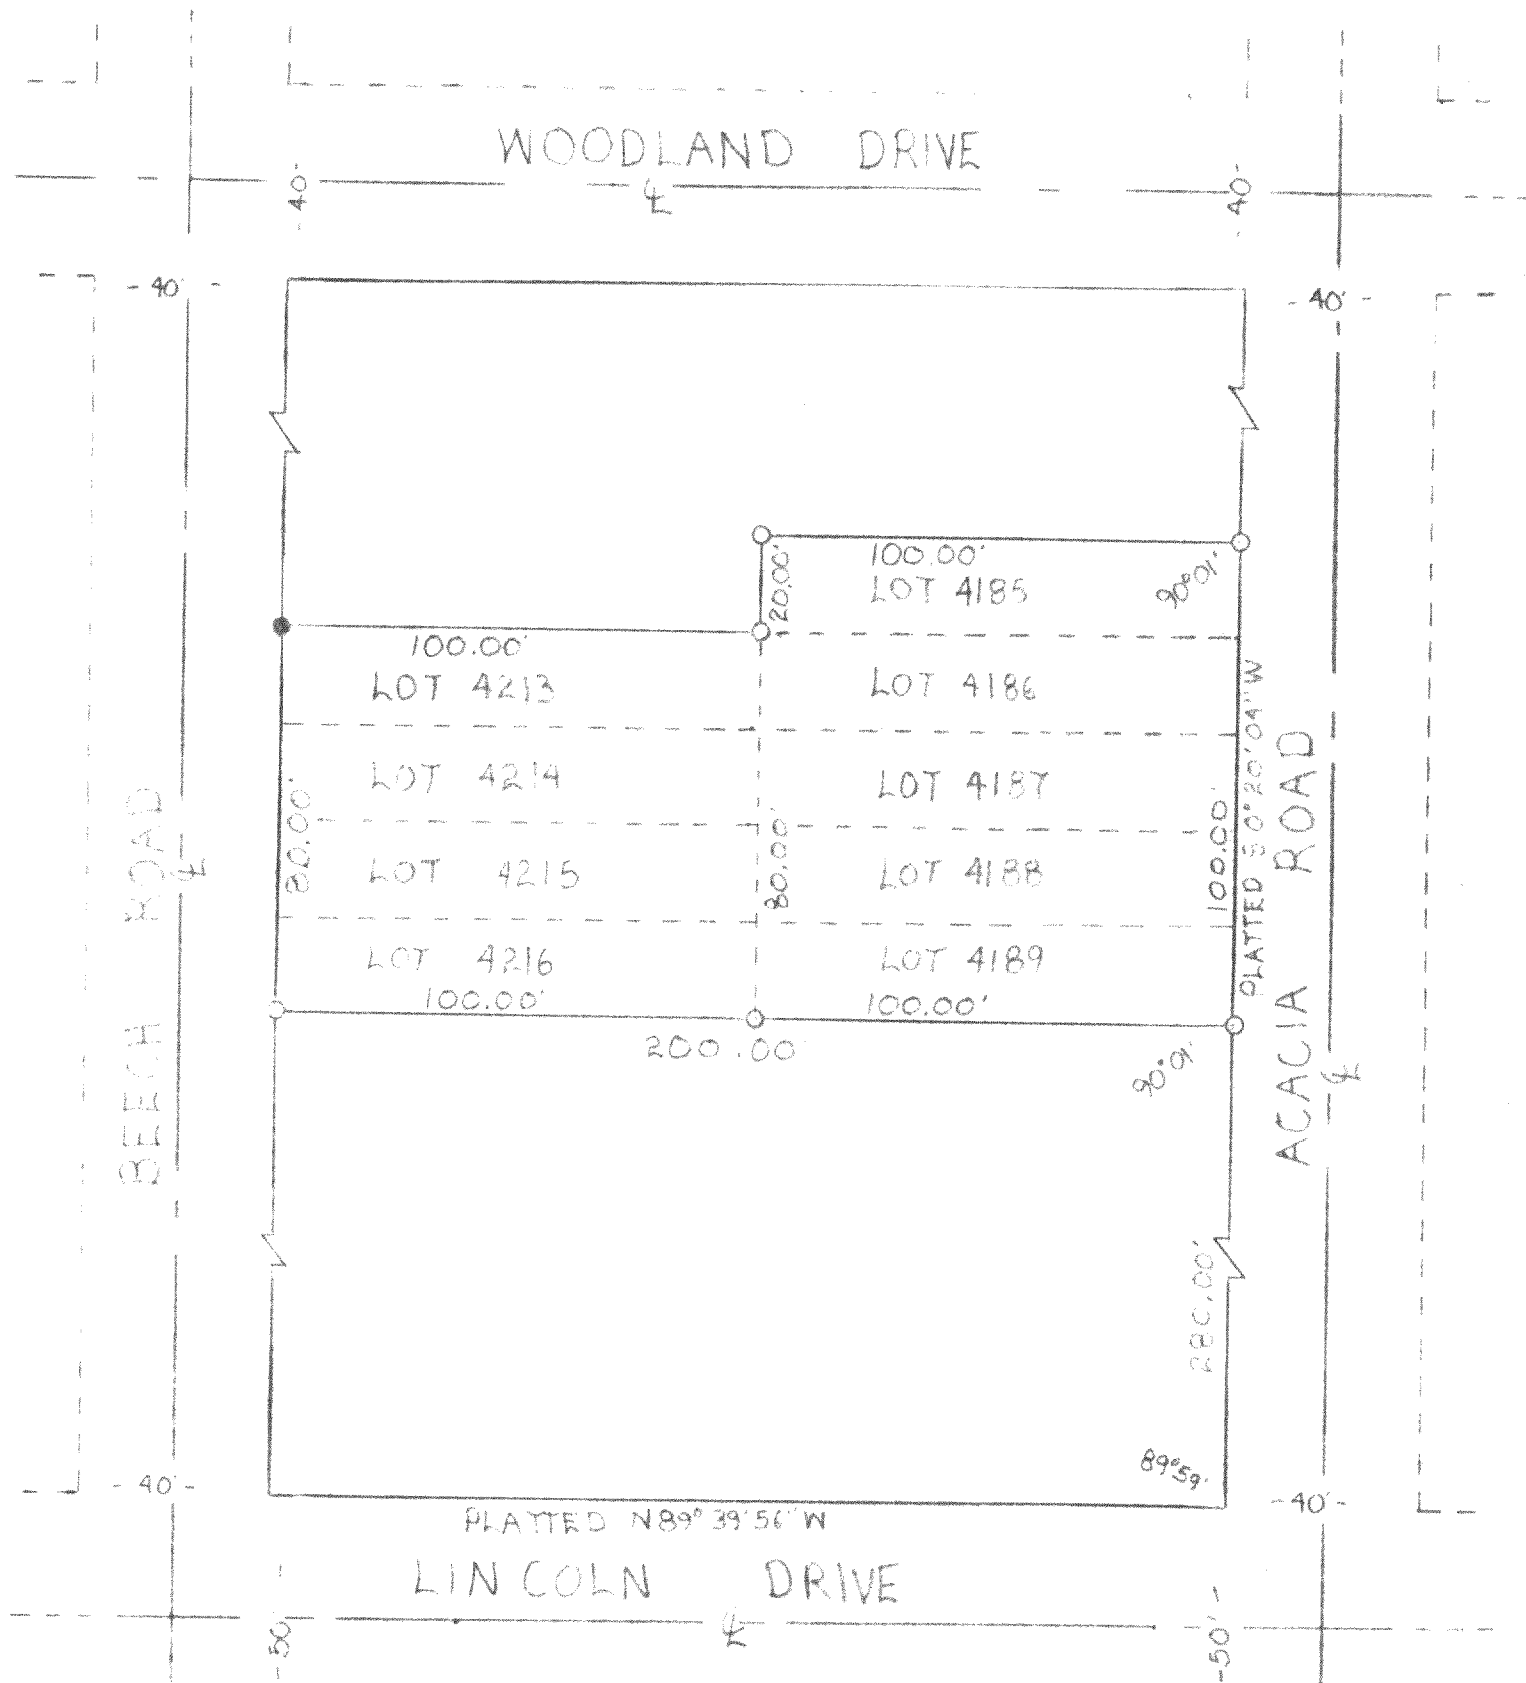

LEGEND

- IRON PIPE FOUND
 - RAILROAD SPIKE SET
- SURVEYED FOR:
MRS. SCAVELLI
RT. 2
LAKE GENEVA
53147

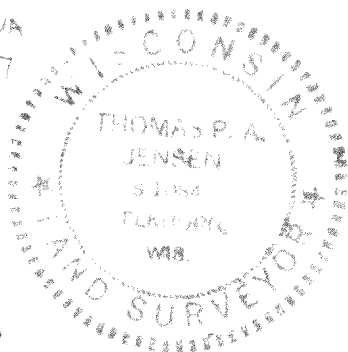

SCALE 1"=40'



I CERTIFY THAT I HAVE SURVEYED THE
DESCRIBED PROPERTY AND THAT THE PLAT
SHOWN HEREON IS AN ACCURATE SURVEY &
A TRUE REPRESENTATION THEREOF & CORRECTLY
SHOWS THE BOUNDARY LINES OF SAID
PROPERTY.

OCT. 31, 1979

Thomas P. A. Jensen

THOMAS P. A. JENSEN S 1034
JENSEN SURVEYING & MAPPING
ELKHORN, WISCONSIN