

FARRIS, HANSEN & COOPER, INC.


ENGINEERING, SURVEYING AND LAND PLANNING
715 W. WALWORTH ST. - P.O. BOX 487 - ELKHORN, WI 53121
OFFICE: 414/723-2088

NE COR.
BLOCK
213

NW COR.
BLOCK 206


MAP SCALE
1" = 30'

⊖ = Iron Pipe Found
⊙ = Iron Pipe Placed
x = Concrete Nail Placed
(xxx) = Record Dimension

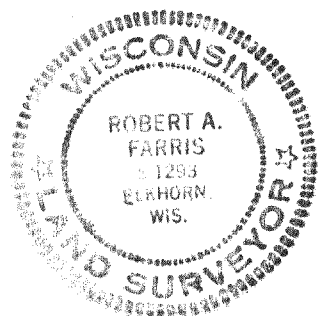

I hereby certify that of the request of Casey Mikrut I have surveyed lots 11671-11679 of Lake Como Beach Sub. in the Town of Geneva, Walworth Co. Wis. for the John Waller Estate and that this Plat of Survey is a true and accurate representation of the lot lines and buildings located on said property to the best of my professional knowledge and belief.

Robert A. Farris
21 AUG. 1981

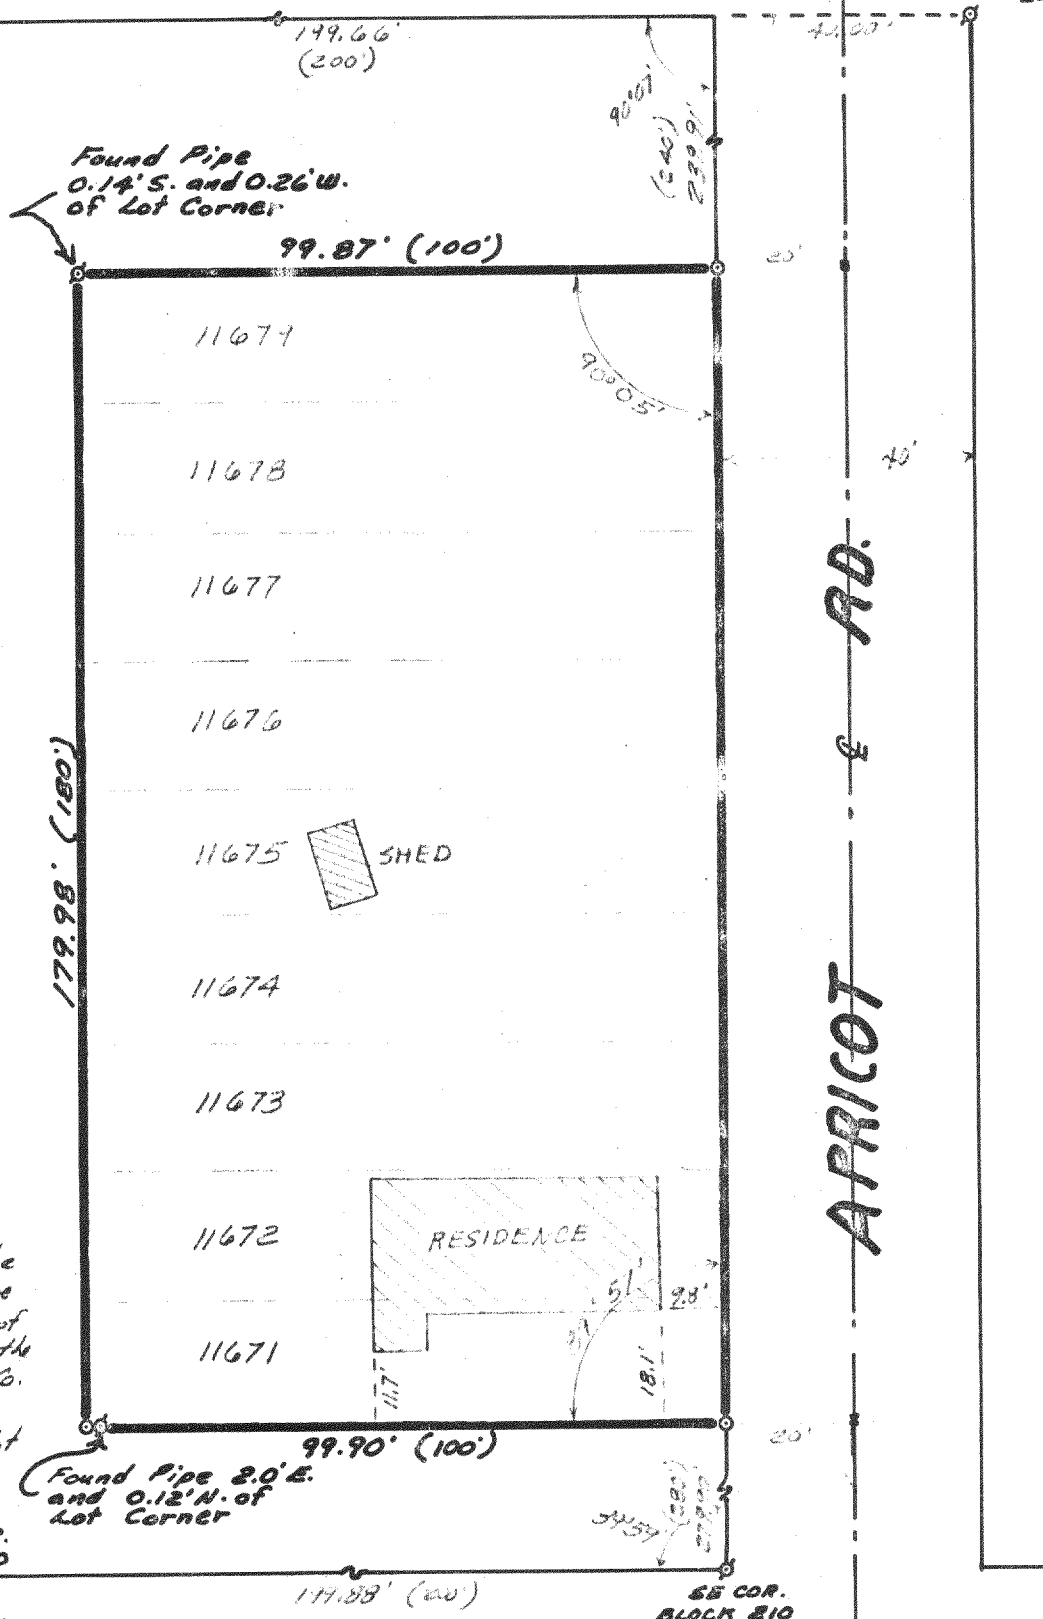

Lots 11671 → 11679 LAKE COMO
BEACH T.2N., R.17E. WAL. CO., WIS.
DRAWING NUMBER 1083