


LAND SURVEYING • SUBDIVIDING • LAND PLANNING

WHITEWATER, WISCONSIN 53190

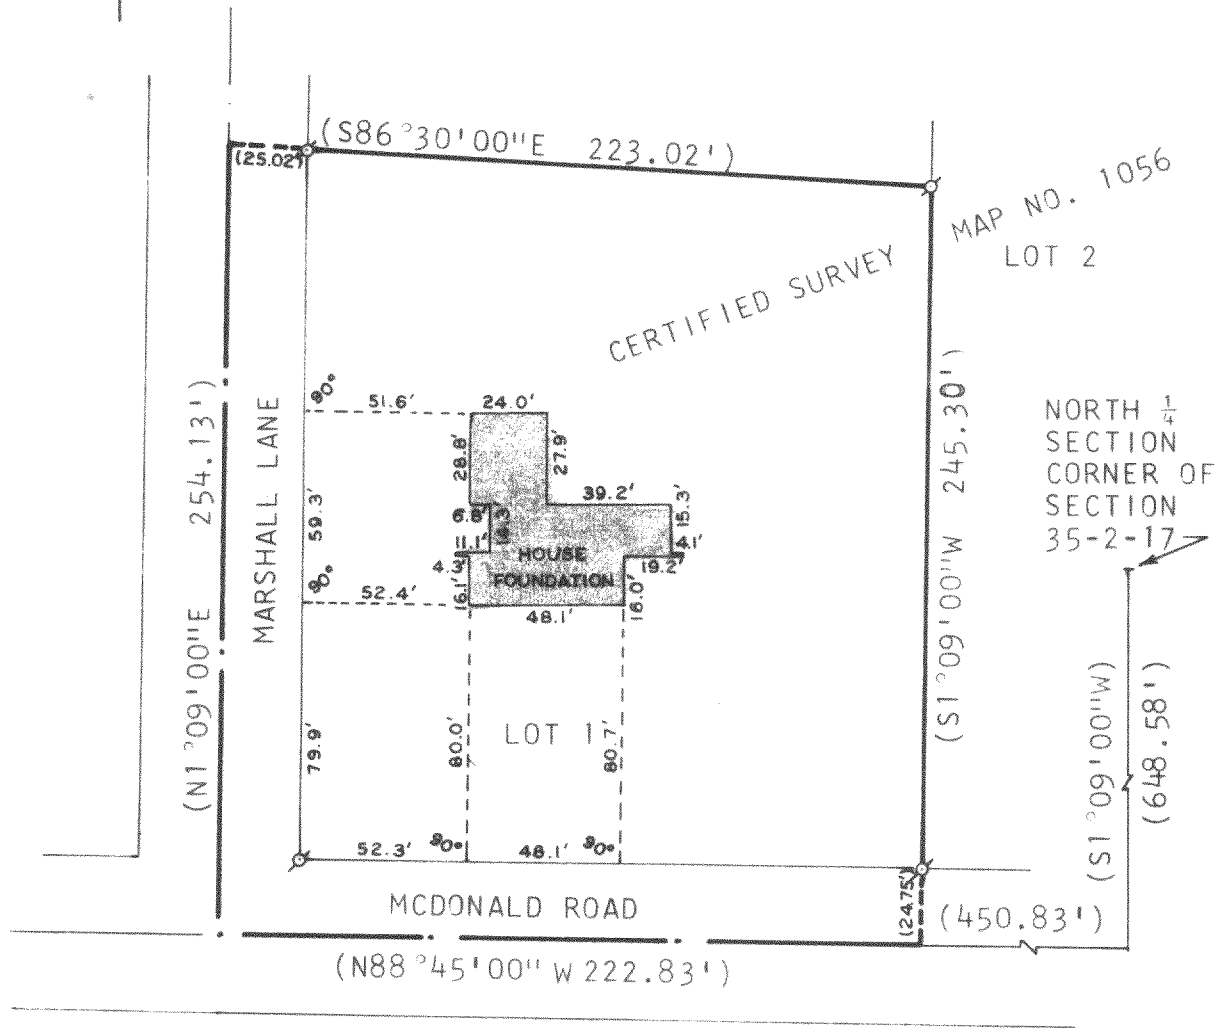

## PLAT OF SURVEY OF

A HOUSE FOUNDATION LOCATED ON LOT 1  
OF CERTIFIED SURVEY MAP NO. 1056,  
LOCATED IN THE NORTHEAST 1/4 OF THE  
NORTHWEST 1/4 OF SECTION 35, TOWN 2  
NORTH, RANGE 17 EAST, WALWORTH  
COUNTY, WISCONSIN.

OWNER: LARRY W. & CHARLENE F. ROCHE  
612 SAGE STREET  
LAKE GENEVA, WI 53147



SCALE: 1"=60'

### LEGEND

Ø - IRON PIPE FOUND  
( ) - RECORDED AS

I, HAROLD H. KOLB, DO HEREBY CERTIFY THAT I HAVE SURVEYED THE PROPERTY HEREON DESCRIBED ACCORDING TO THE OFFICIAL RECORDS, AND THAT THE PLAT HEREON IS A CORRECT REPRESENTATION OF THE LOT LINES TO THE BEST OF MY KNOWLEDGE AND BELIEF.

*Harold H. Kolb*  
HAROLD H. KOLB  
WISCONSIN REGISTERED LAND SURVEYOR, S-187  
DATE *Oct. 13, 1980*