


FARRIS, HANSEN & COOPER, INC.

ENGINEERING, SURVEYING AND LAND PLANNING
715 W. WALWORTH ST. - P.O. BOX 487 - ELKHORN, WI 53121
OFFICE: 414/723-2098

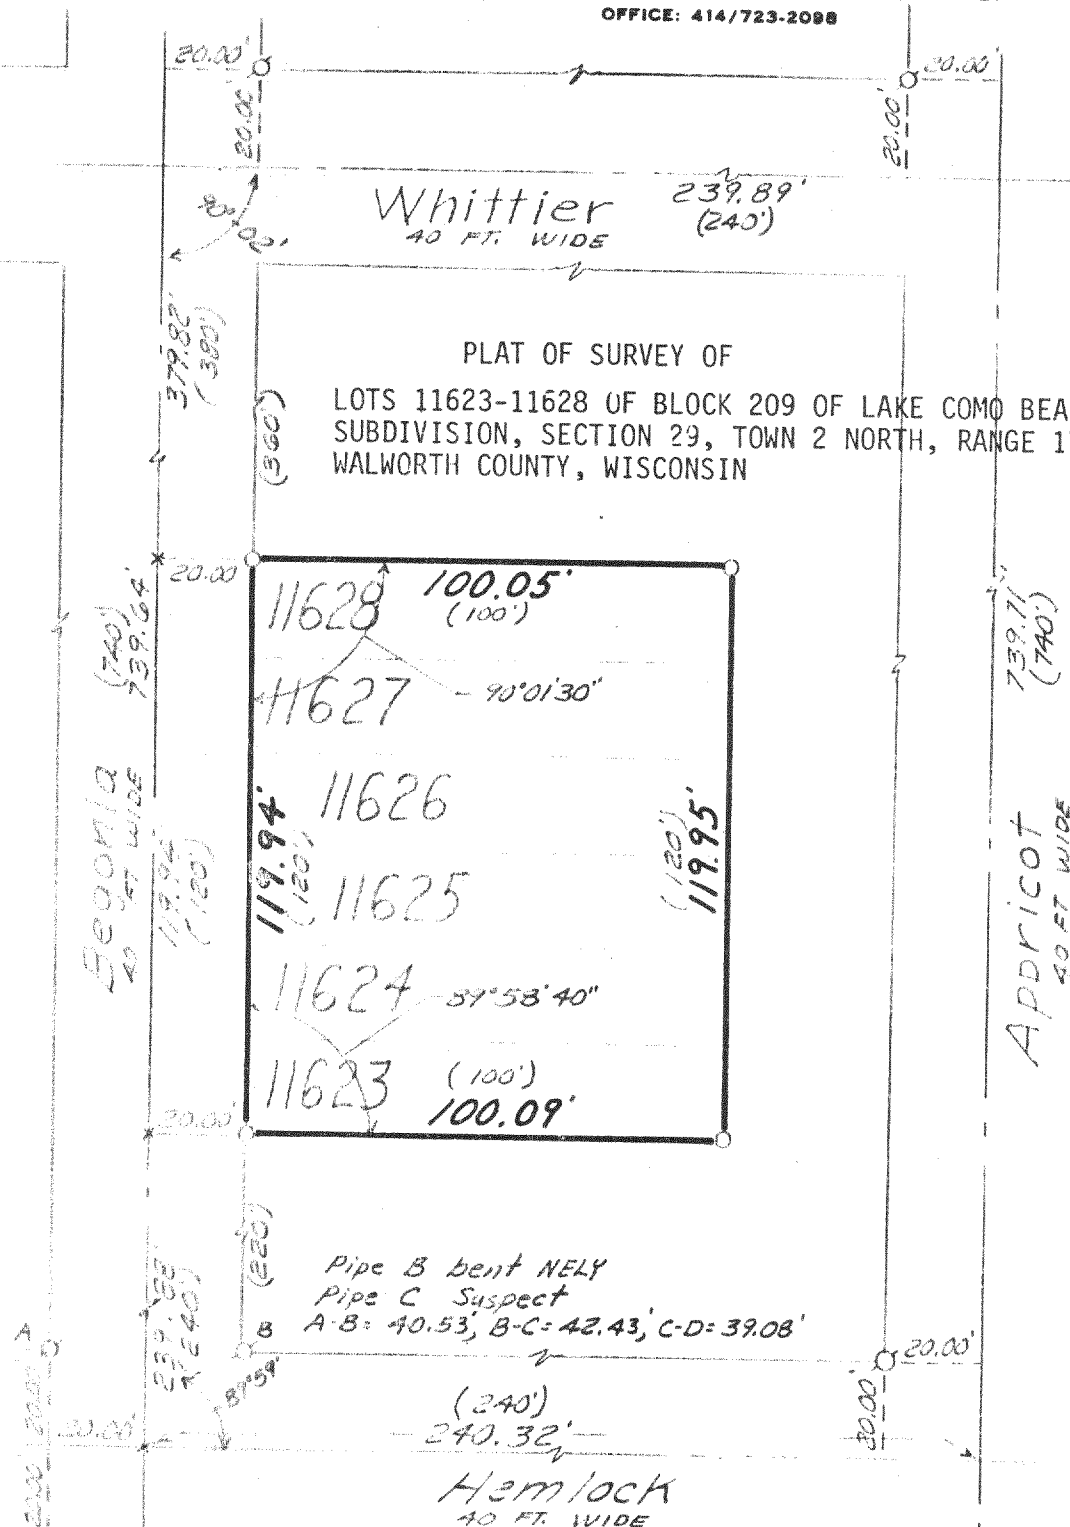

GRAPHIC SCALE
1"=40'

Ø = Iron Pipe Found
O = Iron Pipe Set
(xxx) = Record Dimension
x = Concrete Nail Set

ORDERED BY:
MILITARY REALTY

I hereby certify that I have surveyed the lands described hereon and that this PLAT OF SURVEY is a true and accurate representation of the boundary lines to the best of my professional knowledge and belief.

DATED THIS 1st DAY OF OCTOBER, 1981

Robert A. Farris



DRAWING NUMBER 1895.1

JLB-2529

217-578-F