

PLAT OF SURVEY OF LOTS 12228 TO 12239
INCLUSIVE, BLOCK 218, FIFTH MAP OF LAKE
COMO BEACH, A SUBDIVISION LOCATED IN SECTIONS
21, 22, 28 & 29, T24N R17E, WALDORF COUNTY, WIS.


I CERTIFY THAT I HAVE SURVEYED THE ABOVE DESCRIBED LAND
AND THAT THE PLAT HEREON IS A CORRECT REPRESENTATION OF THE
LOT LINES OF THE SAID PROPERTY TO THE BEST OF MY
KNOWLEDGE AND BELIEF.

APRIL 18, 1983

Thomas P. A. Jensen
THOMAS P. A. JENSEN
JENSEN SURVEYING
&
MAPPING, S.C.
P.O. BOX 322
ELKHORN, WIS.
53121
414-723-3434

ASSUMED FROM PLAT

(N 0° 19' 35" E)
240.00'


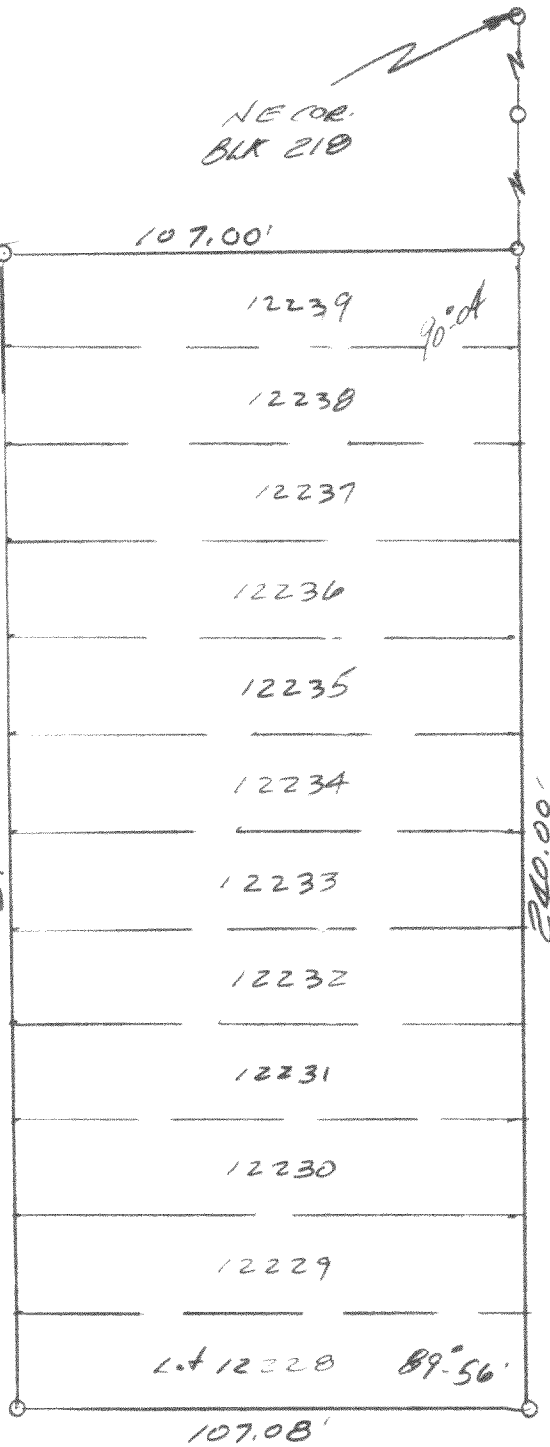


DANDELION ROAD
40' WIDE

SCALE 1" = 40'

SURVEYED FOR: A. SHELDON
LAKE GENEVA, WIS.
() ~ RECORDED AS
O ~ FOUNDIRON PIPE

NOTE: HOUSE IS WELL
WITHIN LOT LINES.

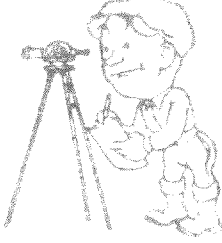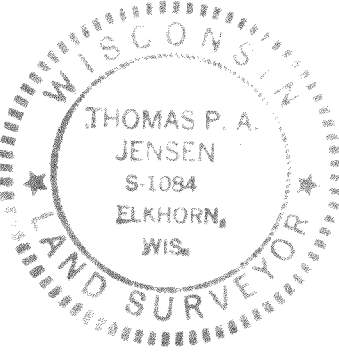

217-578J