


FARRIS, HANSEN & COOPER, INC.

ENGINEERING, SURVEYING AND LAND PLANNING
718 W. WALWORTH ST. - P.O. BOX 487 - ELKHORN, WI 53121
OFFICE: 414/723-2088

217-581F

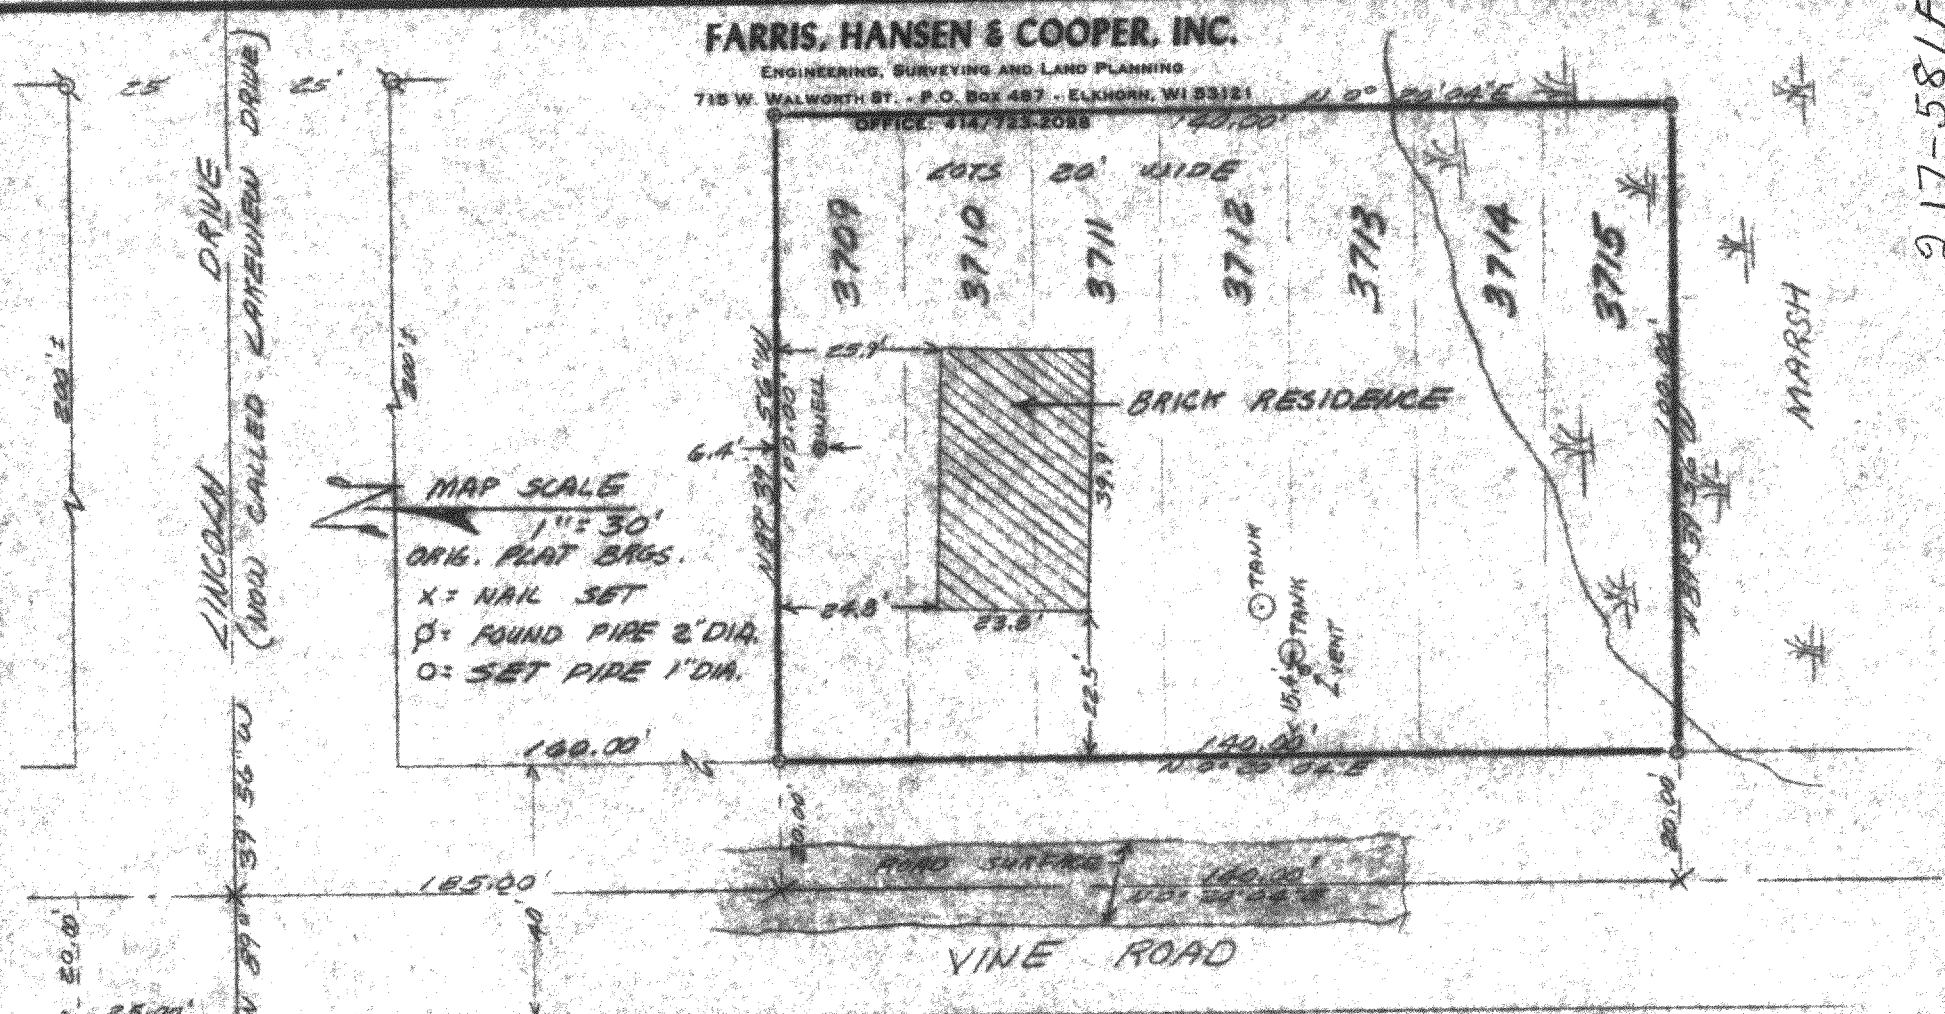


PLAT OF SURVEY OF LOTS 3709-3715, BLOCK 64, LAKE
CORN BEACH SUBDIVISION, TOWN 2 NORTH, RANGE 17 EAST,
WALWORTH COUNTY, WISCONSIN

WORK ORDERED BY: AMANT REALTY
OWNER: JOSEPH LATUSZAK

I HEREBY CERTIFY THAT THIS PLAT IS A TRUE
AND ACCURATE REPRESENTATION OF THE LOT
LINES AND BUILDING LOCATION TO THE BEST
OF MY PROFESSIONAL KNOWLEDGE AND BELIEF.

DATED: 11 JUNE 1982

DRAWING NUMBER 1971

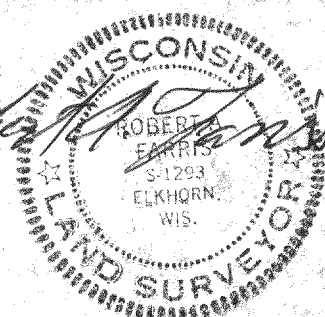

JLCB-699