

- ⊗ FOUND IRON PIPE SET
- SET PIPE
- SET NAIL
- ⊙ FOUND ORIG. TIRE BLOCK CORNER PIPE

FARRIS, HANSEN & COOPER, INC.

ENGINEERING, SURVEYING AND LAND PLANNING
715 W. WALWORTH ST. - P.O. BOX 487 - ELKHORN, WI 53121
OFFICE: 414/723-2098


PLAT OF SURVEY LOTS 10798-10804 & 10820-10823 OF
LAKE MONDO BEACH T.2N. R.17E WALWORTH CO., WIS.

LINCOLN DRIVE
50' WIDE

MAP SCALE
1" = 40'

WORK ORDERED BY: MIKROT REALTY

FOUND BASE OF PIPE 0.26' NW OF COR.

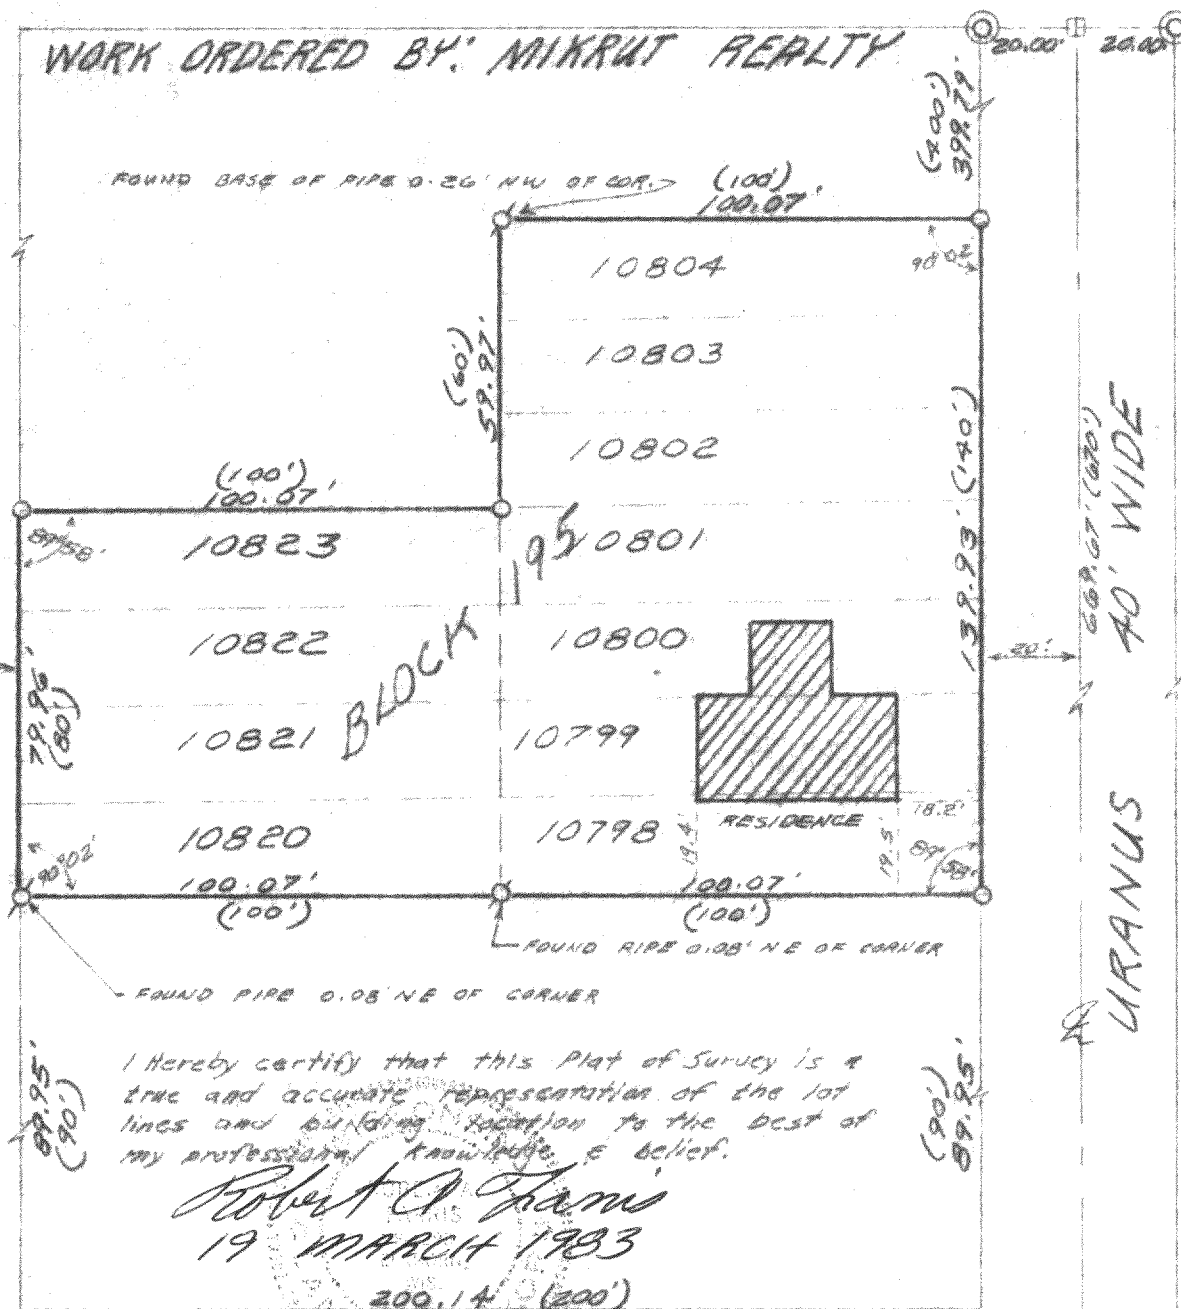

I hereby certify that this Plat of Survey is a true and accurate representation of the lot lines and building location to the best of my professional knowledge & belief.

Robert A. Harris
19 MARCH 1983

200.14' (200')

LONGFELLOW 40' WIDE

DRAWING NUMBER 2062

217-584-K

GLB-2347