



PLAT OF SURVEY OF
LOT 5970 & THE SOUTH 1/2 OF LOT 5975,
BLOCK 105, LAKE COMMO BEACH SUB, T2N,
R1E, WALWORTH CO., WISC.

FARRIS, HANSEN & ASSOC., INC.
P.O. Box 487, ELKHORN, WISC., 53121
(414) 723-2098

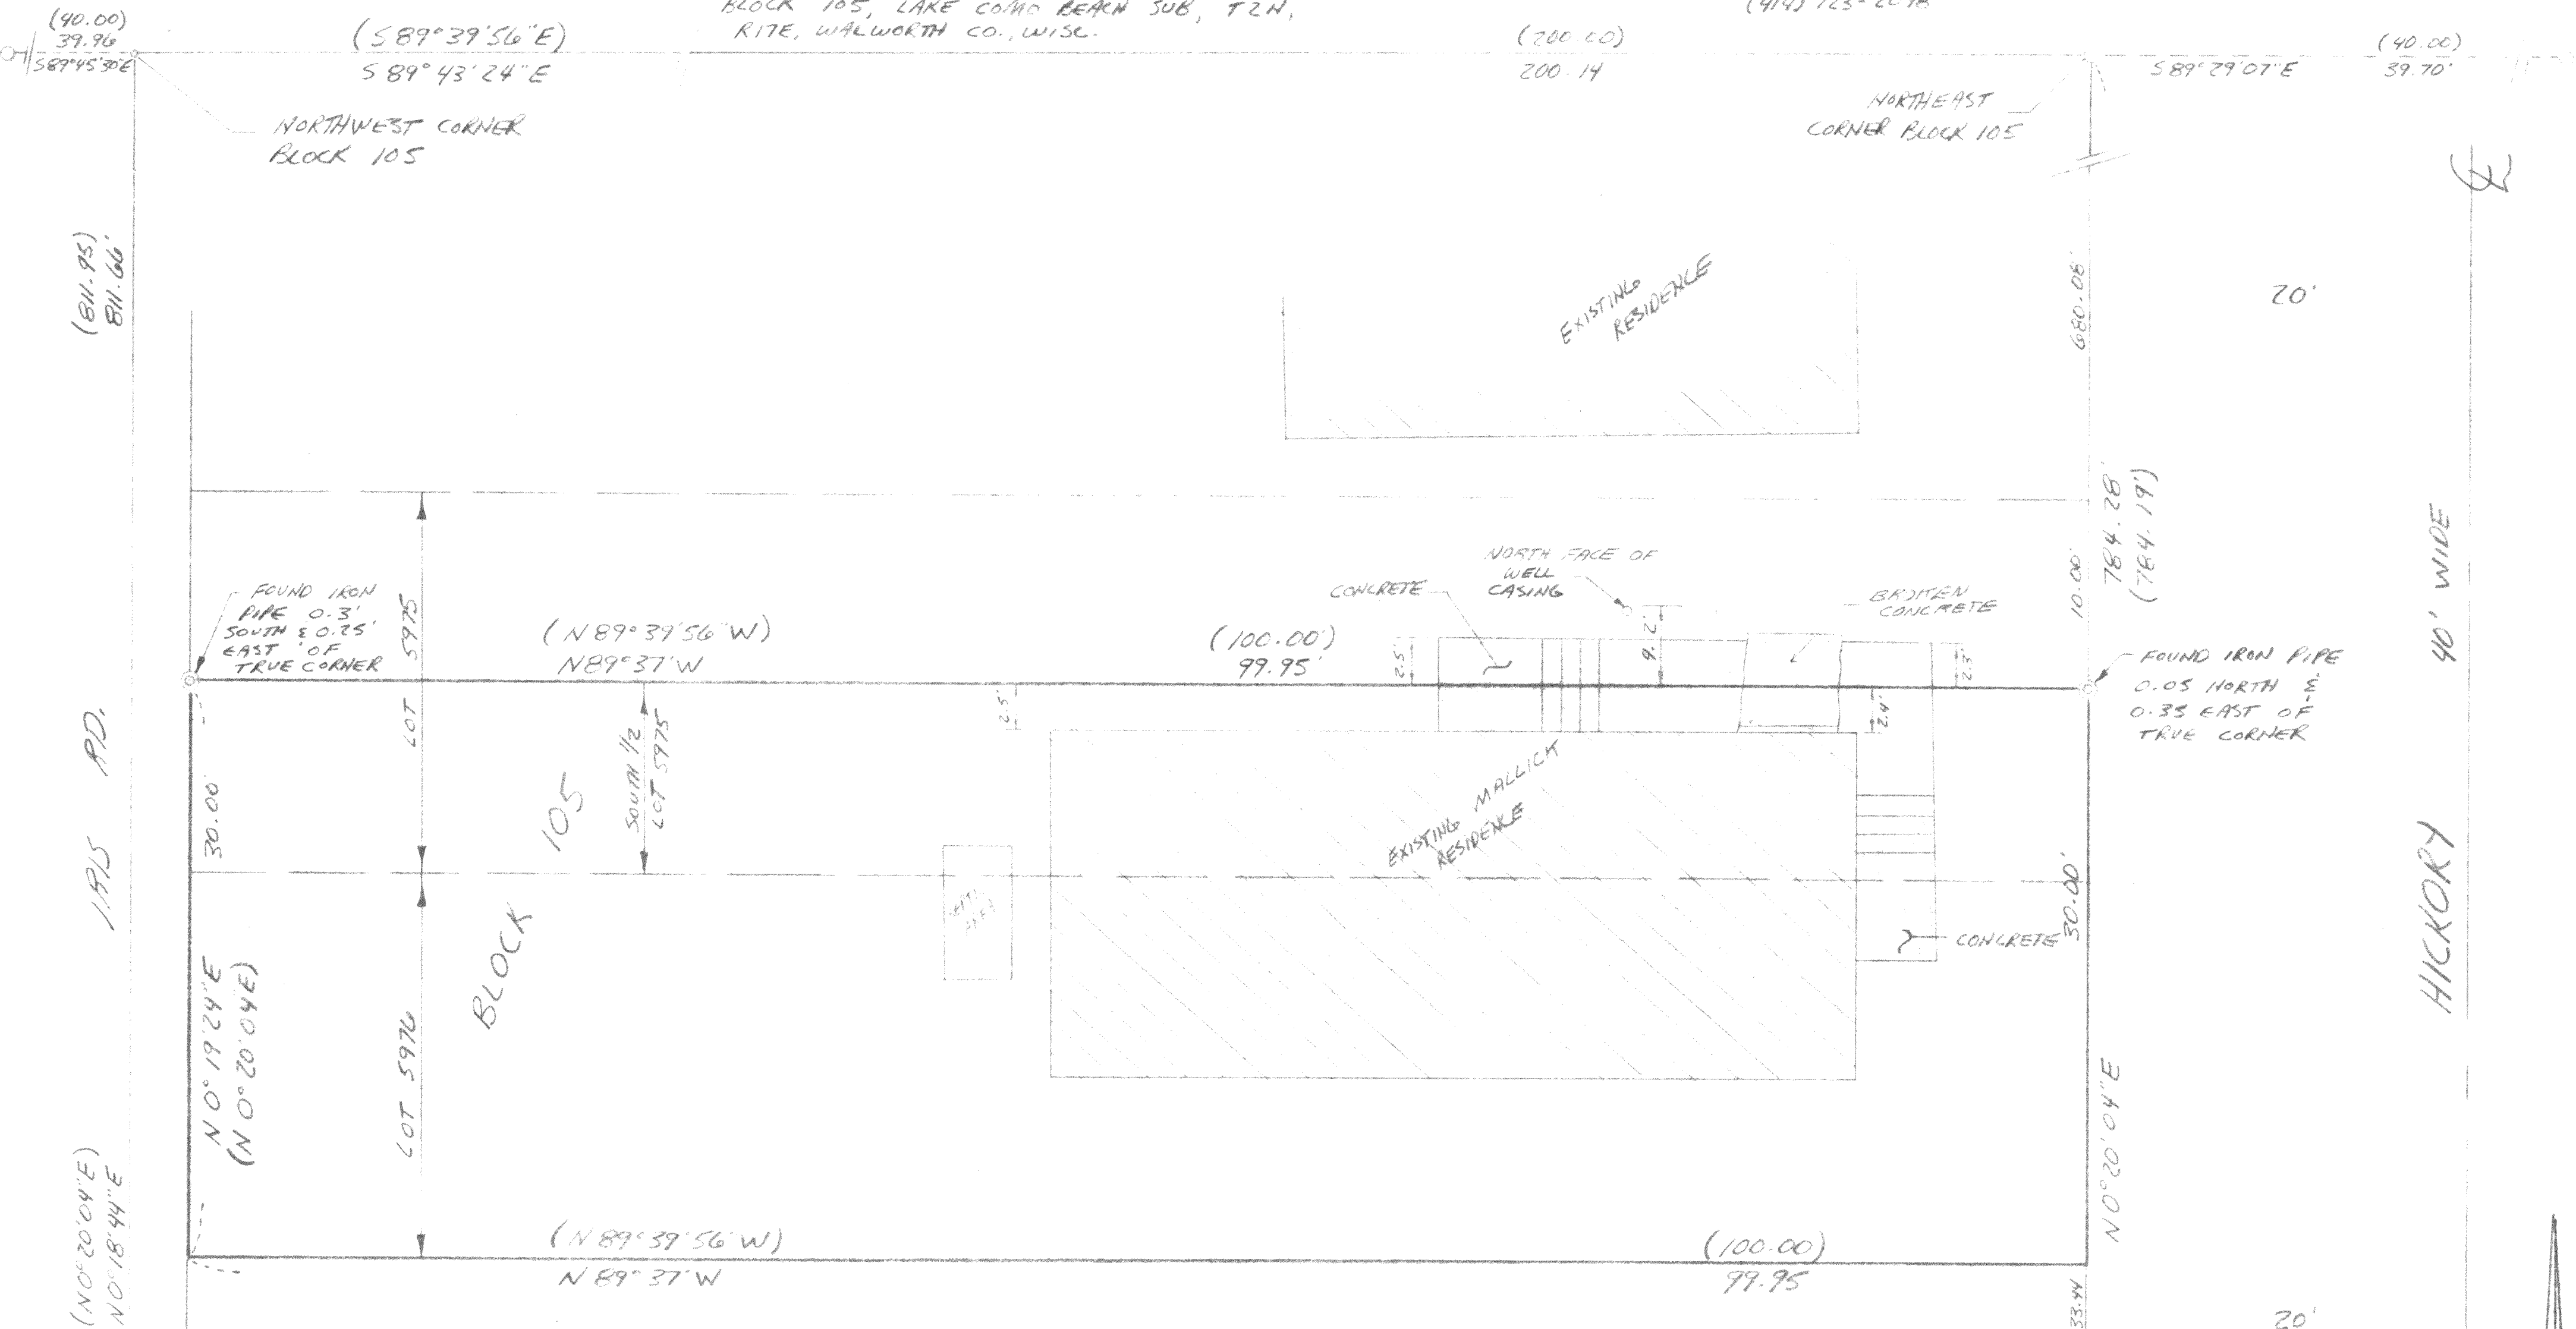

I HEREBY CERTIFY THAT AT THE DIRECTION OF DELORES MALLICH, OWNER, I HAVE SURVEYED THE LAND AND IMPROVEMENTS SHOWN HEREON AND THAT THIS PLAT OF SURVEY IS A TRUE AND ACCURATE REPRESENTATION OF THE LOT LINES, BUILDINGS, WELL, AND CONCRETE STEPS & WALK SHOWN TO THE BEST OF MY PROFESSIONAL KNOWLEDGE & BELIEF.

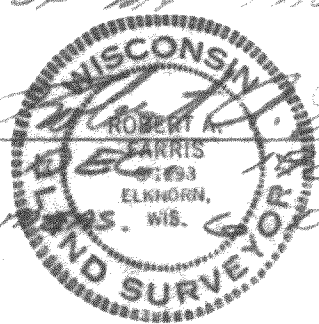

FIELD BOOK NO. 10193, DEC. 1982

SOUTHEAST CORNER BLOCK 105
VOL 5, P. 436 WCSR
JUL 1999

(201.86)
201.72'
N 82° 29' 19" E
(N 82° 32' E)

LATE SHORE DR.

NOTE: ALL DIMENSIONS ARE TO TRUE CORNERS

NOTE: THE EAST LINE OF BLOCK 105 IS ASSUMED TO BEAR N 0° 20' 04" E AS ORIGINALLY RECORDED

LEGEND

- FOUND ORIGINAL BLOCK CORNER 1 3/4" IRON PIPE
- FOUND 1" IRON PIPE SET BY LLS IN 1999 VOL 5, P. 436 WCSR
- FOUND 1" IRON PIPE
- FOUND 1 1/4" IRON PIPE SET BY HHK 1981
- FOUND 1 1/4" IRON PIPE SET BY HHK 217-578-K WCSR
- () - RECORD DIMENSION

NORTH
SCALE: 1" = 60'