


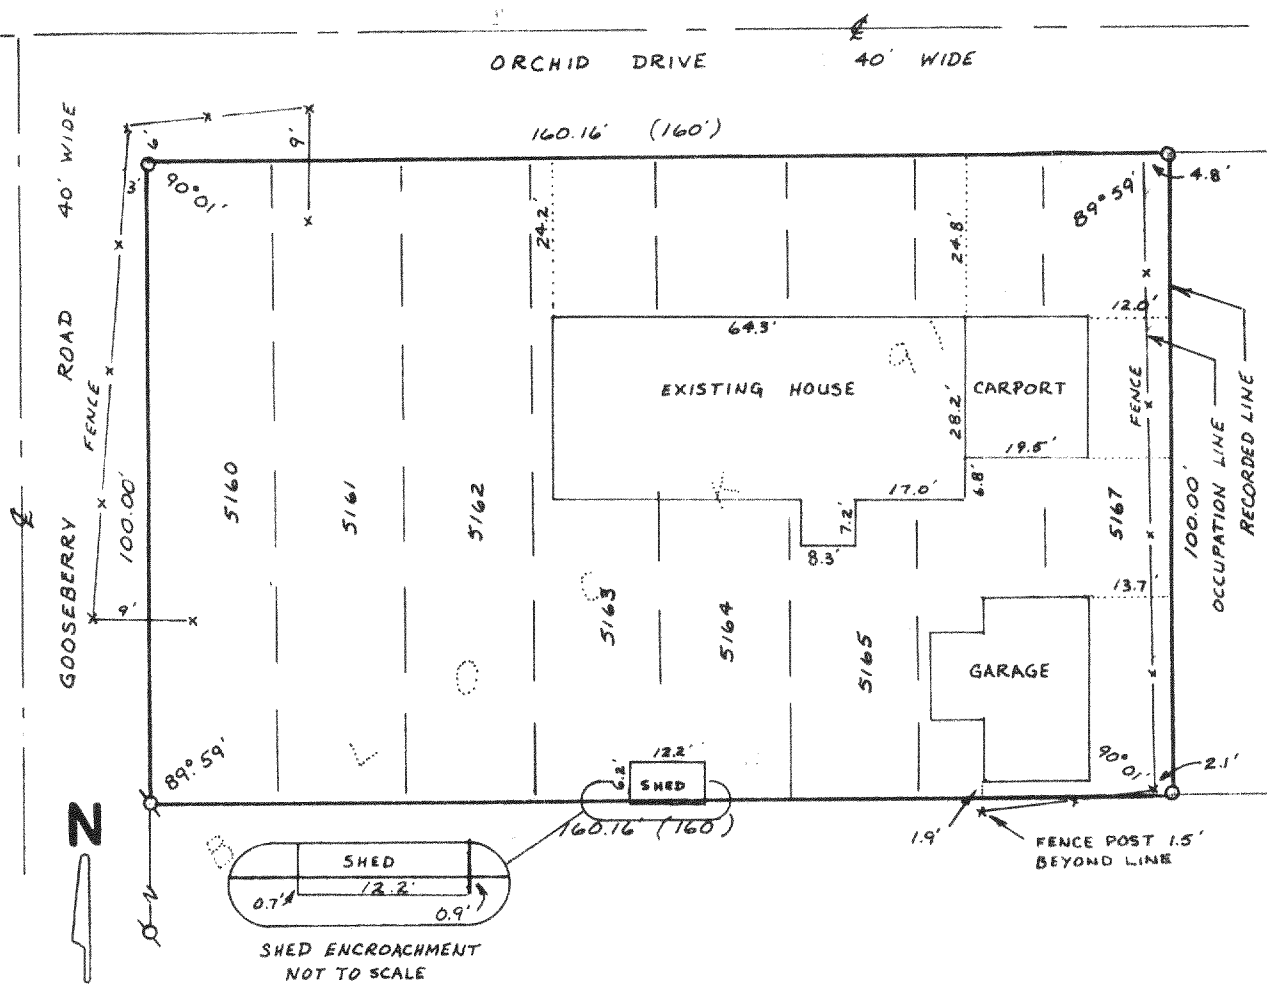


SCALE: 1"=30'

PLAT OF SURVEY OF
 LOTS 5160 TO 5167, BLOCK 91, LAKE COMO BEACH
 SUBDIVISION, LOCATED IN SECTION 28, T2N, R17E,
 WALNORTH COUNTY, WISCONSIN.

OWNED BY: HENRY & MARY DECHERT
 48 CAROL ROAD
 ORMOND BEACH, FLA.

LEGEND

- ⌵ - IRON PIPE FOUND
- - IRON PIPE SET
- () - RECORDED AS

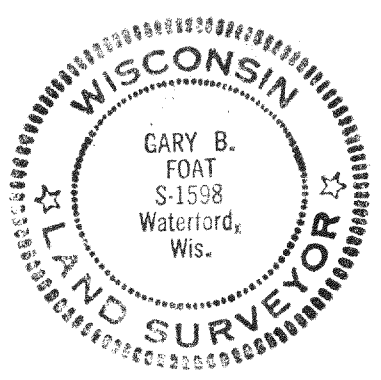

I HEREBY CERTIFY THAT I HAVE SURVEYED THE ABOVE DESCRIBED PROPERTY AND THAT THE ABOVE MAP IS A TRUE REPRESENTATION THEREOF AND SHOWS THE SIZE AND LOCATION OF THE PROPERTY, ITS EXTERIOR BOUNDARIES, THE LOCATION OF ALL VISIBLE STRUCTURES AND DIMENSIONS OF ALL PRINCIPAL BUILDINGS THEREON, BOUNDARY FENCES, APPARENT EASEMENTS, ROADWAYS AND VISIBLE ENCROACHMENTS IF ANY.
 THIS SURVEY IS MADE FOR THE USE OF THE PRESENT OWNERS OF THE PROPERTY, AND ALSO THOSE WHO PURCHASE, MORTGAGE, OR GUARANTEE THE TITLE THERETO WITHIN ONE YEAR FROM DATE HEREOF.

Gary B. Foat
 GARY B. FOAT
 WISCONSIN REGISTERED LAND SURVEYOR, S-1598
 DATE: *May 27, 1983*

JLCB-1040

217-588