


Plat of Survey of Lots 9073, 9074, 9075, 9076,
9077 & 9078 of Block 163 of Lake Como
Beach Subdivision Sec. 21, T.2N, R.17E.
Walworth Co., Wisconsin

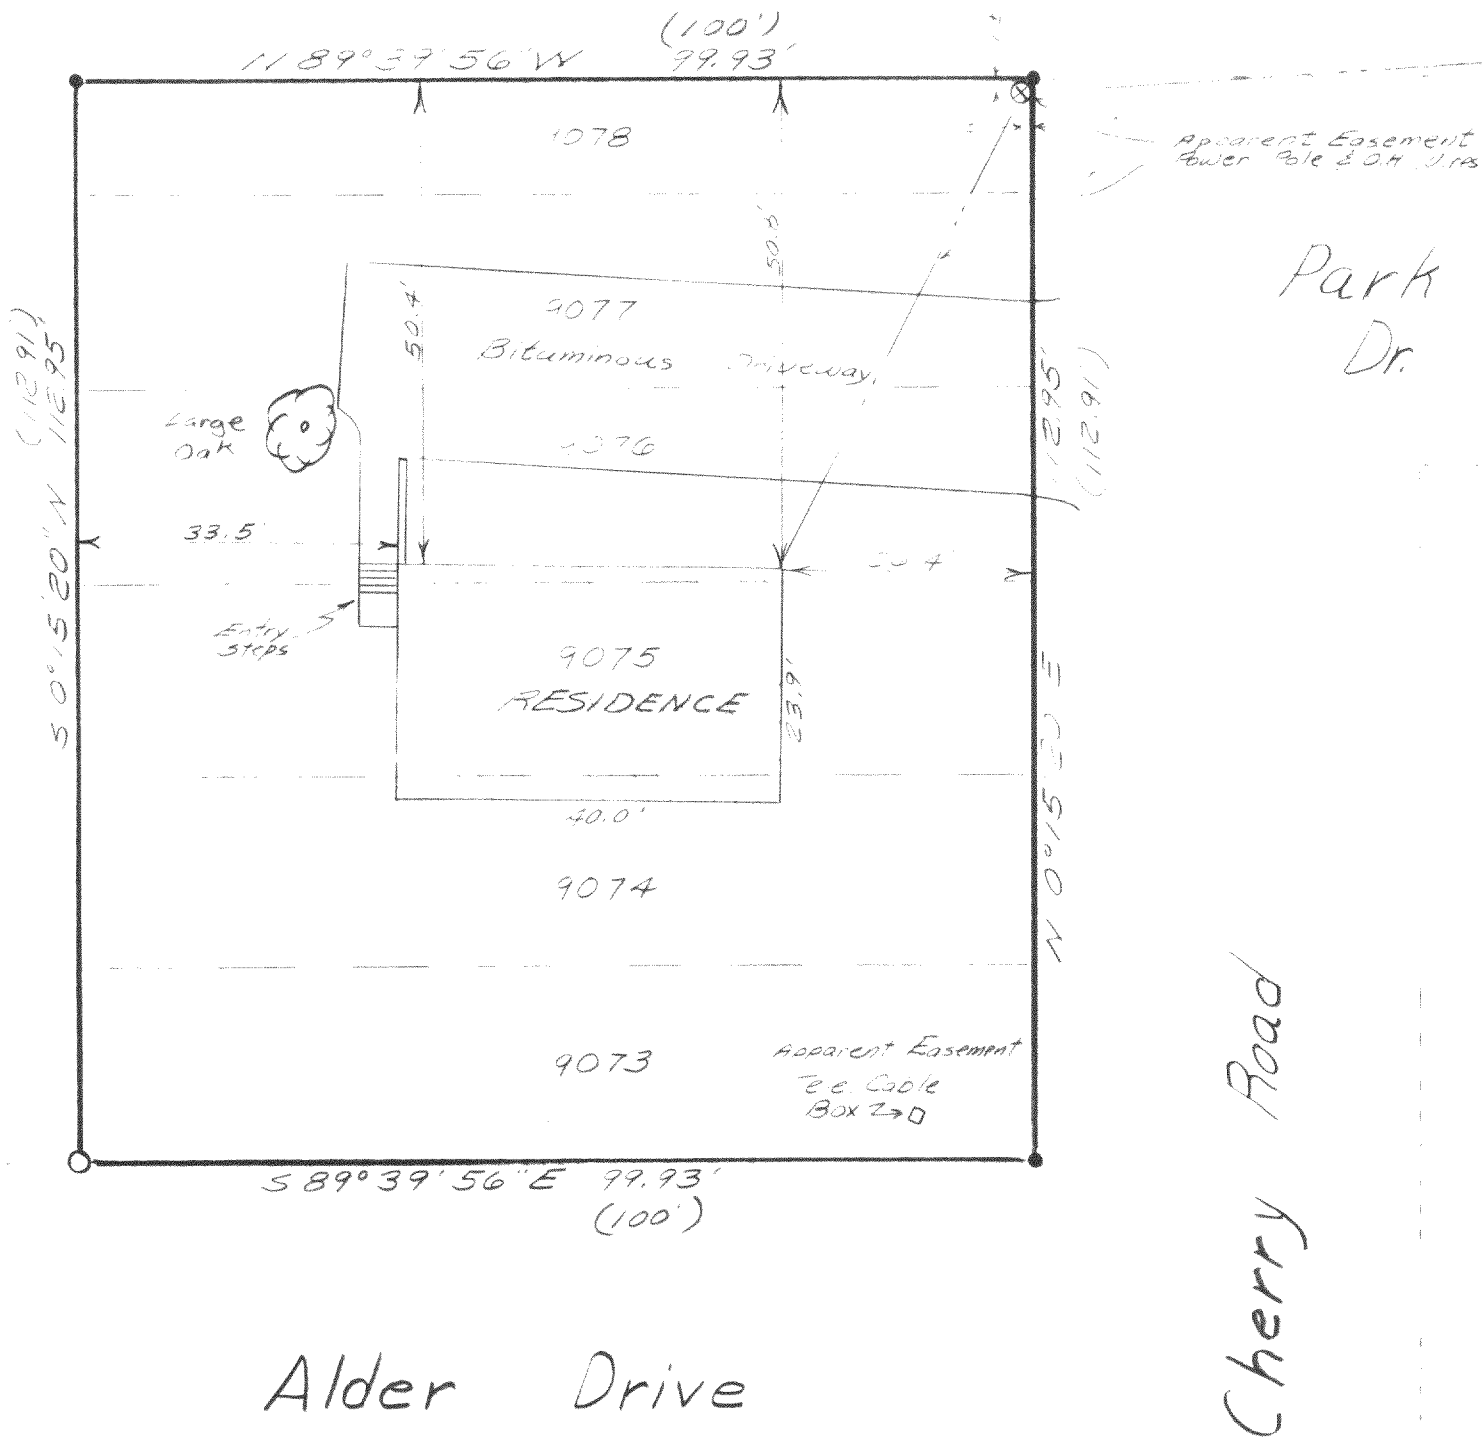


WORK ORDERED BY:
MIKRUT REALTY

- = 3/4" DIA. IRON ROD FOUND
- = 1" X 24" IRON PIPE, SET
- ⊗ = POWER POLE
- (xxx) = RECORD DIMENSION

I hereby certify that I have surveyed the above described property and that the above map is a true representation thereof and shows the size and location of the property, its exterior boundaries, the location of all visible structures and dimensions of all principal buildings thereon, boundary fences, apparent easements, roadways and visible encroachments, if any.

This survey is made for the use of the present owners of the property, and also those who purchase, mortgage, or guarantee the title thereto within one (1) year from date hereof.

Robert A. Farris
ROBERT A. FARRIS S-1293
FARRIS, HANSEN & ASSOCIATES, INC.
715 W. Walworth St. P.O. Box 487
Elkhorn, WI 53121

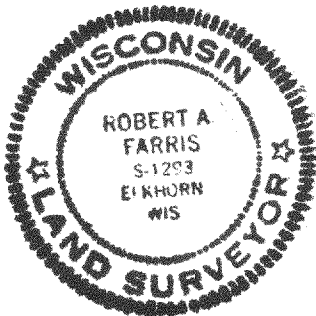

N. LINE 9078 ASSUMED
118°39'56"W AS
ORIGINALLY PLATTED

MAP SCALE
1" = 20'

Proj. # 2236

217-590-1-✓