


KOLB LAND CONSULTING, INC.
LAND SURVEYING • SUBDIVIDING • LAND PLANNING


LAKE GENEVA, WISCONSIN 53147

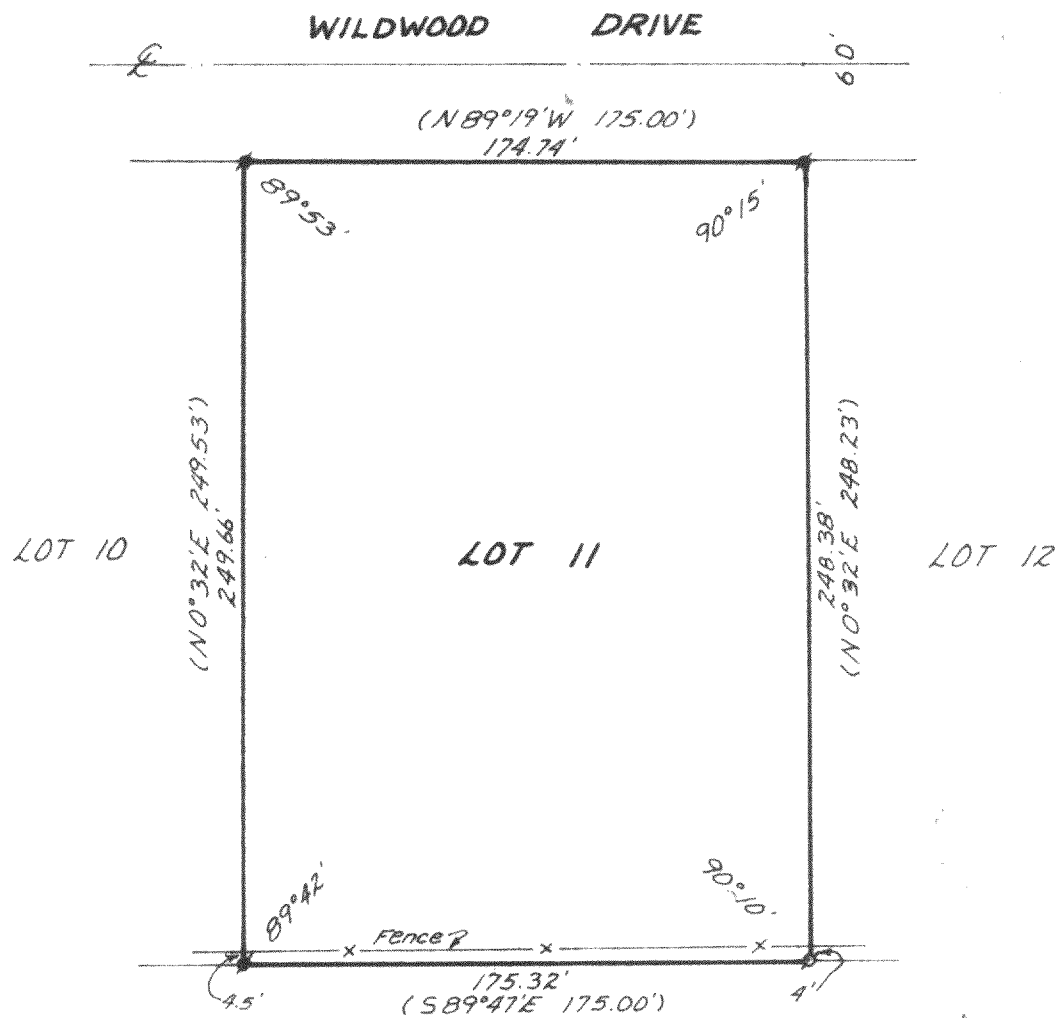

PLAT OF SURVEY OF

LOT 11, WILDWOOD SUBDIVISION LOCATED IN THE
NORTH 1/4 OF SECTION 34, TOWN 2 NORTH, RANGE
17 EAST, WALWORTH COUNTY, WISCONSIN.

ORDERED BY: JOHN YOCK
ROUTE 4, BOX 502 - WILDWOOD DRIVE
LAKE GENEVA, WI 53147

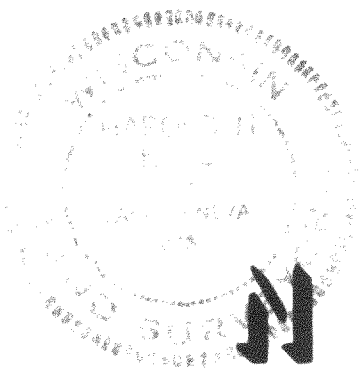

SCALE - 1"=60'

LEGEND

- ⊕ - IRON PIPE FOUND
- - IRON ROD FOUND
- () - RECORDED AS

I, HAROLD H. KOLB, DO HEREBY CERTIFY
THAT I HAVE SURVEYED THE PROPERTY
HEREON DESCRIBED ACCORDING TO THE
OFFICIAL RECORDS, AND THAT THE PLAT
HEREON IS A CORRECT REPRESENTATION
OF THE LOT LINES TO THE BEST OF MY
KNOWLEDGE AND BELIEF.

Harold H. Kolb
HAROLD H. KOLB

WISCONSIN REGISTERED LAND SURVEYOR, S-187

DATE OCTOBER 12, 1984

217-607-K