

Farris, Hansen & Associates, Inc.

Engineering, Surveying & Land Planning

P.O. BOX 487

715 W. WALWORTH STREET
ELKHORN, WISCONSIN 53121

LONGFELLOW



SCALE: 1" = 30'

BEGONIA RD.

FOUND IRON PIPE
STAKE DISTURBED
0.6'S. & 0.4'E OF
COR.


LEGEND

O = FOUND IRON PIPE 1"

Q = FOUND IRON PIPE 2"

(XXX) = RECORDED DIMEN.

WORK ORDERED BY:
MIKROT REALTY

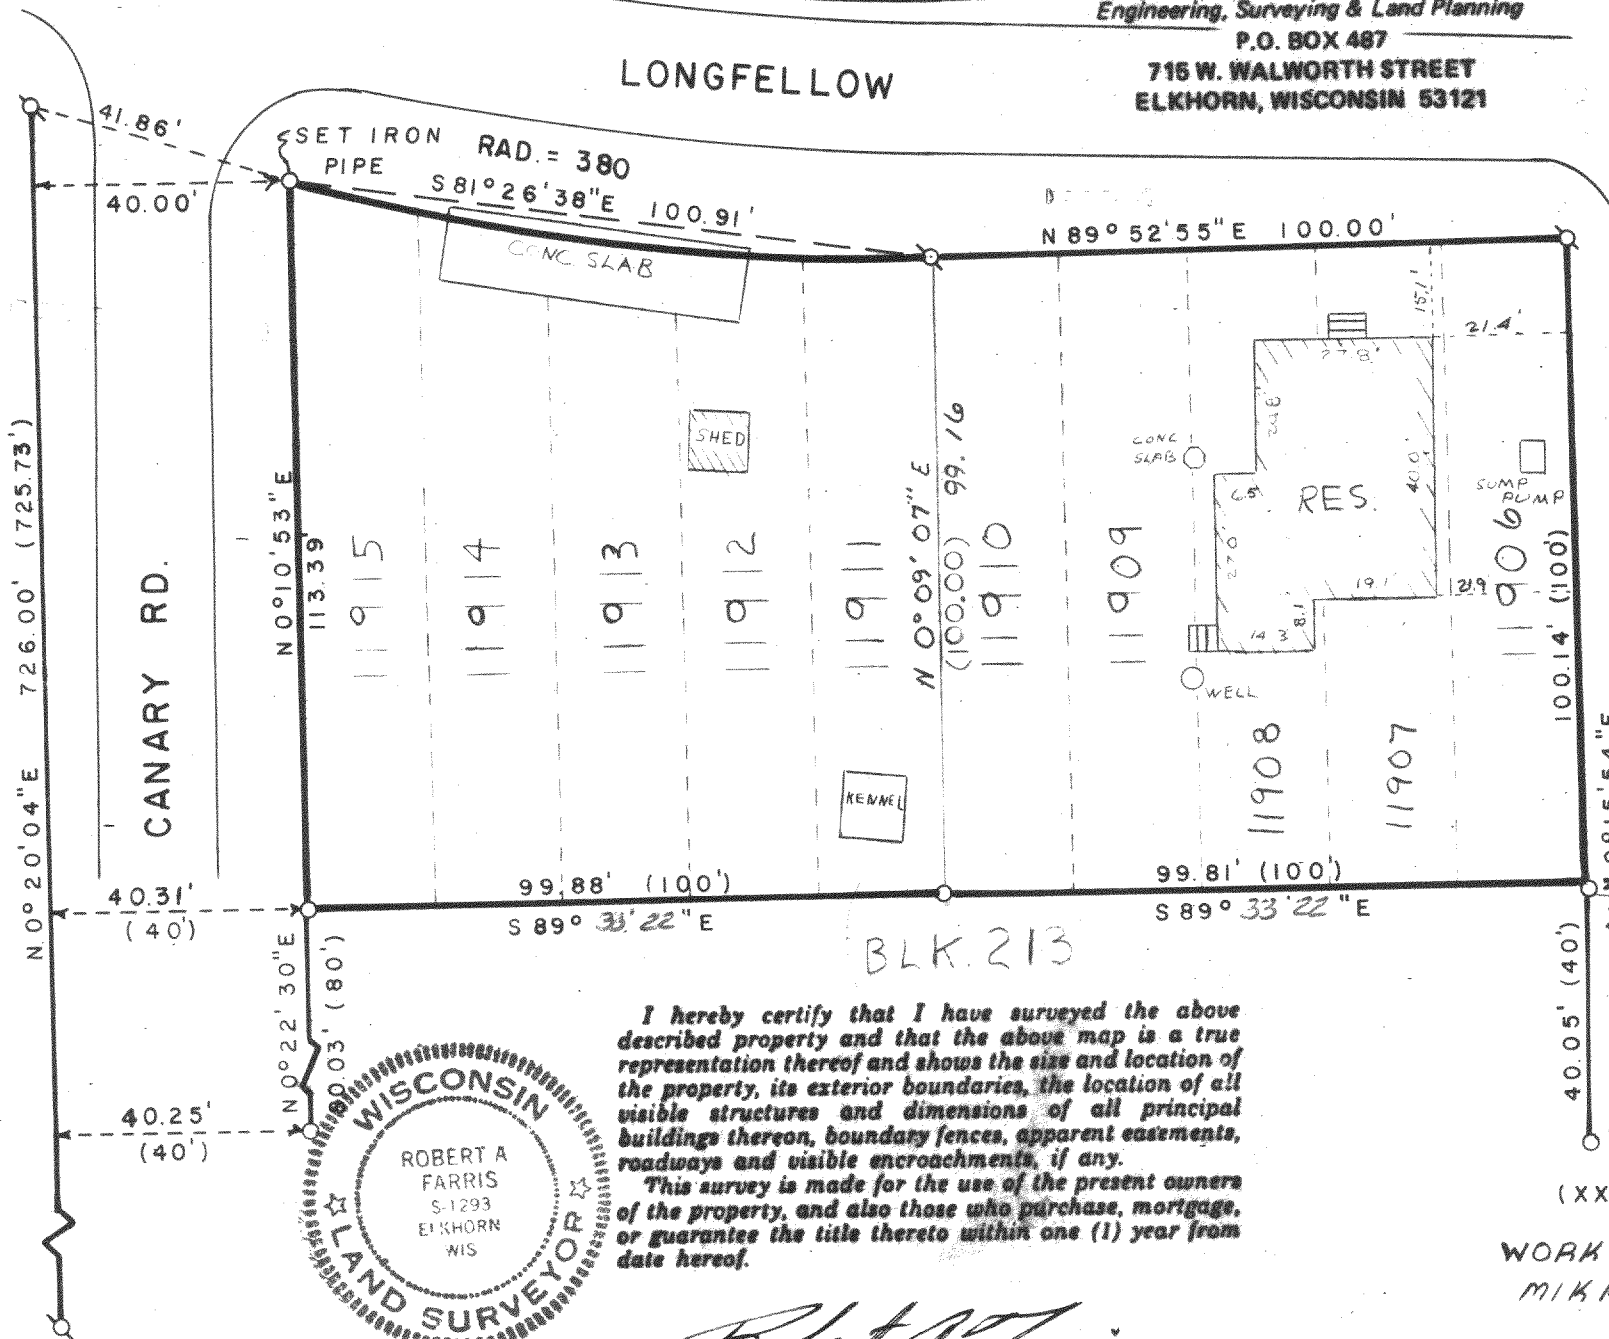


I hereby certify that I have surveyed the above described property and that the above map is a true representation thereof and shows the size and location of the property, its exterior boundaries, the location of all visible structures and dimensions of all principal buildings thereon, boundary fences, apparent easements, roadways and visible encroachments, if any.

This survey is made for the use of the present owners of the property, and also those who purchase, mortgage, or guarantee the title thereto within one (1) year from date hereof.

Robert A. Farris

DATED OCTOBER 15, 1984

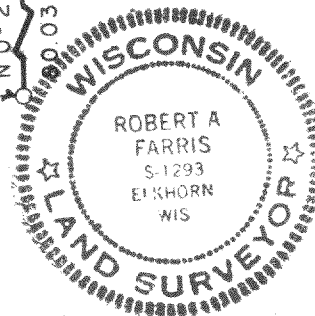

JLB-2591

PROJ. NO. 2321 217-610