
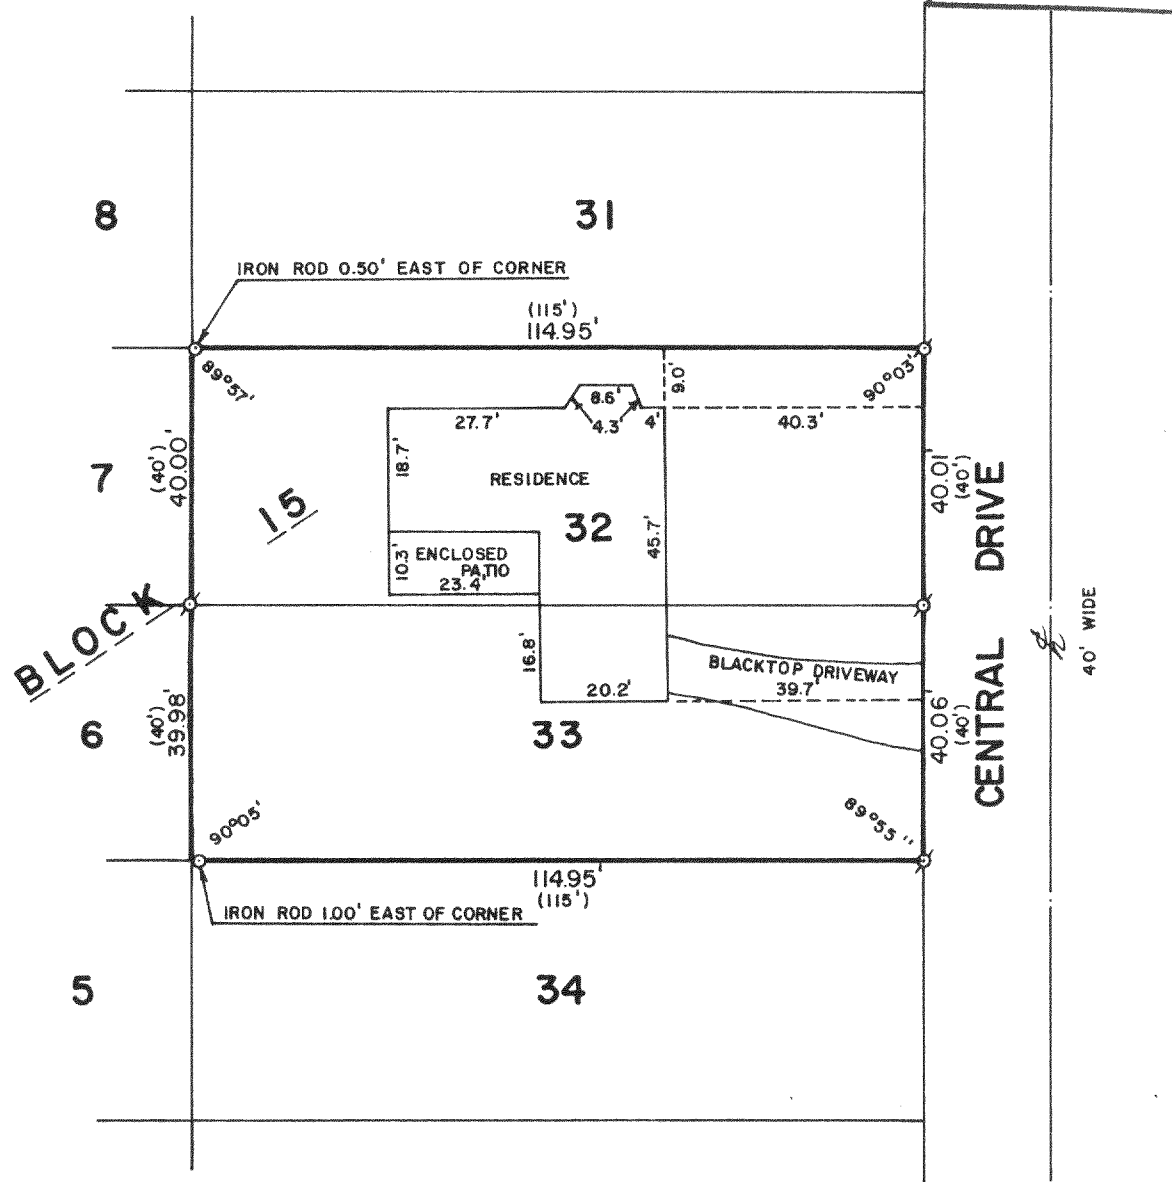


WALWORTH COUNTY
SURVEYING & MAPPING
LAKE GENEVA, WISCONSIN

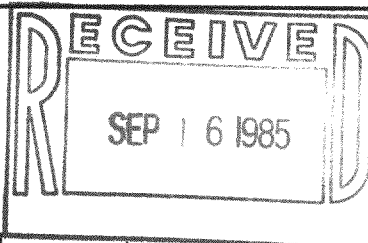

PLAT OF SURVEY OF

LOTS 32 AND 33, BLOCK 15 OF SUNSET
SUBDIVISION "UNIT B", LOCATED IN
T 2 N, R 17 E, WALWORTH COUNTY,
WISCONSIN.

ORDERED BY: JANIE LARSON
RT. 4, BOX 845
LAKE GENEVA, WISCONSIN
53147



I, ROBERT M. BAERENWALD, DO HEREBY CERTIFY THAT I
HAVE SURVEYED THE PROPERTY HEREON DESCRIBED ACCORDING
TO THE OFFICIAL RECORDS AND THAT THE PLAT HEREON IS A
CORRECT REPRESENTATION OF THE PROPERTY LINES TO THE
BEST OF MY KNOWLEDGE AND BELIEF.

Robert M. Baerenwald
ROBERT M. BAERENWALD
WISCONSIN REGISTERED LAND SURVEYOR, S-1508

Aug. 29, 1985
DATE JOB NO. 0362

SCALE: 1"=30'

o-IRON PIPE FOUND
o-IRON ROD PLACED
()-RECORDED AS

JSH-00048

217-615B