


WALWORTH COUNTY  
SURVEYING & MAPPING  
LAKE GENEVA, WISCONSIN

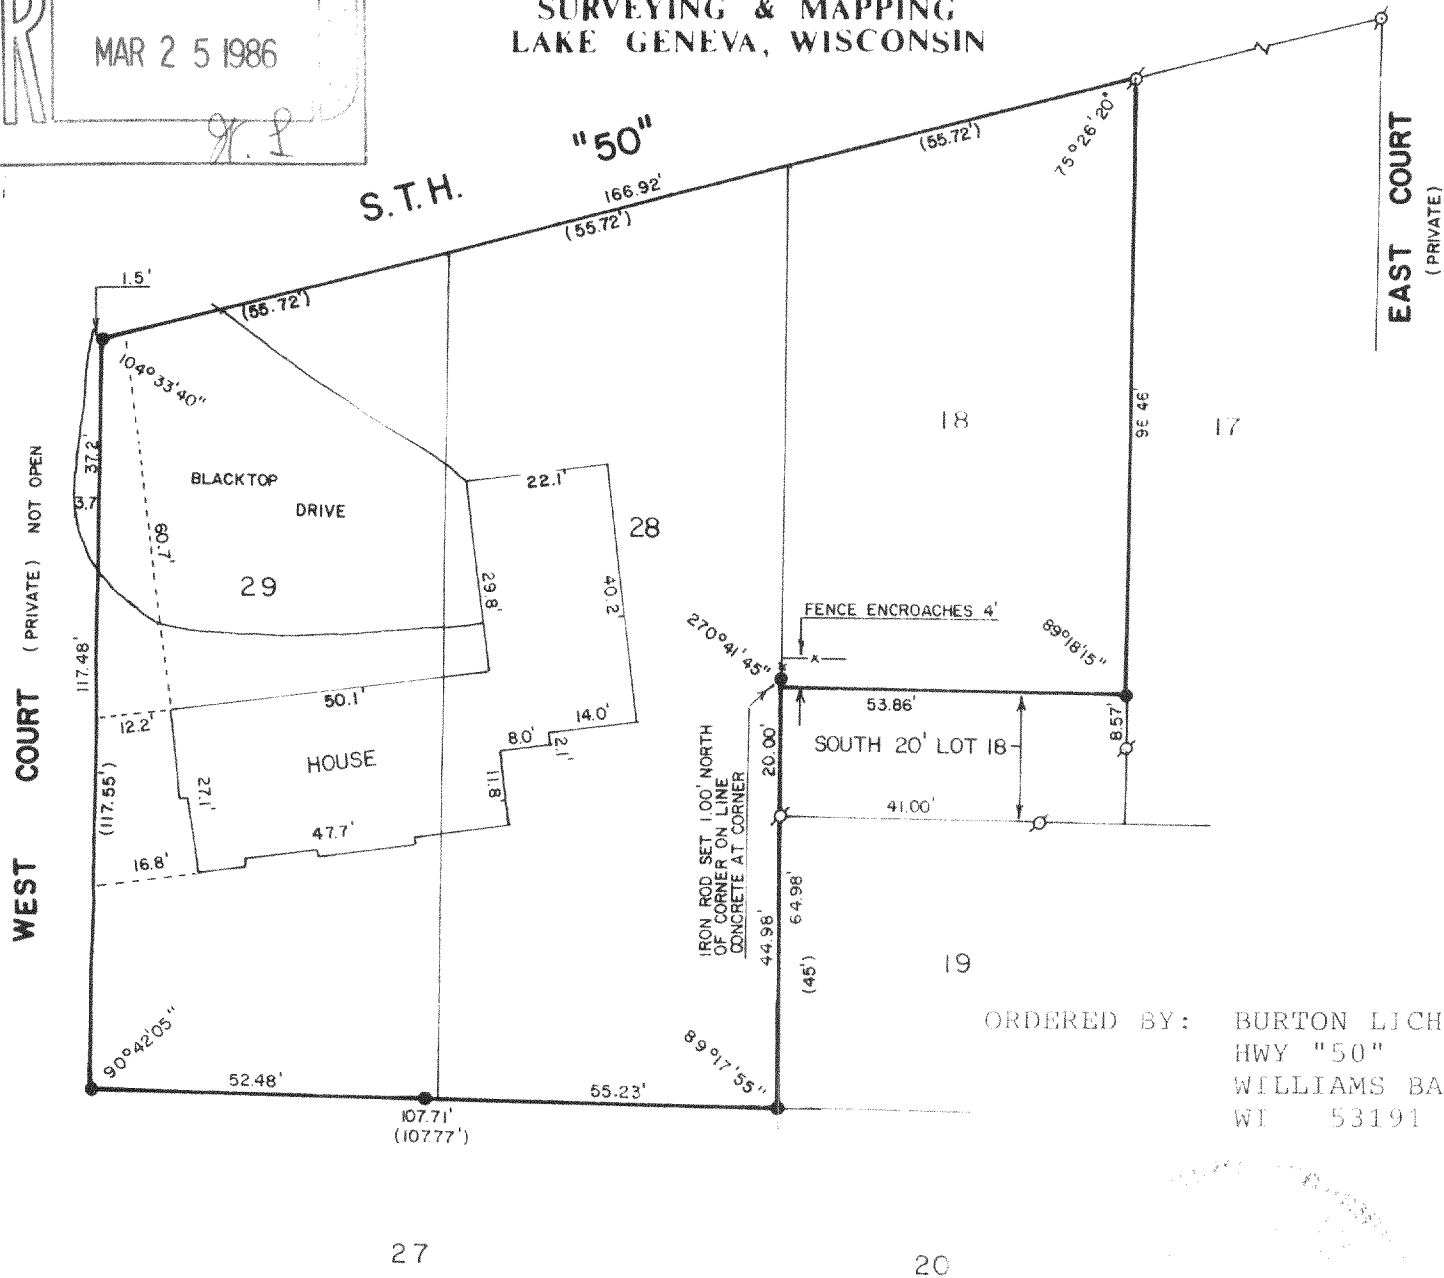

ORDERED BY: BURTON LICHTIG  
HWY "50"  
WILLIAMS BAY,  
WI 53191

PLAT OF SURVEY OF

LOTS 28, 29 AND LOT 18 EXCEPT THE SOUTH 20  
FEET, LAKE GENEVA KNOLLS SUBDIVISION, TOWN 2  
NORTH, RANGE 17 EAST, WALWORTH COUNTY, WISCONSIN.



SCALE - 1"=30'

LEGEND

- ⊗ - IRON PIPE FOUND
- - IRON ROD SET
- ( ) - RECORDED AS

I, DAVID F. ABELL, DO HEREBY CERTIFY  
THAT I HAVE SURVEYED THE PROPERTY  
HEREON DESCRIBED ACCORDING TO THE  
OFFICIAL RECORDS, AND THAT THE PLAT  
HEREON IS A CORRECT REPRESENTATION  
OF THE PROPERTY LINES TO THE BEST  
OF MY KNOWLEDGE AND BELIEF.

*David F. Abell*

DAVID F. ABELL  
WISCONSIN REGISTERED LAND SURVEYOR, S-1596

DATE *May 24, 1986* JOB NUMBER 0289

REVISED: MARCH 6, 1986

JLK-10A + JLK-13

217-627✓