




WALWORTH COUNTY
SURVEYING & MAPPING
LAKE GENEVA, WISCONSIN

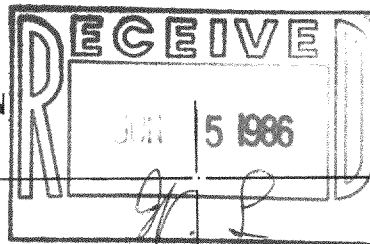

WHITTIER DRIVE

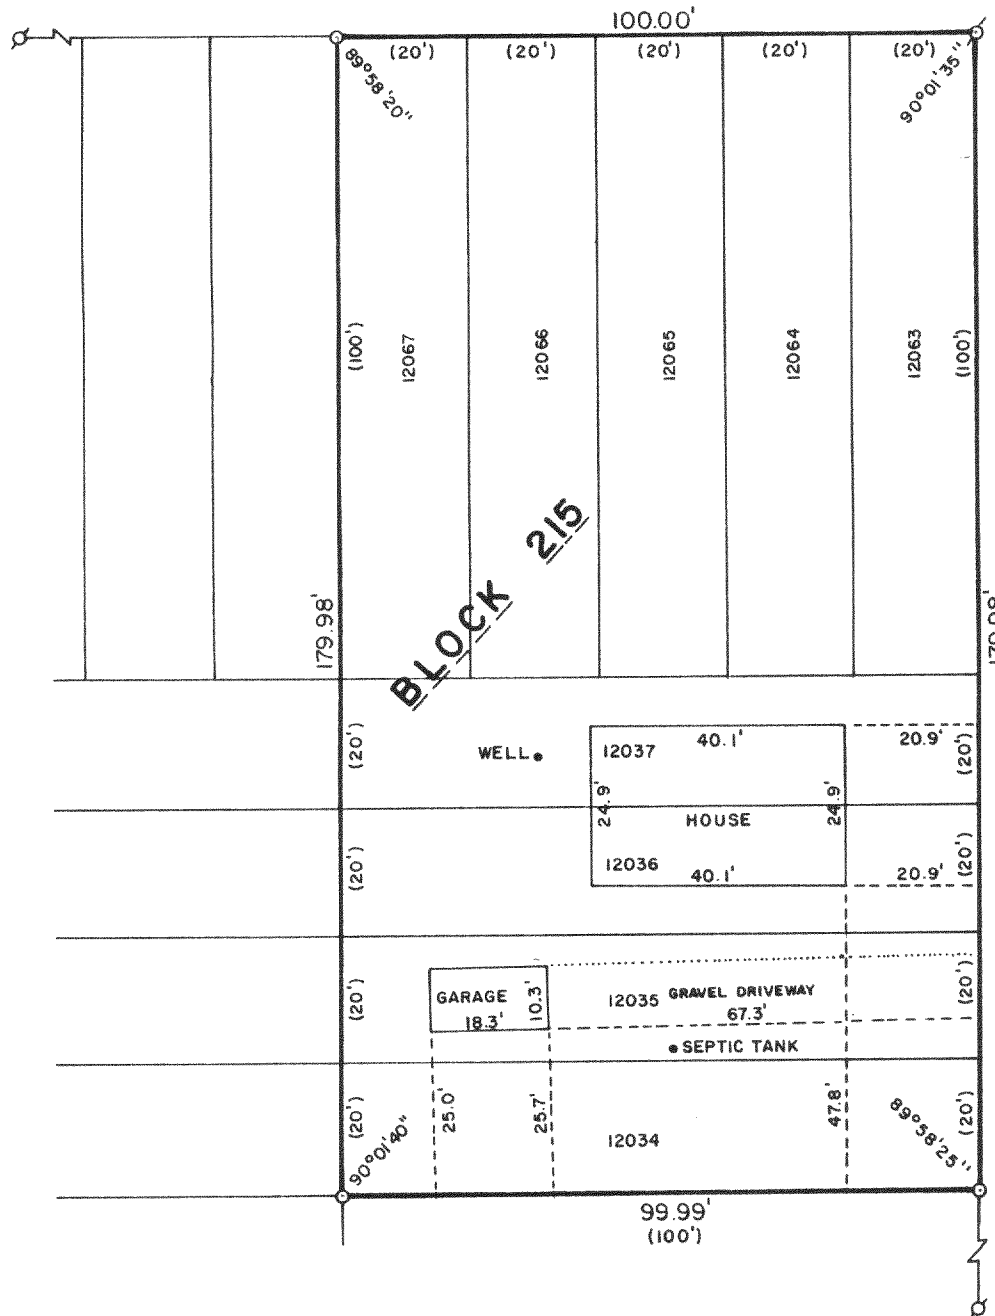


CANARY ROAD

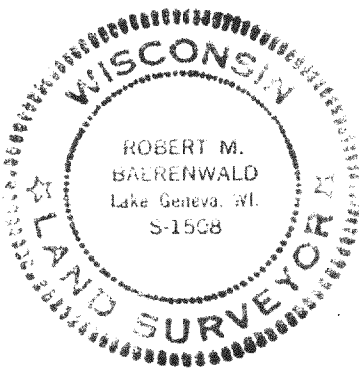

PLAT OF SURVEY OF

LOTS 12034-12037 AND 12063-12067, BLOCK
215 OF LAKE COMO BEACH SUBDIVISION,
LOCATED IN T 2 N, R 17 E, WALWORTH
COUNTY, WISCONSIN.

ORDERED BY: GENTRY COLEMAN
C/O LAKELAND NURSING HOME
ELKHORN, WISCONSIN 53121

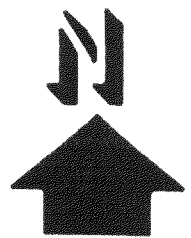

SCALE: 1"=30'

- ⊕ - IRON PIPE FOUND
- - IRON ROD SET
- () - RECORDED AS

I, ROBERT M. BAERENWALD, DO HEREBY CERTIFY THAT I
HAVE SURVEYED THE PROPERTY HEREON DESCRIBED ACCORDING
TO THE OFFICIAL RECORDS AND THAT THE PLAT HEREON IS A
CORRECT REPRESENTATION OF THE PROPERTY LINES TO THE
BEST OF MY KNOWLEDGE AND BELIEF.

Robert M. Baerenwald
ROBERT M. BAERENWALD
WISCONSIN REGISTERED LAND SURVEYOR, S-1508

DATE *May 2, 1986* JOB NO. 0527

JLCB-02618

217-628-B