



WALWORTH COUNTY  
SURVEYING & MAPPING  
LAKE GENEVA, WISCONSIN

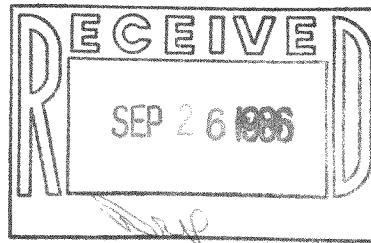

(100.00')  
100.07'

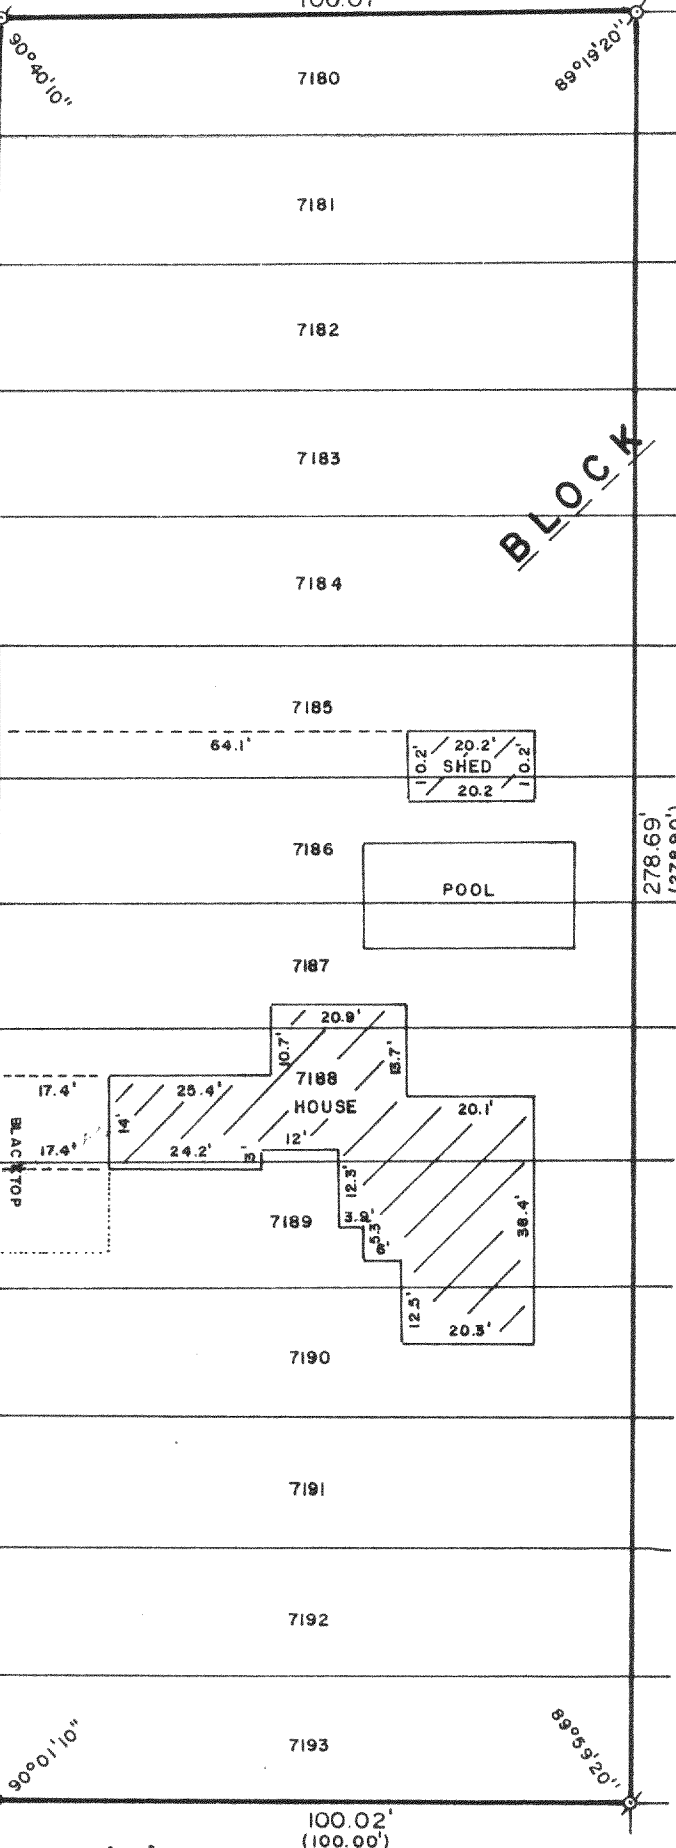


PLAT OF SURVEY OF

LOTS 7180-7193, INCLUSIVE,  
BLOCK 123 OF LAKE COMO BEACH  
SUBDIVISION, LOCATED IN T 2 N,  
R 17 E, WALWORTH COUNTY, WISCONSIN.

ORDERED BY: MIKROT REALTY  
RT. 5, BOX 453  
LAKE GENEVA, WI

NOTE: THIS IS A RESURVEY OF LAND  
SURVEYED BY HAROLD H. KOLB IN  
1963.

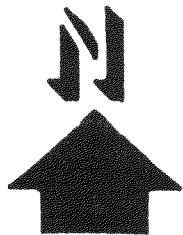

SCALE: 1"=30'

- o -IRON PIPE FOUND
- o -FOUND SPIKE, SET IRON ROD
- ( ) -RECORDED AS

I, ROBERT M. BAERENWALD, DO HEREBY CERTIFY THAT I  
HAVE SURVEYED THE PROPERTY HEREON DESCRIBED ACCORDING  
TO THE OFFICIAL RECORDS AND THAT THE PLAT HEREON IS A  
CORRECT REPRESENTATION OF THE PROPERTY LINES TO THE  
BEST OF MY KNOWLEDGE AND BELIEF.

*Robert M. Baerenwald*  
ROBERT M. BAERENWALD  
WISCONSIN REGISTERED LAND SURVEYOR, S-1508

*Sept. 10, 1986*  
DATE JOB NO. 0715

NOTE: THIS IS NOT A CERTIFIED COPY UNLESS SEALED.