
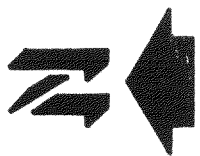


WALWORTH COUNTY
SURVEYING & MAPPING
LAKE GENEVA, WISCONSIN

PLAT OF SURVEY OF

LOTS 5131-5140, BLOCK 90, LAKE
COMO BEACH SUBDIVISION, T2N, R17E,
WALWORTH COUNTY, WISCONSIN.

ORDERED BY: MIKRUT REALTY
CLUB HOUSE DRIVE
LAKE COMO
LAKE GENEVA, WI
53147

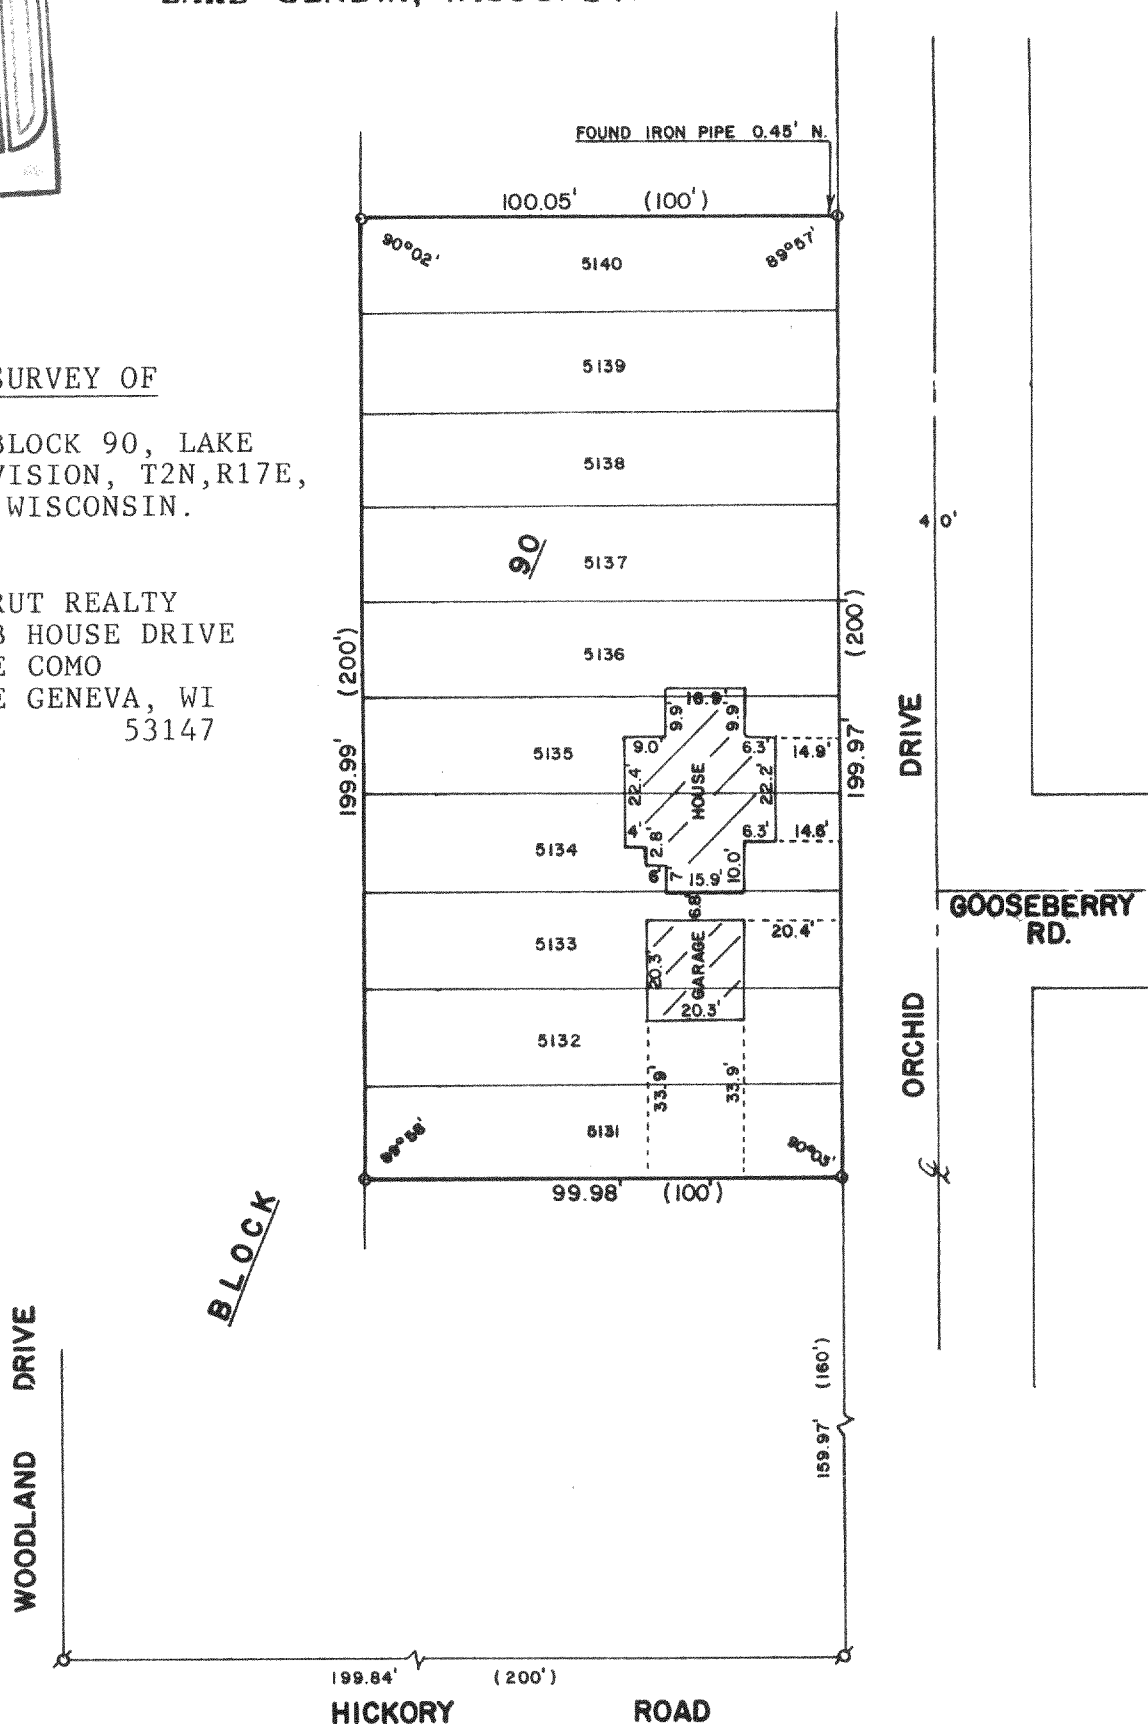

SCALE - 1"=40'

LEGEND

- ⊘ - IRON PIPE FOUND
- - IRON ROD SET
- () - RECORDED AS

I, ROBERT M. BAERENWALD, DO HEREBY CERTIFY THAT I
HAVE SURVEYED THE PROPERTY HEREON DESCRIBED ACCORDING
TO THE OFFICIAL RECORDS AND THAT THE PLAT HEREON IS A
CORRECT REPRESENTATION OF THE PROPERTY LINES TO THE
BEST OF MY KNOWLEDGE AND BELIEF.

Robert M. Baerenwald
ROBERT M. BAERENWALD
WISCONSIN REGISTERED LAND SURVEYOR, S-1508

DATE *Sept. 18, 1986* JOB NO. 0697

NOTE: THIS IS NOT A CERTIFIED COPY UNLESS SEALED.

JLCB-1034

217-6598