


Wisconsin Registered Land Surveyor S-1594

RECEIVED
MAR 9 1987

Together with the right of ingress and egress to Lot 1 over the most northerly 553.44 feet of Lot 2 of said Certified Survey being a strip of land 66 feet in width, fronting on Kelly Road, and 553.44 feet in length to be shared with the owner or owners of Lot 2 as it is now laid out or as it may be subdivided henceforth.

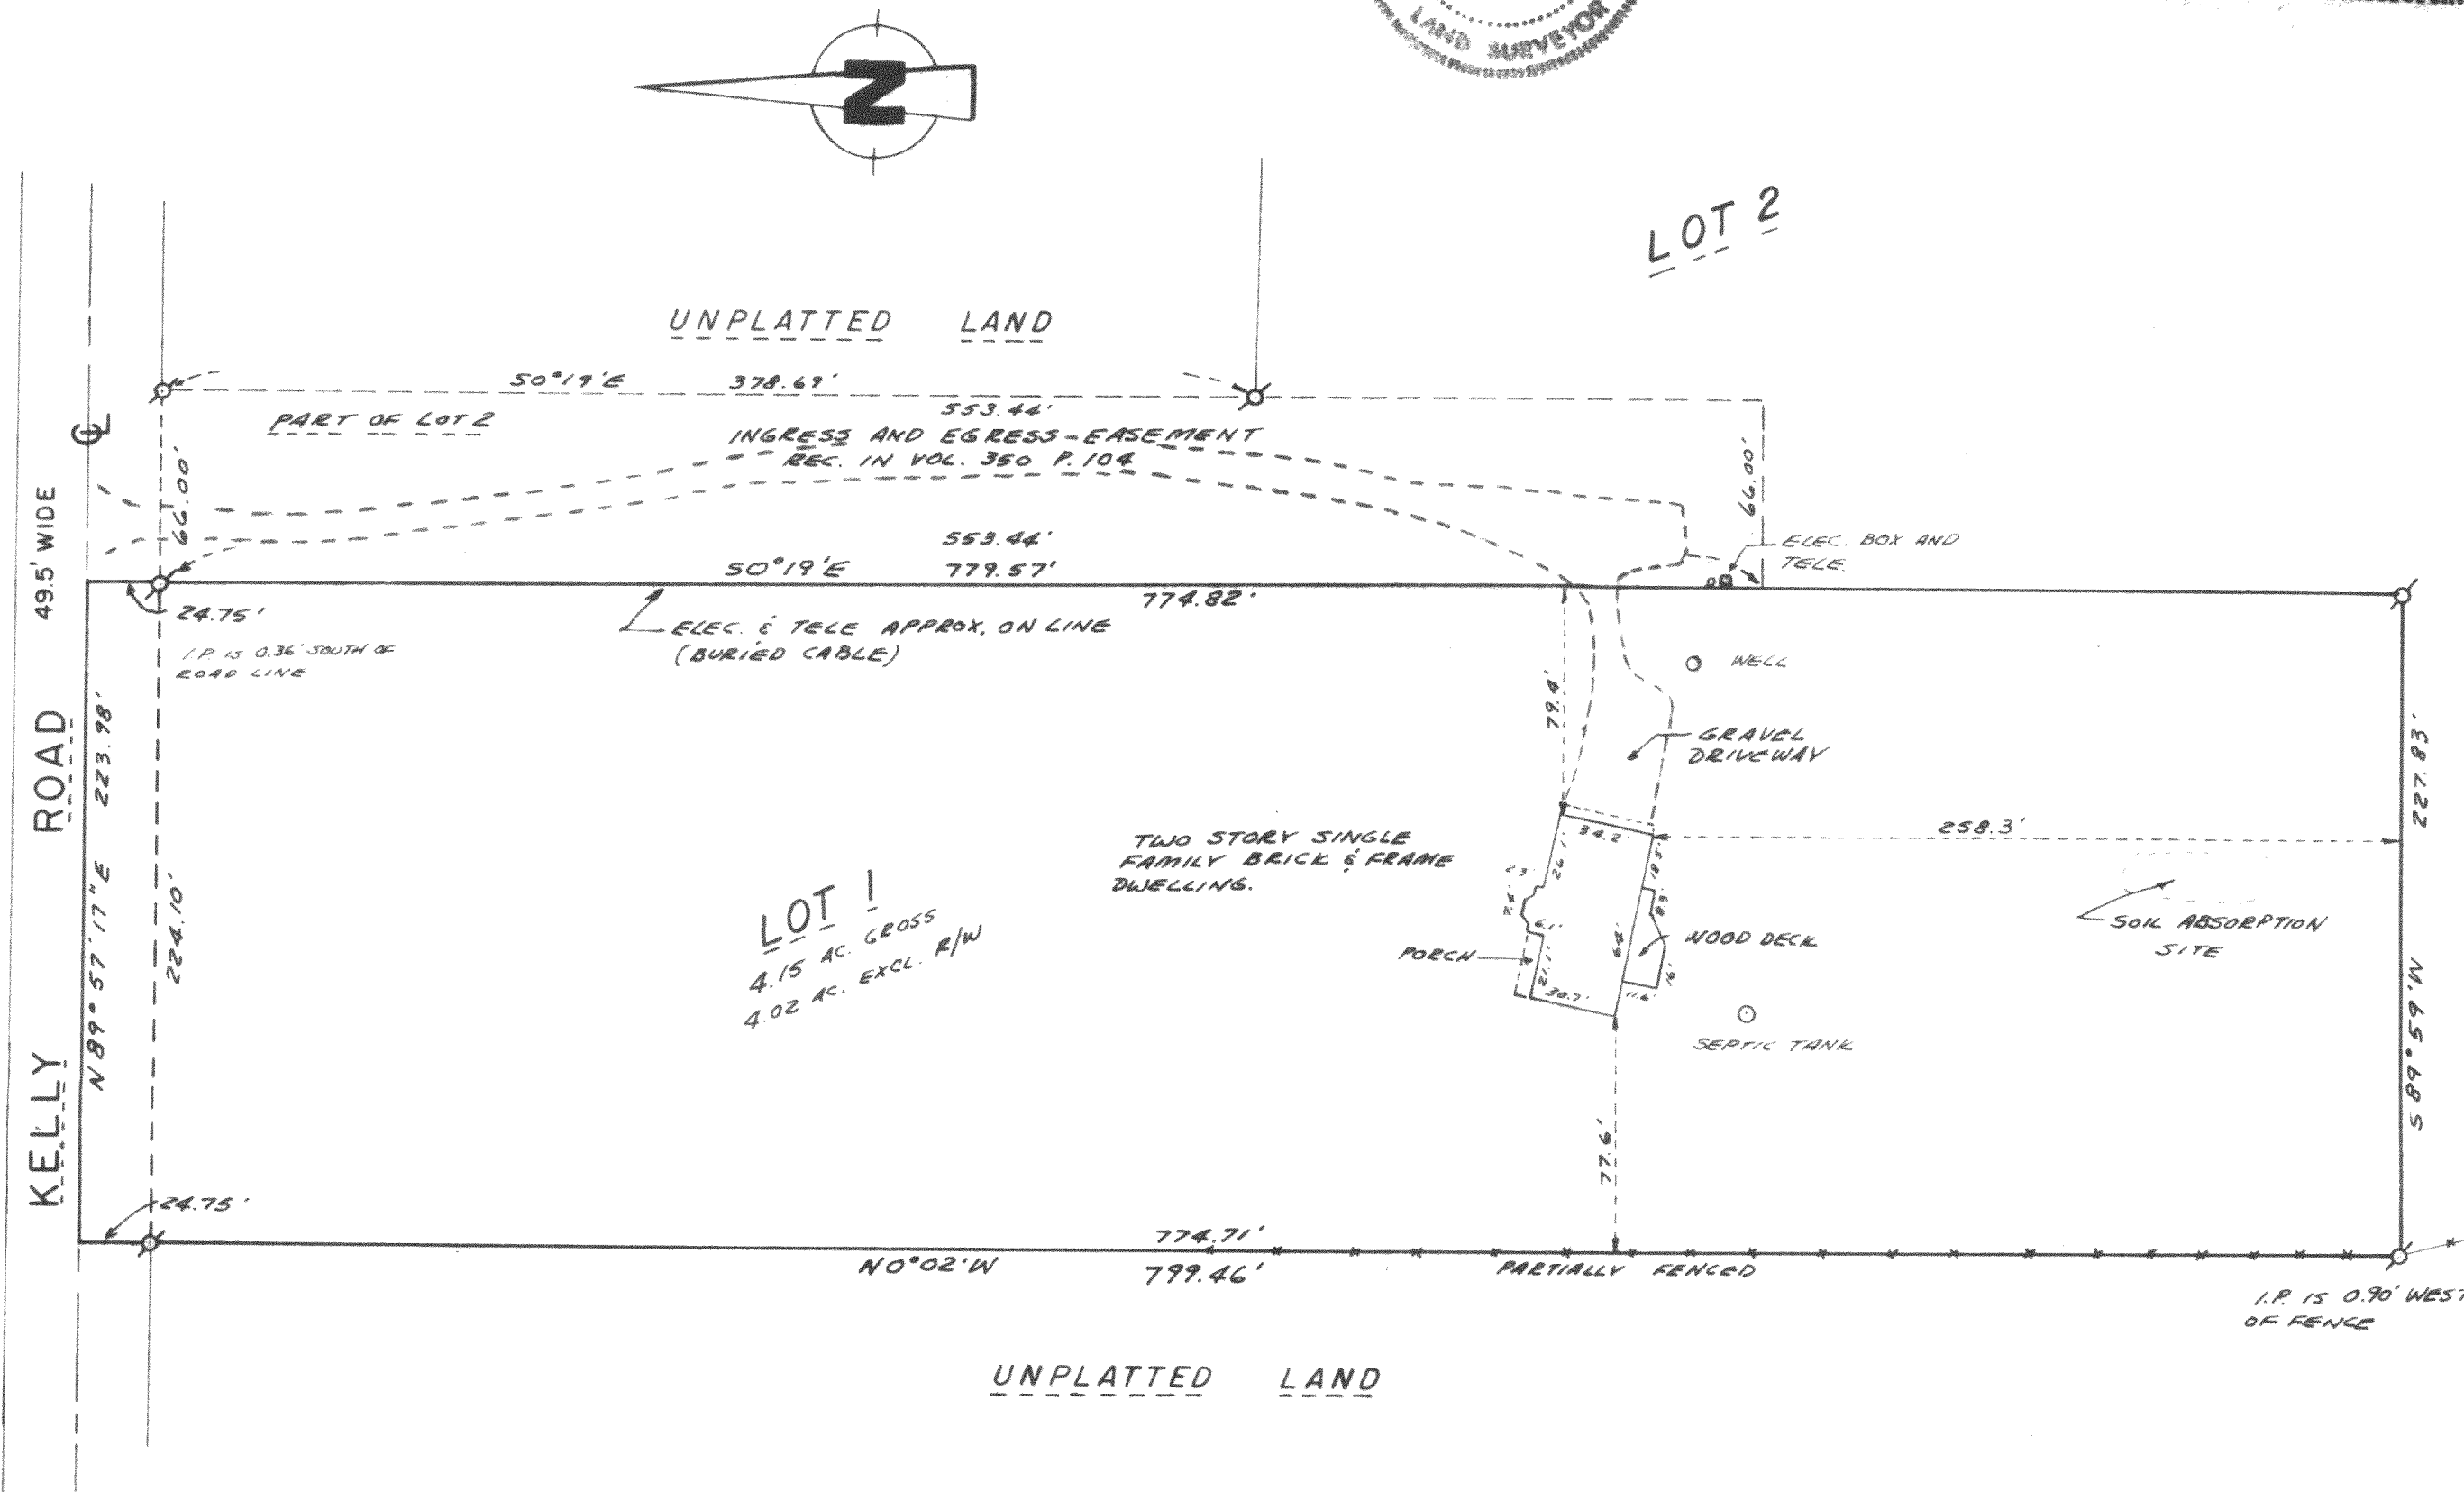

SCALE: 1" = 60 FEET

"I hereby certify that I have surveyed the above described property and that the above map is a true representation thereof and shows the size and location of the property, its exterior boundaries, the location of all visible structures and dimensions of all principal buildings thereon, boundary fences, apparent easements, roadways and visible encroachments, if any."

"This survey is made for the use of the present owners of the property, and also those who purchase, mortgage, or guarantee the title thereto within one year from date hereof."

Kenneth B. Abernathy, Jr.
KENNETH B. ABERNATHY, JR.
WISCONSIN REGISTERED LAND SURVEYOR,
S-1594

Date: 2-4-87 Job No. 102

JA1436-1

217-667