
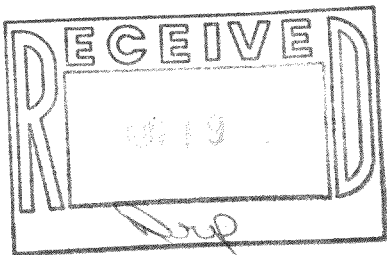


WALWORTH COUNTY
SURVEYING & MAPPING
LAKE GENEVA, WISCONSIN


WOODLAND DRIVE

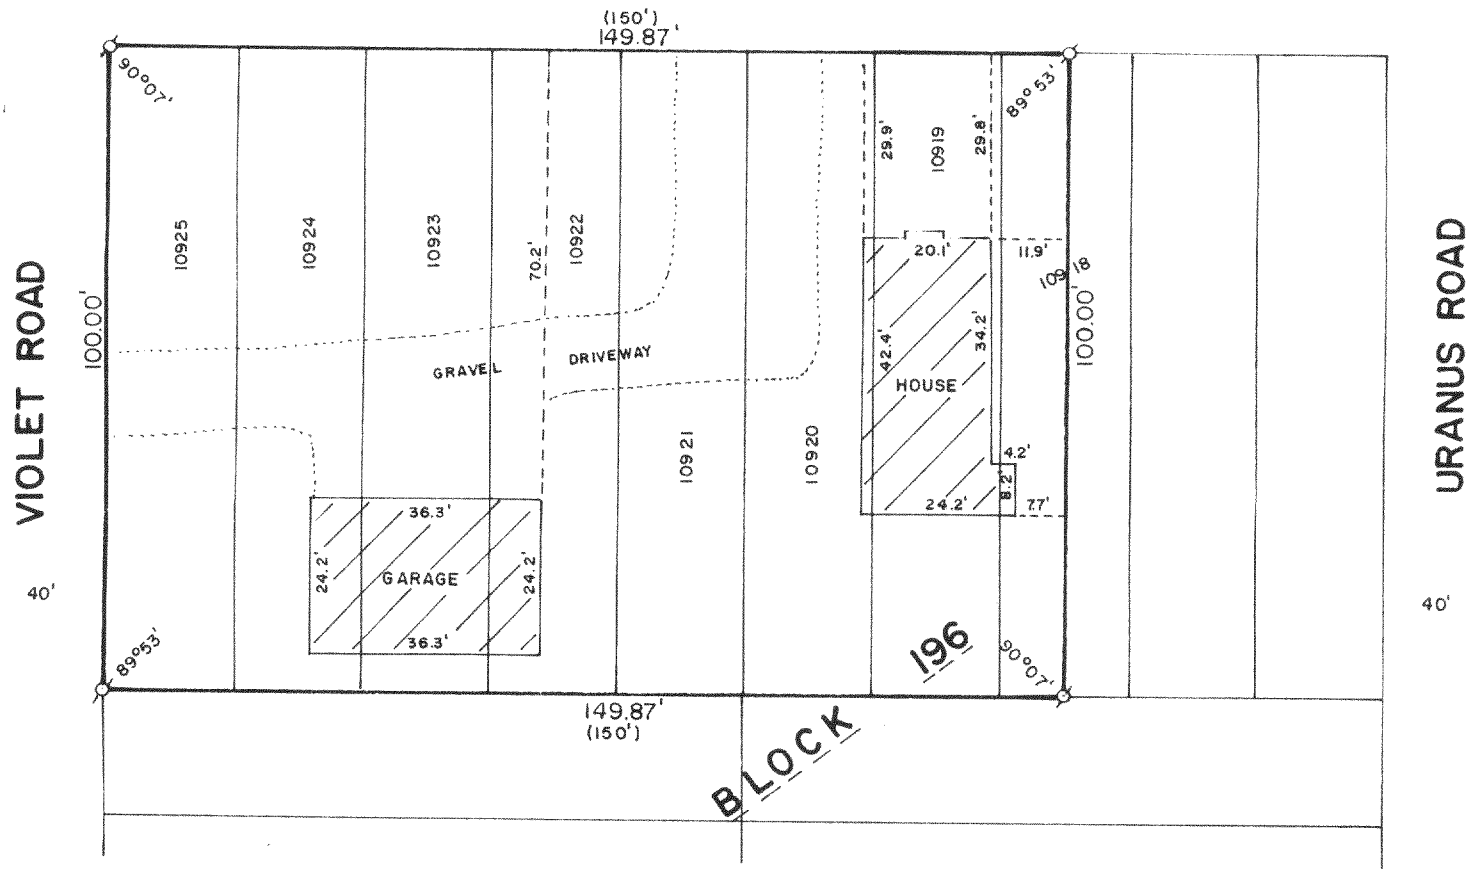

PLAT OF SURVEY OF

THE WEST 1/2 OF LOT 10918 AND ALL
OF LOTS 10919-10925, BLOCK 196 OF
LAKE COMO BEACH SUBDIVISION, LOCATED
IN T 2 N, R 17 E, WALWORTH COUNTY,
WISCONSIN.

ORDERED BY: VACATION PROPERTIES NETWORK
803 MAIN STREET
LAKE GENEVA, WISCONSIN 53147

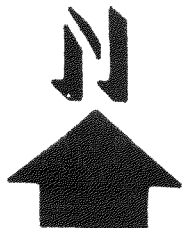

SCALE: 1"=30'

σ - IRON PIPE FOUND
() - RECORDED AS

I, ROBERT M. BAERENWALD, DO HEREBY CERTIFY THAT I
HAVE SURVEYED THE PROPERTY HEREON DESCRIBED ACCORDING
TO THE OFFICIAL RECORDS AND THAT THE PLAT HEREON IS A
CORRECT REPRESENTATION OF THE PROPERTY LINES TO THE
BEST OF MY KNOWLEDGE AND BELIEF.

Robert M. Baerenwald
ROBERT M. BAERENWALD
WISCONSIN REGISTERED LAND SURVEYOR, S-1508

May 21, 1987
DATE JOB NO. 1065

NOTE: THIS IS NOT A CERTIFIED COPY UNLESS SEALED.

JLCLB 2379

217-683