

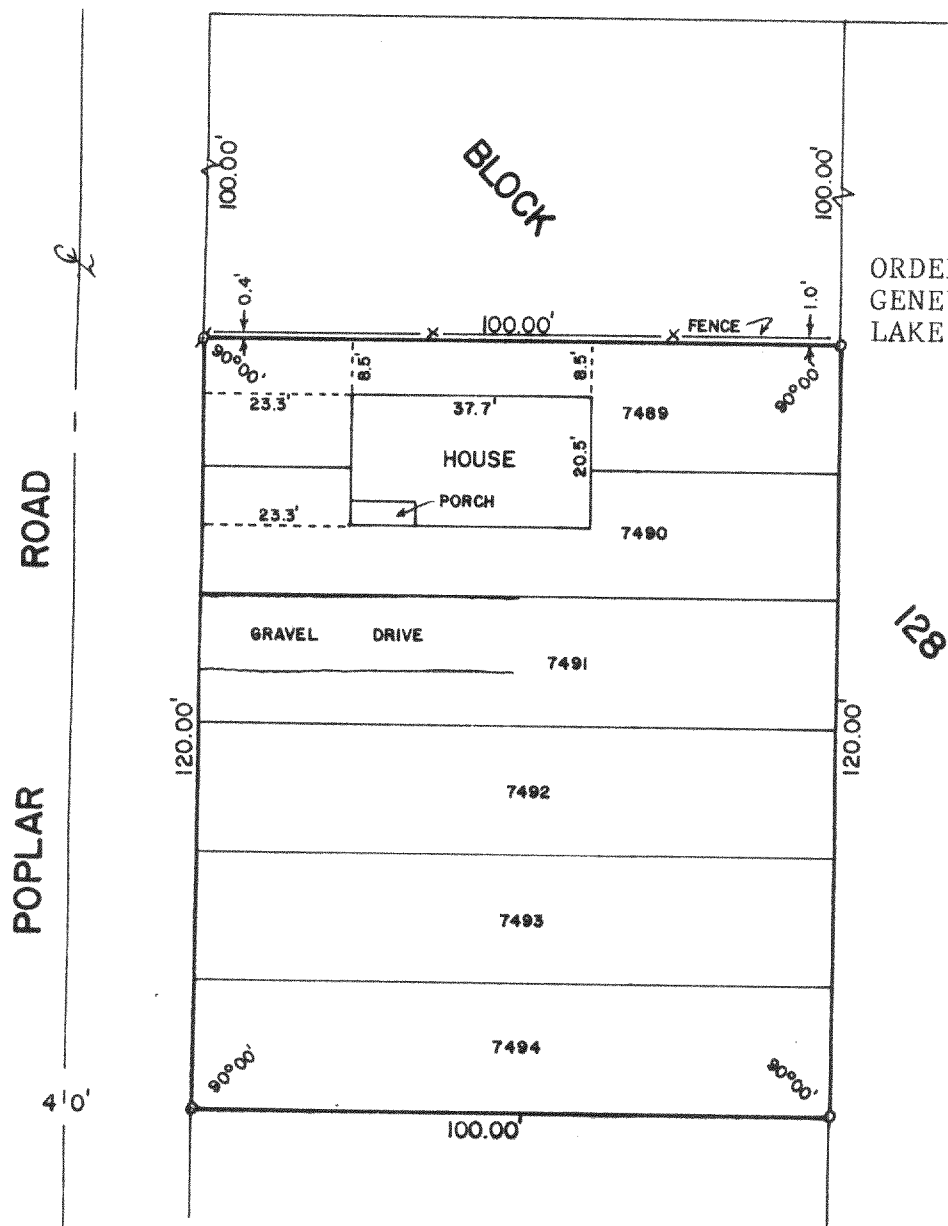


WOODLAND DRIVE

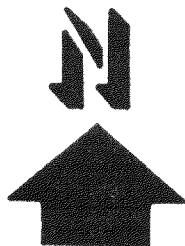

128

LOTS 7489-7494, BLOCK 128, LAKE COMO BEACH
SUBDIVISION, T2N,R17E, WALWORTH COUNTY,
WISCONSIN.

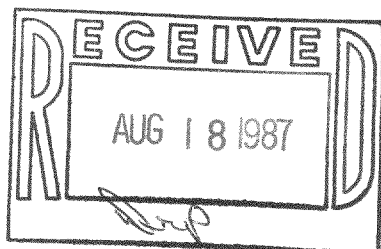

LEGEND

- ∅ - IRON PIPE FOUND
 ○ - IRON ROD SET

I, ROBERT M. BAERENWALD, DO HEREBY CERTIFY THAT I HAVE SURVEYED THE PROPERTY HEREON DESCRIBED ACCORDING TO THE OFFICIAL RECORDS AND THAT THE PLAT HEREON IS A CORRECT REPRESENTATION OF THE PROPERTY LINES TO THE BEST OF MY KNOWLEDGE AND BELIEF.

Robert M. Baerenwald
ROBERT M. BAERENWALD
WISCONSIN REGISTERED LAND SURVEYOR, S-1508

DATE June 11, 1987 JOB NO. 1108

NOTE: THIS IS NOT A CERTIFIED COPY UNLESS SEALED.