


DUNHAM SURVEYING, S.C.
SURVEYING & SUBDIVIDING
DELAVER, WISCONSIN 53115

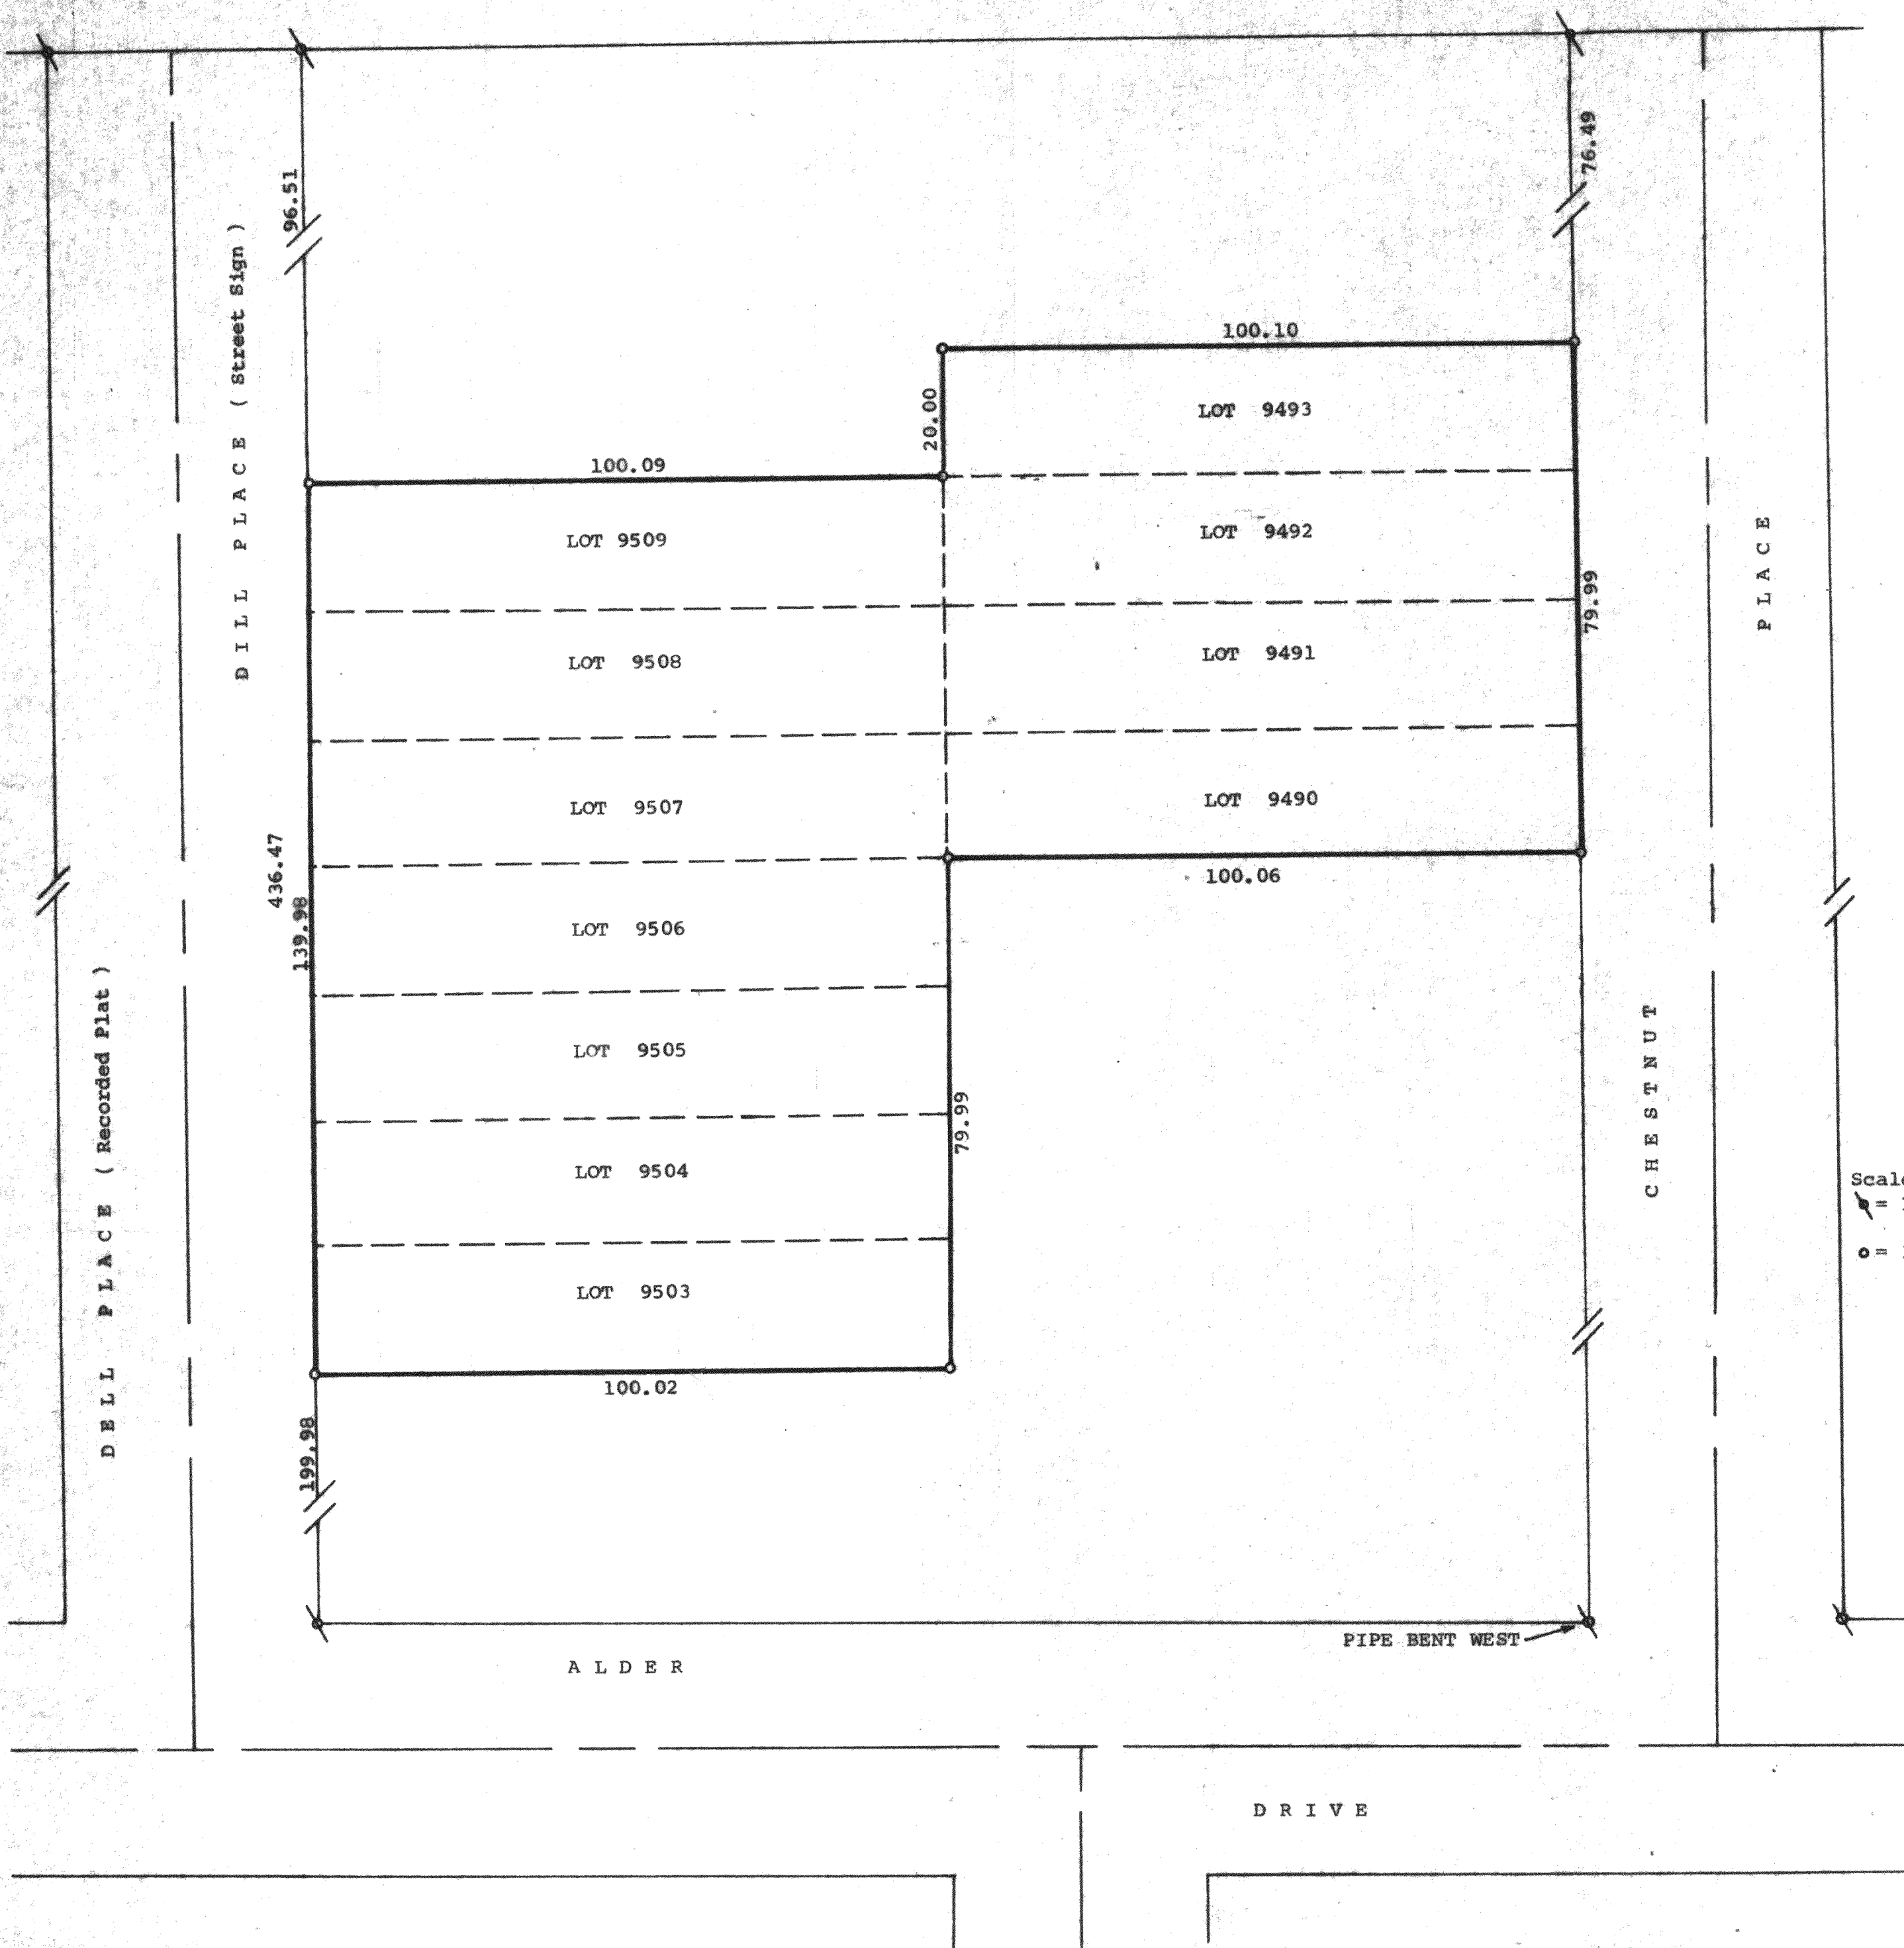

Plat of survey of:
Lots 9503 through 9509 inclusive and Lots 9490 through 9493
inclusive all of Block 171 in Lake Como Beach Subdivision,
located in Section 21, T 2 N, R 17 E, Walworth County, Wisconsin.
June 14, 1978

George T. Dunham
George T. Dunham, Surveyor

