


WALWORTH COUNTY
SURVEYING & MAPPING
LAKE GENEVA, WISCONSIN

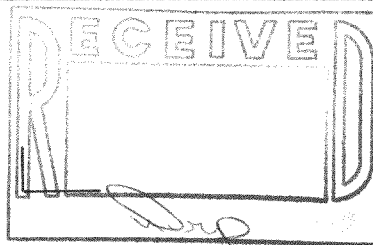

TAMARACK ROAD



LONGFELLOW DRIVE

URANUS ROAD

PLAN OF SURVEY OF

LOTS 10458-10467 AND 10490-10491, BLOCK 190
OF LAKE COMO BEACH, A SUBDIVISION LOCATED IN
E 2 N, R 17 E, WALWORTH COUNTY, WISCONSIN.

ORDERED BY: NIKROT REALTY
RT. 5, BOX 453
LAKE GENEVA, WISCONSIN 53147

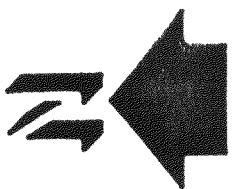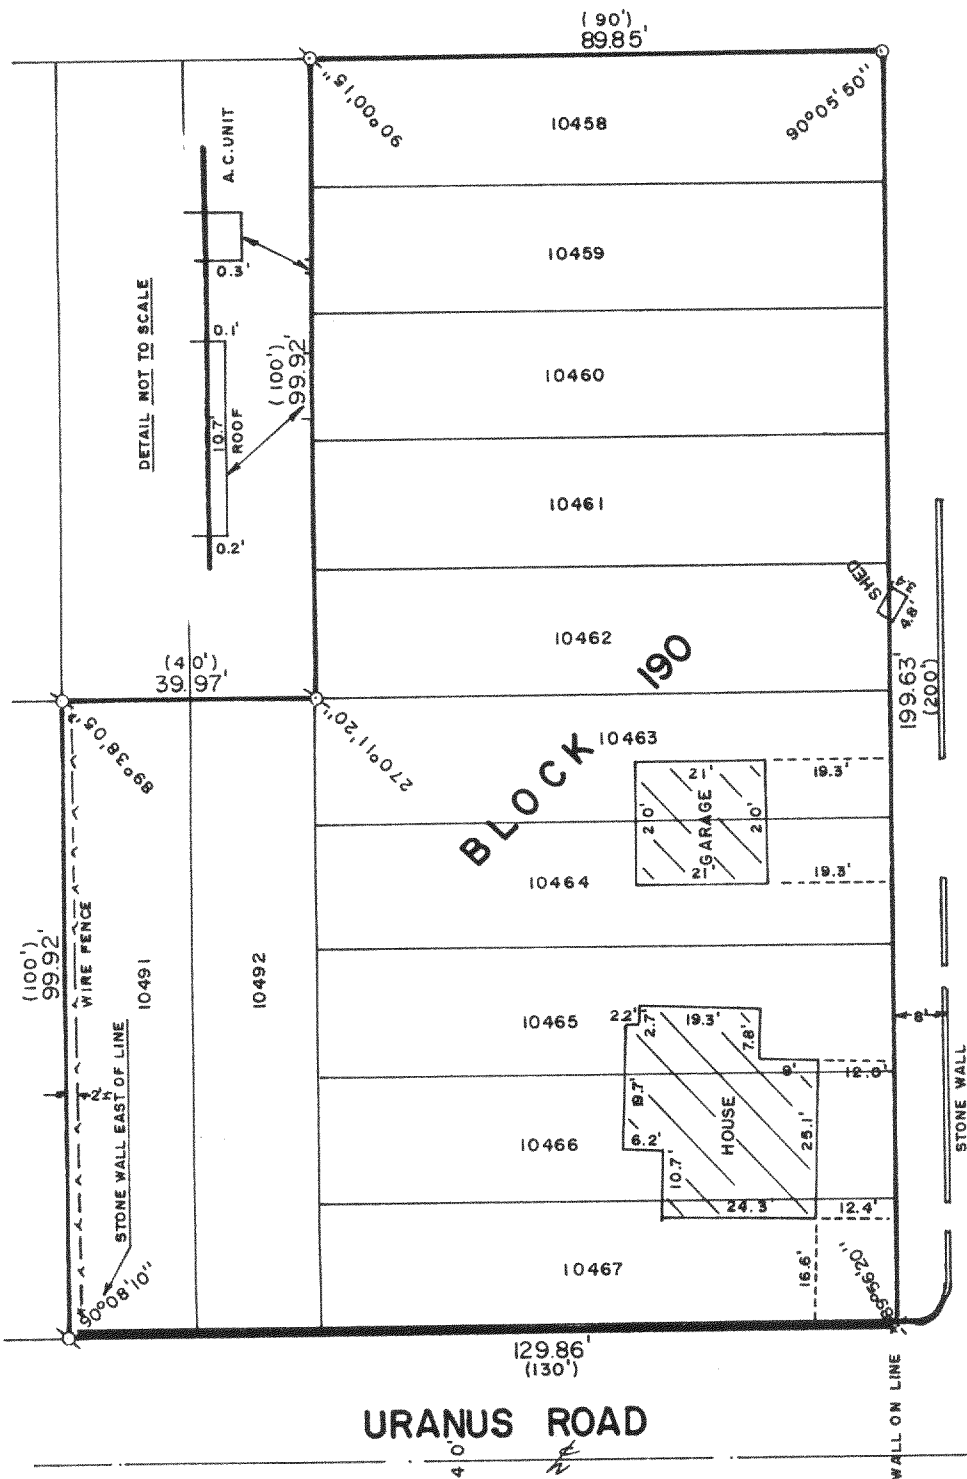

- IRON POST PLACED
- IRON PIPE FOUND
- ✕ F.P. NAIL IN WALL
- () RECEIVED AS

I, ROBERT M. BAERENWALD, DO HEREBY CERTIFY THAT I
HAVE SURVEYED THE PROPERTY HEREON DESCRIBED ACCORDING
TO THE OFFICIAL RECORDS AND THAT THE PLAT HEREON IS A
CORRECT REPRESENTATION OF THE PROPERTY LINES TO THE
BEST OF MY KNOWLEDGE AND BELIEF.

Robert M. Baerenwald
ROBERT M. BAERENWALD
WISCONSIN REGISTERED LAND SURVEYOR, S-1508

DATE Oct. 11, 1987 JOB NO. 1088

NOTE: THIS IS NOT A CERTIFIED COPY UNLESS SEALED.