
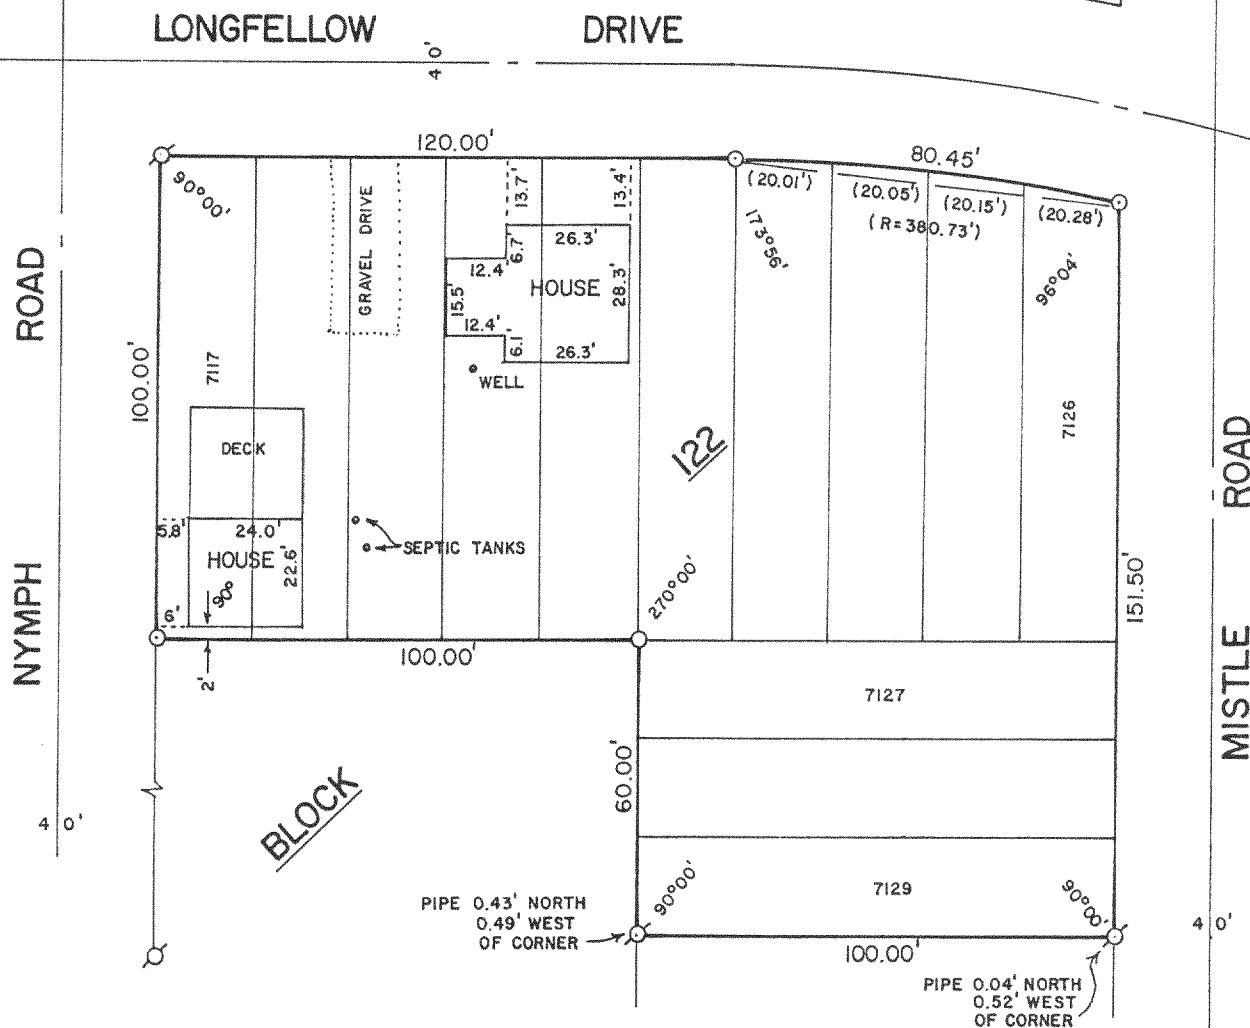



ABELL
SURVEYING & MAPPING
DELAVER, WISCONSIN 53115
414-728-6737

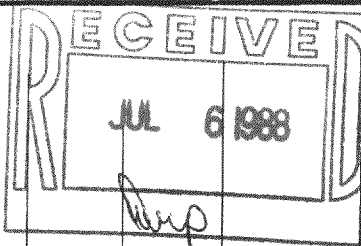

PLAT OF SURVEY OF

LOTS 7117-7129, BLOCK 122, LAKE COMO BEACH SUBDIVISION,
T2N, R17E, WALWORTH COUNTY, WISCONSIN.

ORDERED BY: SHARON D'ANDREA
ROUTE 2, BOX 337-17
LAKE GENEVA, WI. 53147

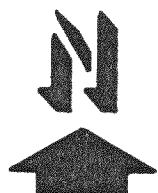

SCALE - 1"=40'

- LEGEND
 ♂ - IRON PIPE FOUND
 ○ - IRON ROD SET
 () - RECORDED AS

I, DAVID F. ABELL, DO HEREBY CERTIFY
THAT I HAVE SURVEYED THE PROPERTY
HEREON DESCRIBED ACCORDING TO THE
OFFICIAL RECORDS AND THAT THE PLAT
HEREON IS A CORRECT REPRESENTATION
OF THE PROPERTY LINES TO THE BEST OF
MY KNOWLEDGE AND BELIEF.

David F. Abell

DAVID F. ABELL
WISCONSIN REGISTERED LAND SURVEYOR, S-1596

DATE *June 1, 1988*

JOB NUMBER - 88102

NOTE: THIS IS NOT A CERTIFIED COPY UNLESS SEALED.

217-772