


**ABELL
SURVEYING & MAPPING
DELAVER, WISCONSIN 53115
414-728-6737**



BLOCK

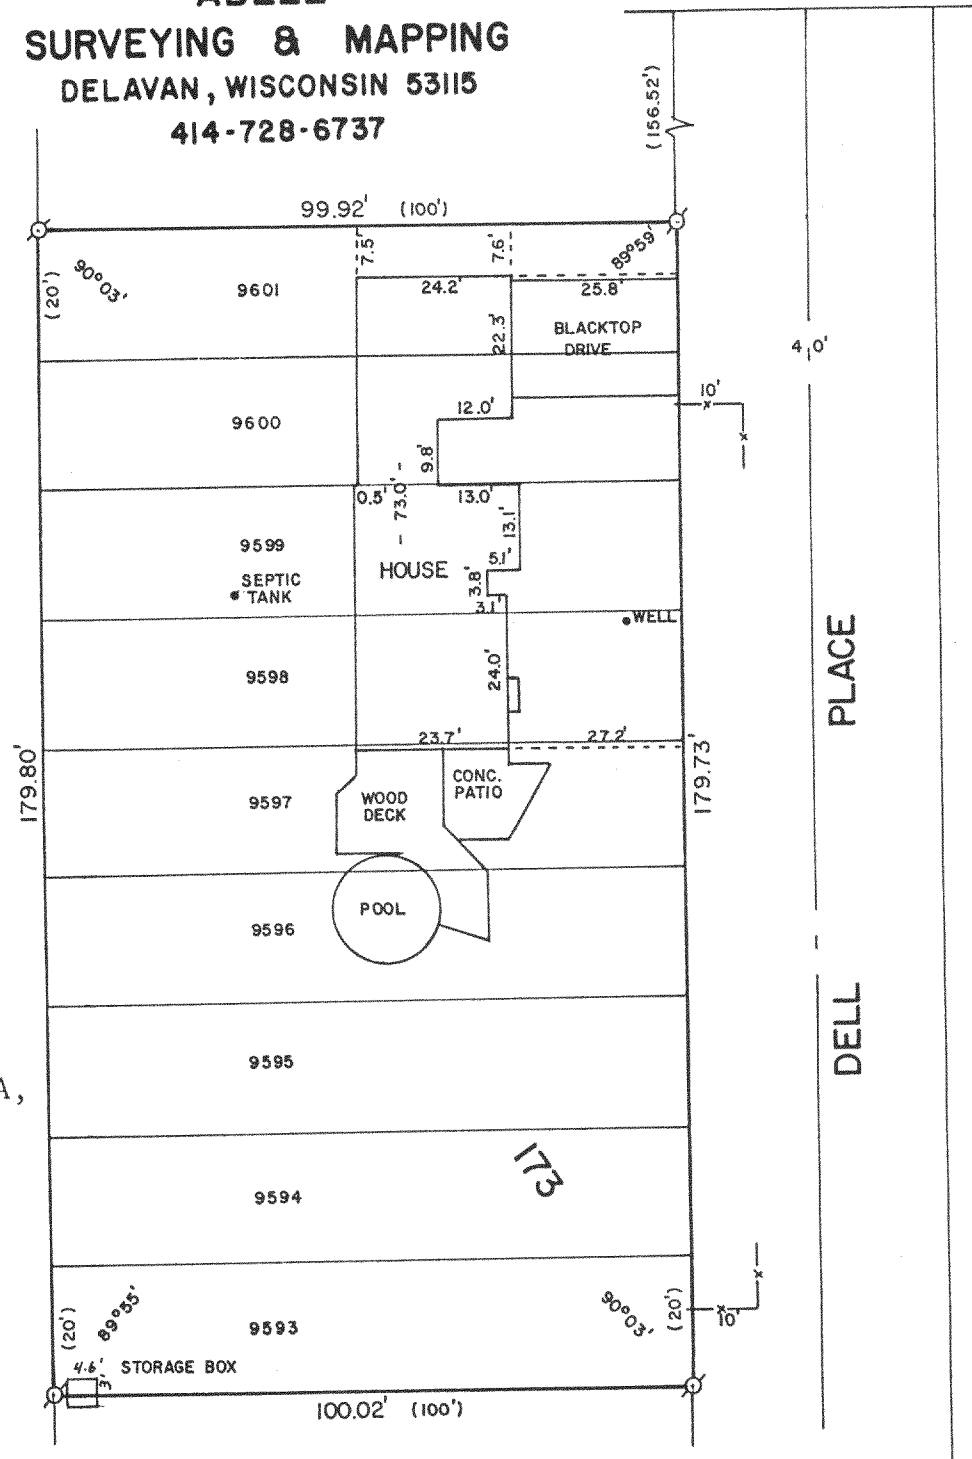

ORDERED BY: BARB HILL
ROUTE 2
BOX 300-11
LAKE GENEVA,
WI. 53147

PLAT OF SURVEY OF

LOTS 9593-9601, BLOCK 173 OF LAKE COMO BEACH
SUBDIVISION, T2N, R17E, WALWORTH COUNTY, WI.

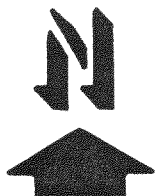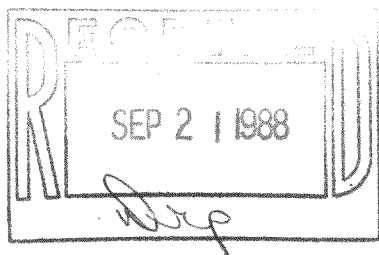

SCALE - 1"=30'

LEGEND

- ⊙ - IRON PIPE FOUND
- () - RECORDED AS
- x— WOOD FENCE

I, DAVID F. ABELL, DO HEREBY CERTIFY
THAT I HAVE SURVEYED THE PROPERTY
HEREON DESCRIBED ACCORDING TO THE
OFFICIAL RECORDS AND THAT THE PLAT
HEREON IS A CORRECT REPRESENTATION
OF THE PROPERTY LINES TO THE BEST OF
MY KNOWLEDGE AND BELIEF.

David F. Abell

DAVID F. ABELL
WISCONSIN REGISTERED LAND SURVEYOR, S-1596

DATE *July 19, 1988*

JOB NUMBER - 88154

NOTE: THIS IS NOT A CERTIFIED COPY UNLESS SEALED.