

PLAT OF SURVEY of

Lots 7167 - 7174, Block 123 of Lake Como Beach Subdivision,
Section 28, T 2 N, R 17 E, Walworth County, Wisconsin



Jensen Surveying & Mapping S.C.
45 S. Wisconsin St. P.O. Box 322
Elkhorn, Wisconsin. 53121
(414) 723-3434

ORDERED BY:

Joe Palmisano
222 W. Adams Suite 257
Chicago, IL 60606

LEGEND


- Found iron pipe
- Set iron pipe
- () Recorded dimension

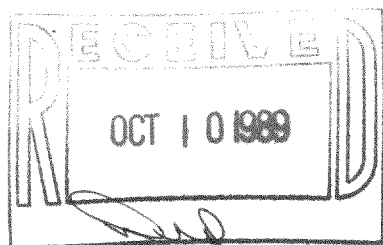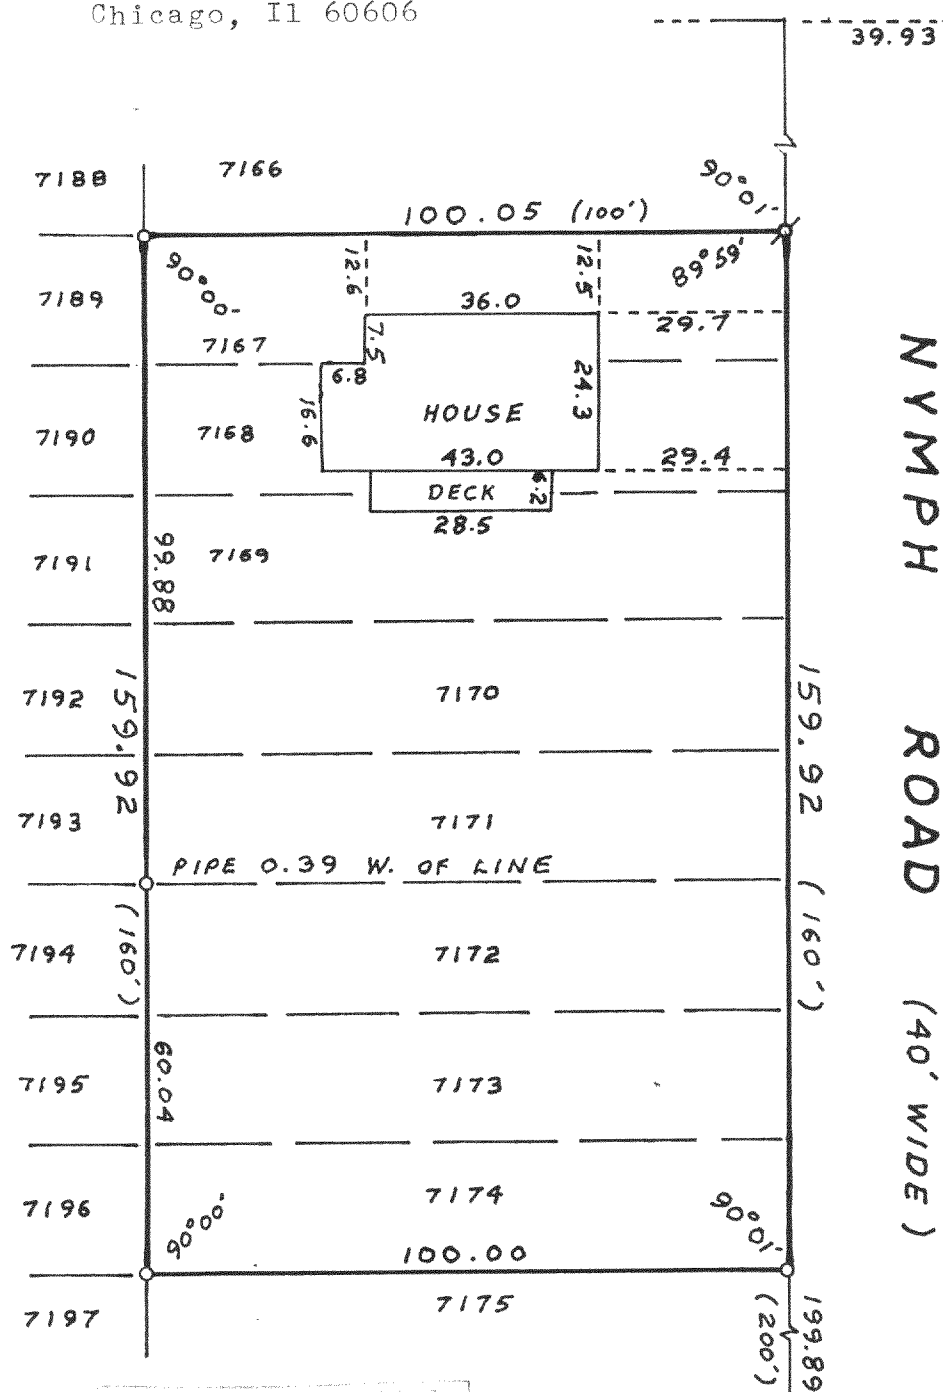

WOODLAND
DRIVE

SCALE: 1" = 30'

Mapping Date:
Feb. 14, 1989

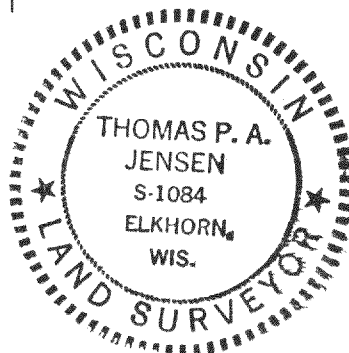

I hereby certify that I have surveyed the above described property and that the map hereon is a true representation thereof and shows the size and location of the property, its exterior boundaries, the location of all visible structures and dimensions of all principal buildings thereon, boundary fences, apparent easements, roadways and visible encroachments, if any.

This survey is made for the use of the present owners of the property and also those who purchase, mortgage, or guarantee the title thereto within one year from date hereof.

Thomas P. A. Jensen
THOMAS P. A. JENSEN
WISCONSIN REGISTERED LAND SURVEYOR, S-1084

Copyright © 1989 by Jensen Surveying & Mapping S.C.

All rights reserved. No part of this survey plat may be reproduced or transmitted in any form by any means - graphic, electronic, or mechanical, including photocopying, tracing, or information storage and retrieval systems - without permission in writing from Thomas P.A. Jensen, Jensen Surveying & Mapping S.C.