


**ABELL
SURVEYING & MAPPING
DELAVER, WISCONSIN 53115
414-728-6787**

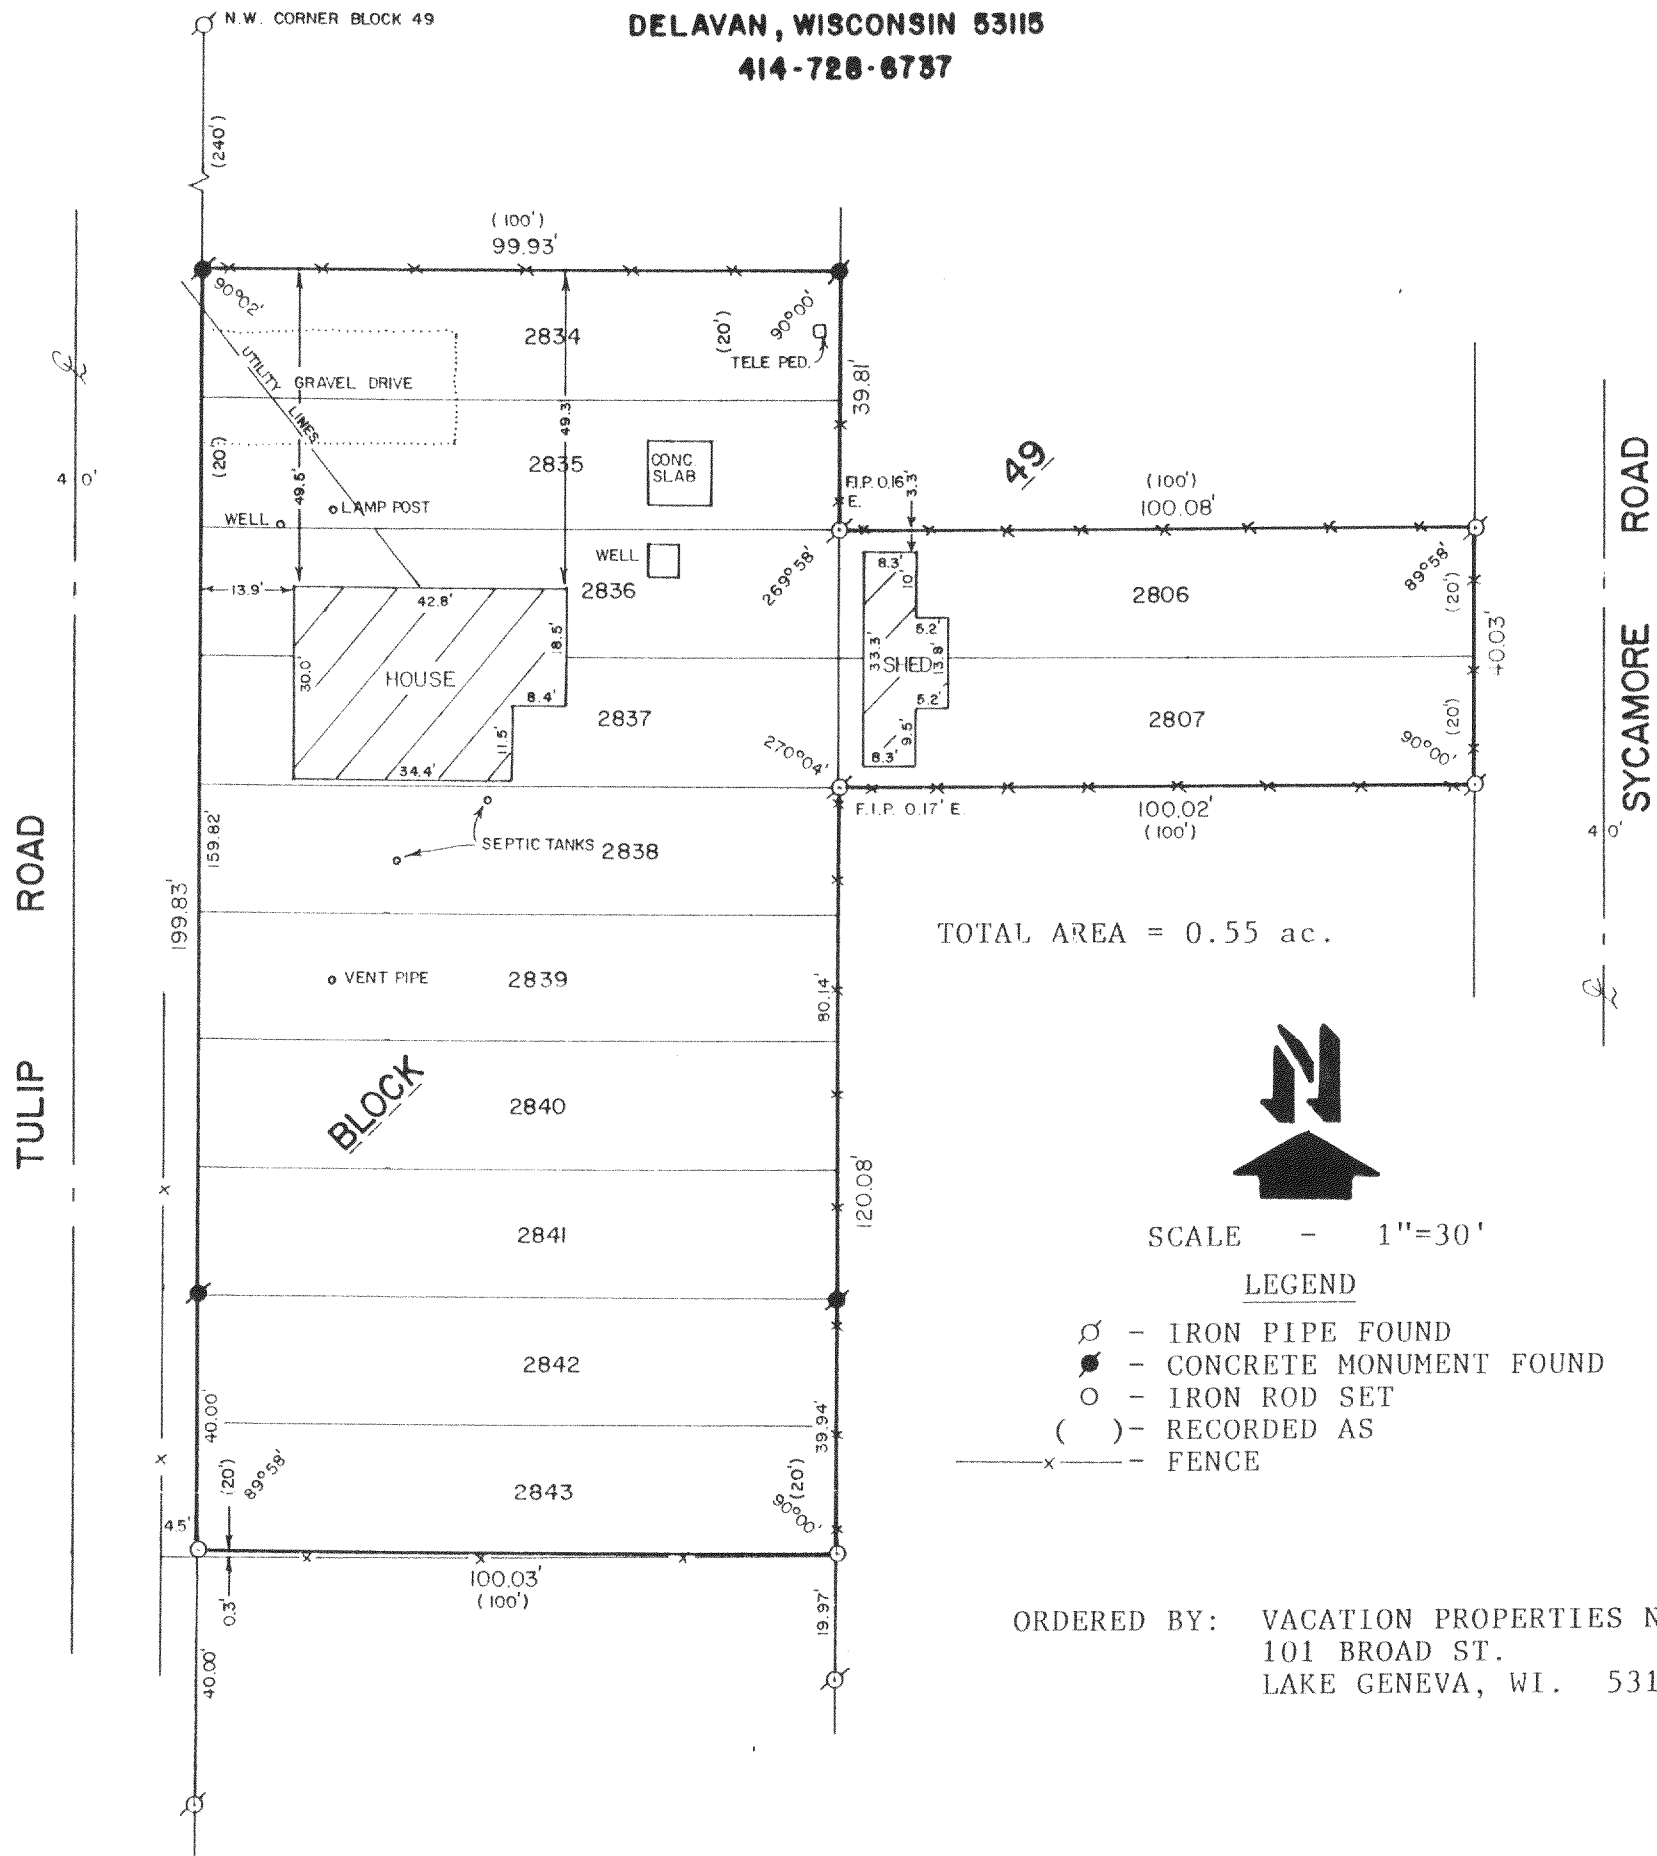


ORDERED BY: VACATION PROPERTIES NETWORK
101 BROAD ST.
LAKE GENEVA, WI. 53147

PLAT OF SURVEY OF

LOTS 2834-2843 AND LOTS 2806-2807, BLOCK 49, LAKE COMO
BEACH SUBDIVISION, T2N,R17E, WALWORTH COUNTY, WISCONSIN.

I HEREBY CERTIFY THAT I HAVE SURVEYED THE ABOVE
DESCRIBED PROPERTY AND THAT THE ABOVE MAP IS A
TRUE REPRESENTATION THEREOF AND SHOWS THE SIZE
AND LOCATION OF THE PROPERTY, ITS EXTERIOR
BOUNDARIES, THE LOCATION OF ALL VISIBLE STRUCTURES
AND DIMENSIONS OF ALL PRINCIPAL BUILDINGS THEREON,
BOUNDARY FENCES, APPARENT EASEMENTS, ROADWAYS AND
VISIBLE ENCROACHMENTS, IF ANY, TO THE BEST OF MY
KNOWLEDGE AND BELIEF.

THIS SURVEY IS MADE FOR THE USE OF THE PRESENT
OWNERS OF THE PROPERTY, AND ALSO THOSE WHO
PURCHASE, MORTGAGE, OR GUARANTEE THE TITLE THERETO
WITHIN ONE (1) YEAR FROM THE DATE HEREOF.

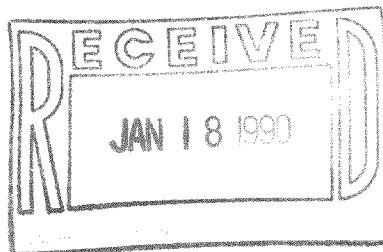

David F. Abell
DAVID F. ABELL

WISCONSIN REGISTERED LAND SURVEYOR, S-1596

November 2, 1989
DATE

JOB NUMBER - 89235

NOTE: THIS IS NOT A CERTIFIED COPY UNLESS SEALED.

JLCB-498