


WALWORTH COUNTY SURVEYING & MAPPING


727 HENRY STREET
LAKE GENEVA, WISCONSIN
414-248-0505

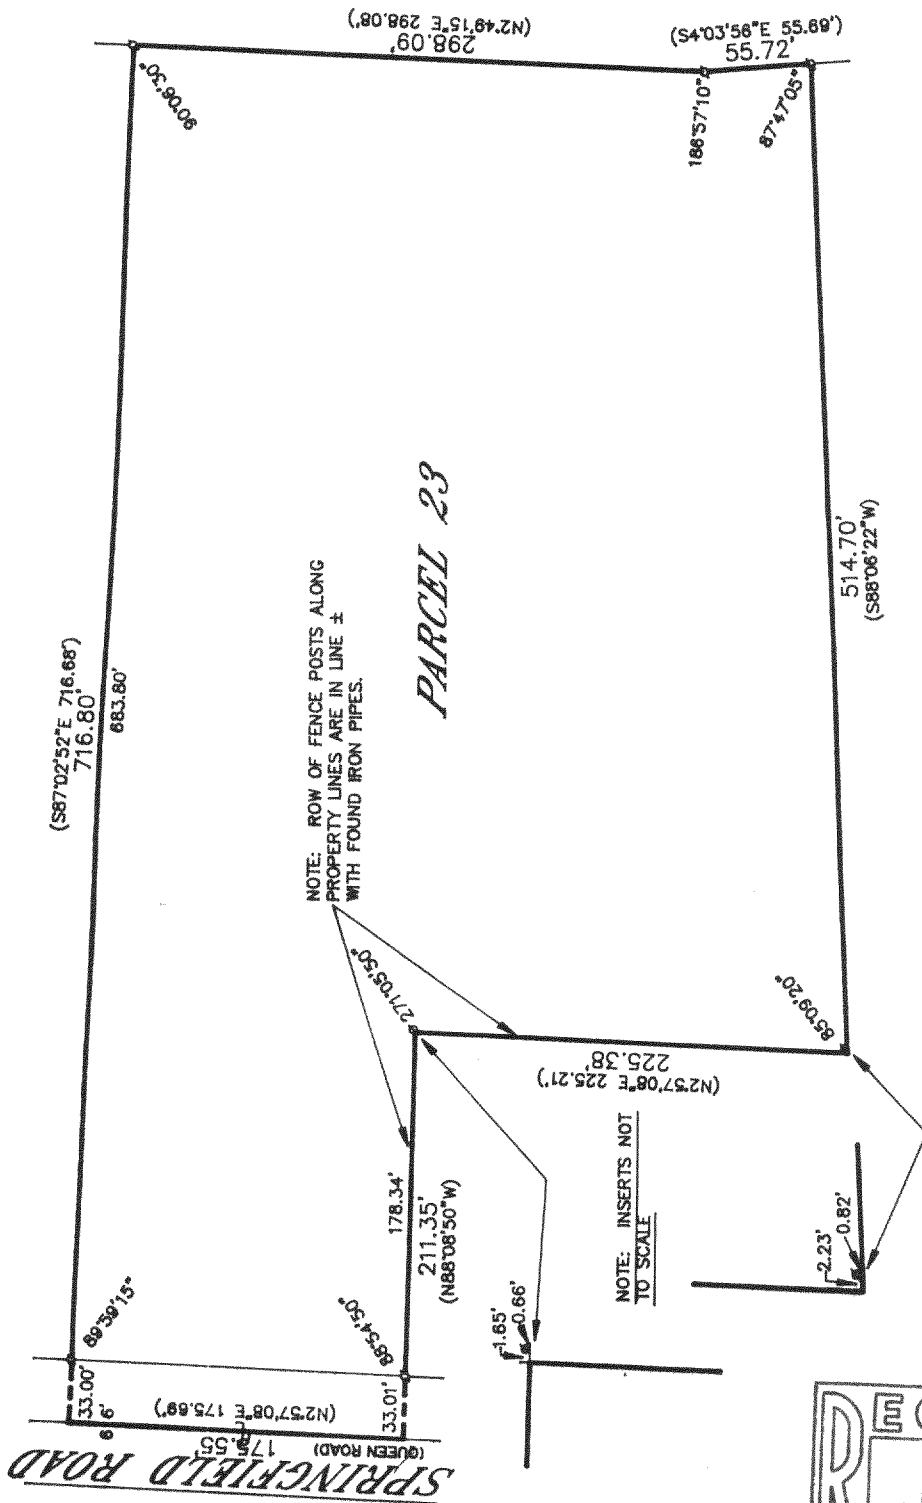

PLAT OF SURVEY OF

PARCEL 23 OF ROYAL GLEN WOODLANDS, LOCATED IN THE NORTHWEST 1/4 OF SECTION 22, T 2 N, R 17 E, WALWORTH COUNTY, WISCONSIN, DESCRIBED AS FOLLOWS: COMMENCING AT A POINT IN THE EAST LINE OF SAID 1/4 SECTION, 1320.35 FEET S00°23'50"W OF THE NORTHEAST CORNER OF SAID 1/4 SECTION; THENCE N88°23'55"W, ALONG THE NORTH LINE OF THE SOUTH 1/2 OF SAID 1/4 SECTION, 750.46 FEET TO A POINT; THENCE S2°49'15"W 929.66 FEET TO THE POINT OF BEGINNING; CONTINUING THENCE S2°49'15"W 298.08 FEET TO A POINT; THENCE S4°03'56"E 55.69 FEET TO A POINT; THENCE S88°06'22"W 514.70 FEET TO A POINT; THENCE N2°57'08"E 225.21 FEET TO A POINT; THENCE N88°08'50"W 211.35 FEET TO A POINT IN THE CENTERLINE OF QUEEN ROAD; THENCE N2°57'08"E, ALONG SAID CENTERLINE, 175.69 FEET TO A POINT; THENCE S87°02'52"E 716.68 FEET TO THE POINT OF BEGINNING, CONTAINING 5.206 ACRES OF LAND.

ORDERED BY: COLDWELL BANKER—GENEVA LAKES AREA REALTORS
838 MAIN STREET
LAKE GENEVA, WISCONSIN 53147

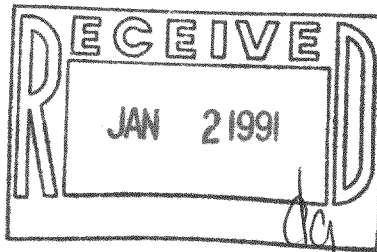

I HEREBY CERTIFY THAT I HAVE SURVEYED THE ABOVE DESCRIBED PROPERTY AND THAT THE ABOVE MAP IS A TRUE REPRESENTATION THEREOF AND SHOWS THE SIZE AND LOCATION OF THE PROPERTY, ITS EXTERIOR BOUNDARIES, THE LOCATION OF ALL VISIBLE STRUCTURES AND DIMENSIONS OF ALL PRINCIPAL BUILDINGS THEREON, BOUNDARY FENCES, APPARENT EASEMENTS, ROADWAYS AND VISIBLE ENCROACHMENTS, IF ANY, TO THE BEST OF MY KNOWLEDGE AND BELIEF.

THIS SURVEY IS MADE FOR THE USE OF THE PRESENT OWNERS OF THE PROPERTY AND ALSO THOSE WHO PURCHASE, MORTGAGE OR GUARANTEE THE TITLE THERETO WITHIN ONE (1) YEAR FROM DATE HEREOF.

Robert M. Baerenwald
ROBERT M. BAERENWALD
WISCONSIN REGISTERED LAND SURVEYOR, S-1508

March 1, 1990
DATE JOB NO. 2370

NOTE: THIS IS NOT A CERTIFIED COPY UNLESS SEALED.



SCALE IN FEET



LEGEND
S-IRON PIPE FOUND
R-IRON ROD FOUND
C-CONCRETE MONUMENT FOUND
O-IRON PIPE PLACED
D-RECORDED AS

Survey # 217-896

TAX KEY # JRG00023