


WALWORTH COUNTY
SURVEYING & MAPPING
727 HENRY STREET, LAKE GENEVA, WISCONSIN
914-248-0805

LEGEND

- Ø -IRON PIPE FOUND
- -IRON PIPE PLACED
- Ø -IRON ROD FOUND

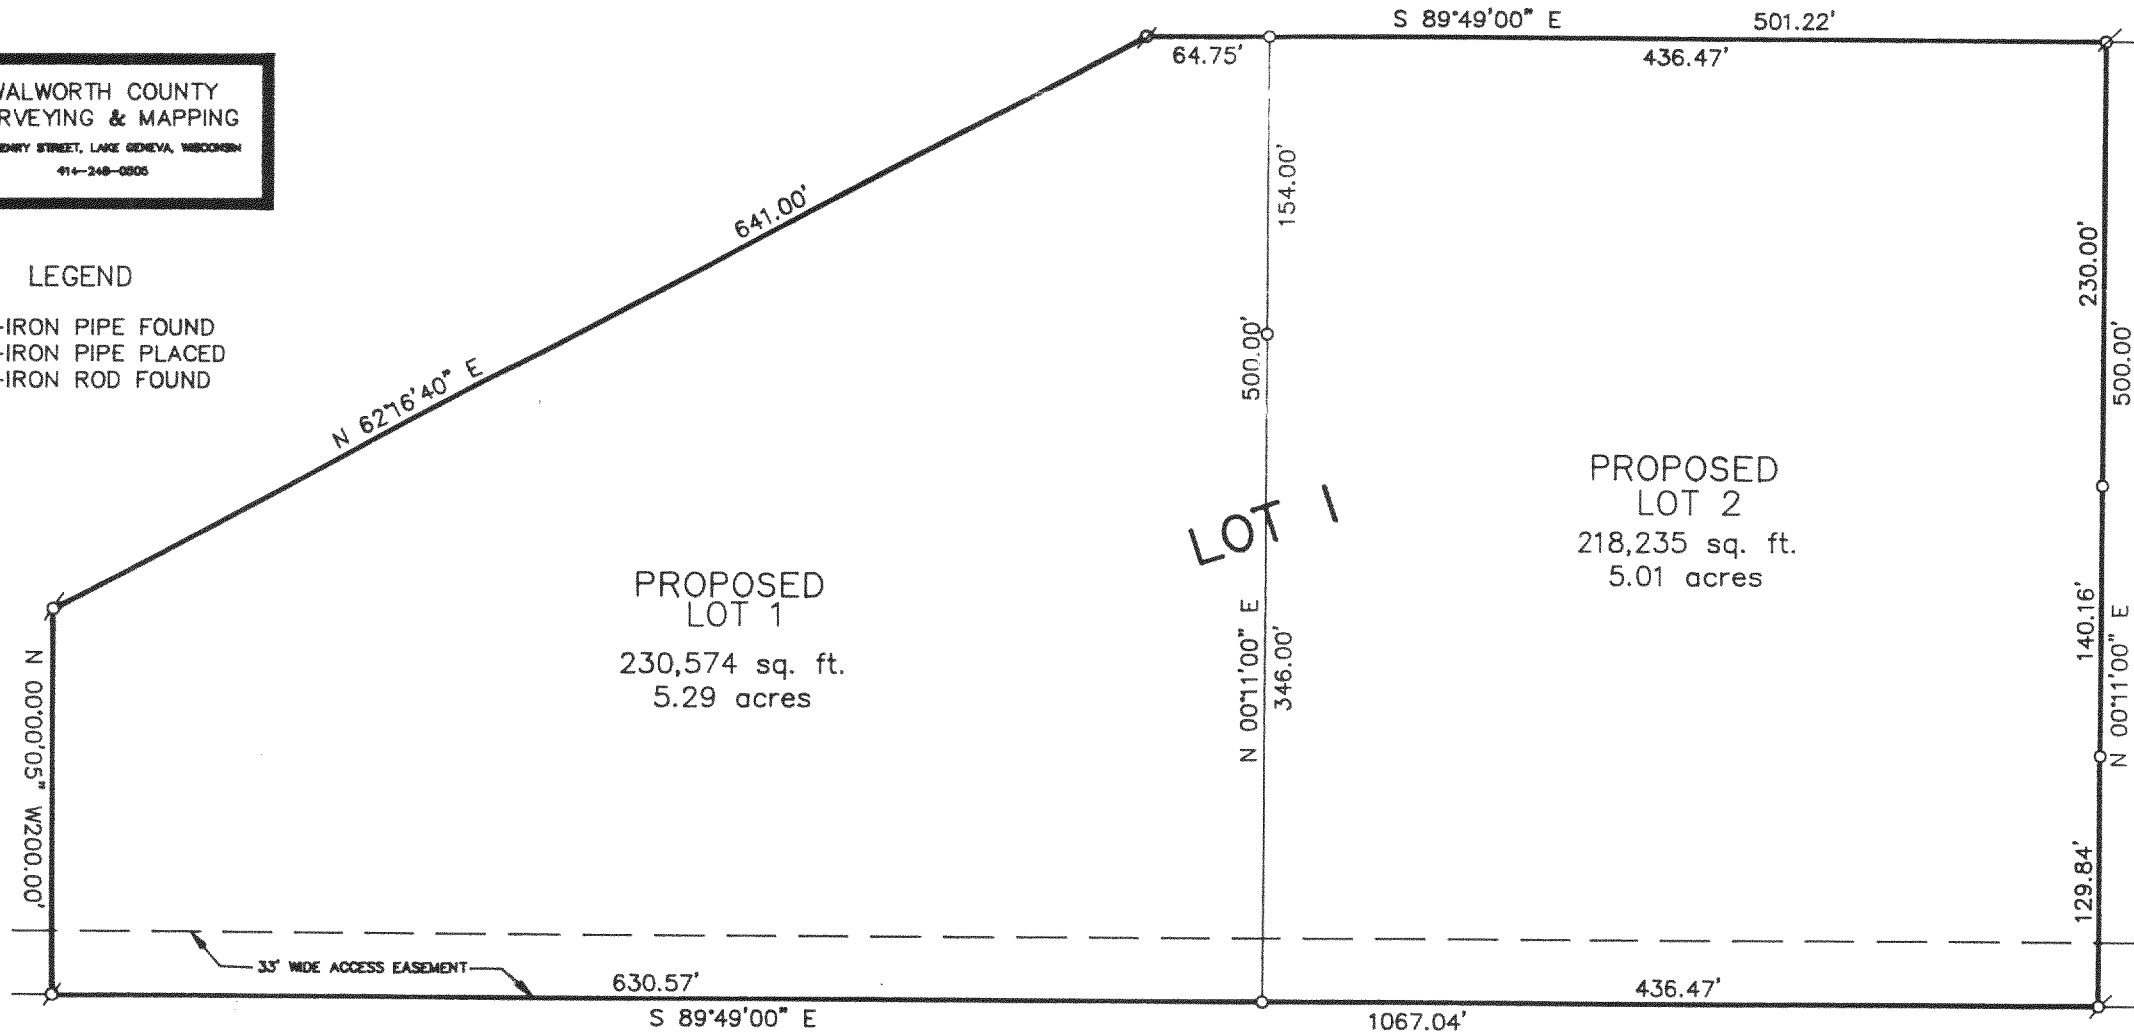

PLAT OF SURVEY OF

LOT 1 OF CERTIFIED SURVEY MAP NO. 1791,
LOCATED IN SECTION 13, T 2 N, R 17 E,
WALWORTH COUNTY, WISCONSIN.

ORDERED BY: BONNIE ALTON
LAKE GENEVA, WISCONSIN

GRAPHIC SCALE




(IN FEET)
1 inch = 100 ft.

I HEREBY CERTIFY THAT I HAVE SURVEYED THE ABOVE DESCRIBED
PROPERTY AND THAT THE ABOVE MAP IS A TRUE REPRESENTATION
THEREOF AND SHOWS THE SIZE AND LOCATION OF THE PROPERTY,
ITS EXTERIOR BOUNDARIES, THE LOCATION OF ALL VISIBLE STRUCTURES
AND DIMENSIONS OF ALL PRINCIPAL BUILDINGS THEREON, BOUNDARY
FENCES, APPARENT EASEMENTS, ROADWAYS AND VISIBLE ENCROACH-
MENTS, IF ANY, TO THE BEST OF MY KNOWLEDGE AND BELIEF.

THIS SURVEY IS MADE FOR THE USE OF THE PRESENT OWNERS OF
THE PROPERTY AND ALSO THOSE WHO PURCHASE, MORTGAGE OR
GUARANTEE THE TITLE THERETO WITHIN ONE (1) YEAR FROM DATE
HEREOF.

Robert M. Baerenwald
ROBERT M. BAERENWALD
WISCONSIN REGISTERED LAND SURVEYOR, S-1508

DATE JAN. 11, 1990
JOB NO. 2192

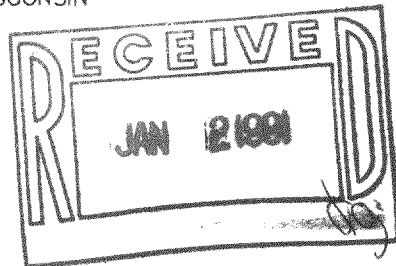

Survey # 217-897

TAX KEY JA 179100001
179100002