


WALWORTH COUNTY
SURVEYING & MAPPING
LAKE GENEVA, WISCONSIN

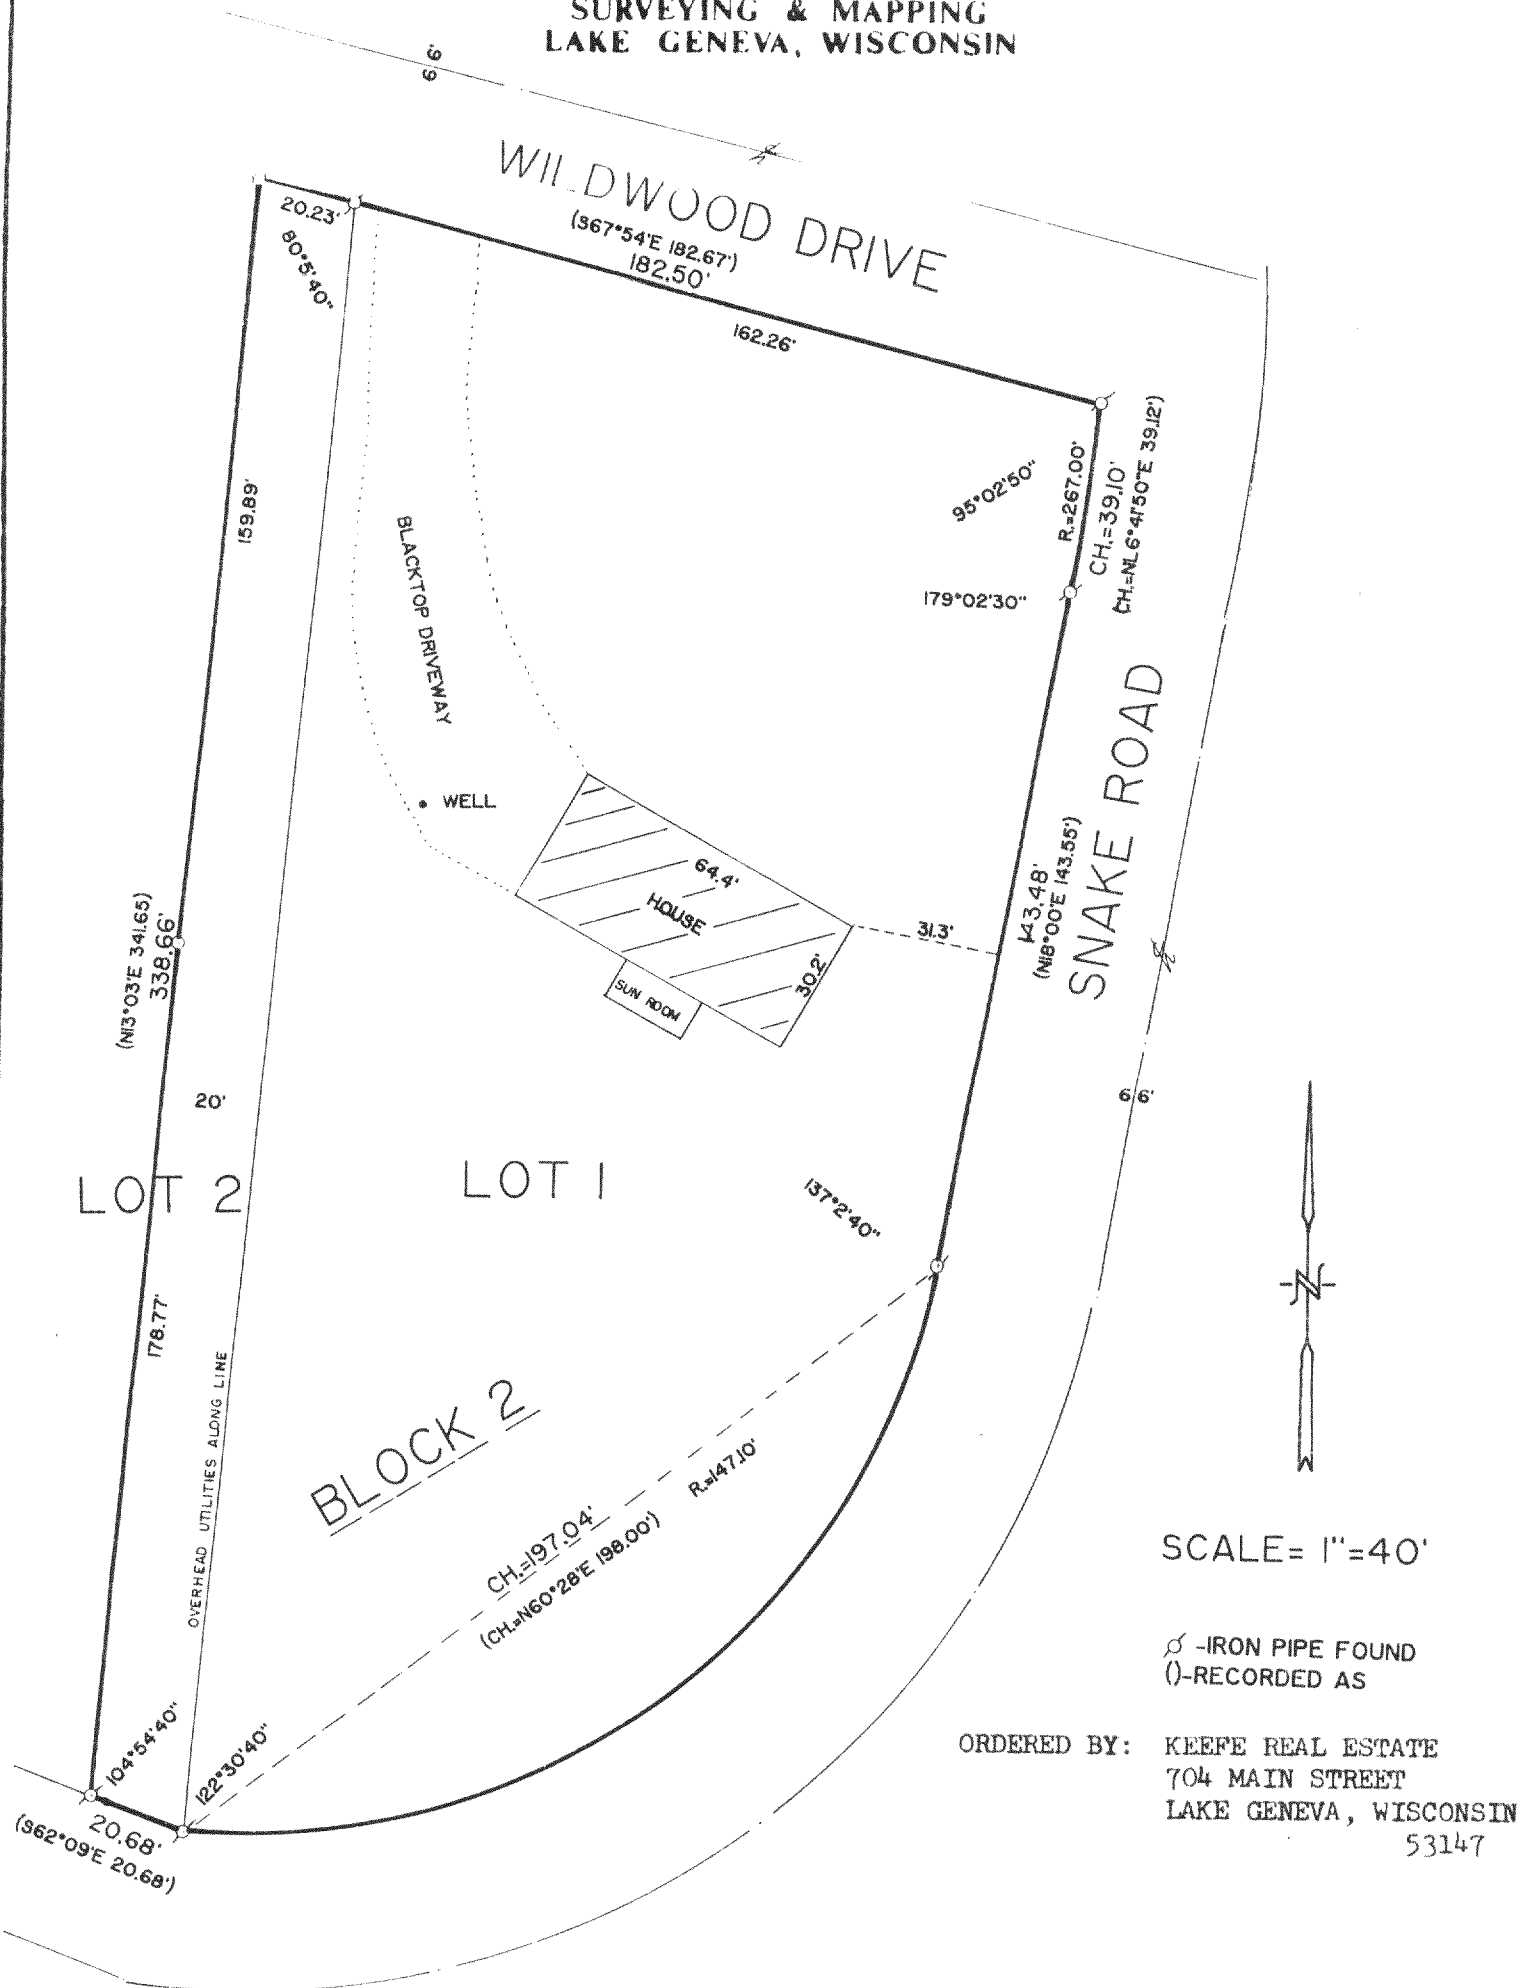


PLAT OF SURVEY OF

LOT 1 AND THE EAST 20 FEET OF LOT
2, BLOCK 2 OF GENEVA BAY ESTATES,
LOCATED IN T 2 N, R 17 E, WALWORTH
COUNTY, WISCONSIN.

THEREBY CERTIFY THAT I HAVE SURVEYED THE ABOVE DESCRIBED PROPERTY AND THAT THE ABOVE
MAP IS A TRUE REPRESENTATION THEREOF AND SHOWS THE SIZE AND LOCATION OF THE PROPERTY.
THESE NOTES DESCRIBE THE LOCATION OF ALL VISIBLE 'IRON PIPES' AND 'ELECTRIC LINES' IN ALL
PRINCIPAL BUILDINGS THEREON, BOUNDARY FENCES, APPARENT EASEMENTS AND ROADWAYS AND
VISIBLE ENCROACHMENTS, IF ANY.

THIS SURVEY IS MADE FOR THE EXCLUSIVE USE OF THE PRESENT OWNERS OF THE PROPERTY, AND
ALSO THOSE WHO PURCHASE, MORTGAGE, OR GUARANTEE THE TITLE THERE TO WITHIN ONE (1) YEAR
FROM DATE HEREOF.

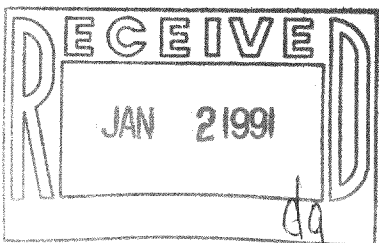

Robert M. Baerenwald
ROBERT M. BAERENWALD
WISCONSIN REGISTERED LAND SURVEYOR, S-1508

DATE *Aug. 30, 1989* JOB NO. 2045

NOTE: THIS IS NOT A CERTIFIED COPY UNLESS SEALED.

Survey # 217-898

TAX KEY # JGBE 00029