


N

Woodland Drive (40' Wide)

Legend
° - Iron Pipe


Kale Road (40' Wide)

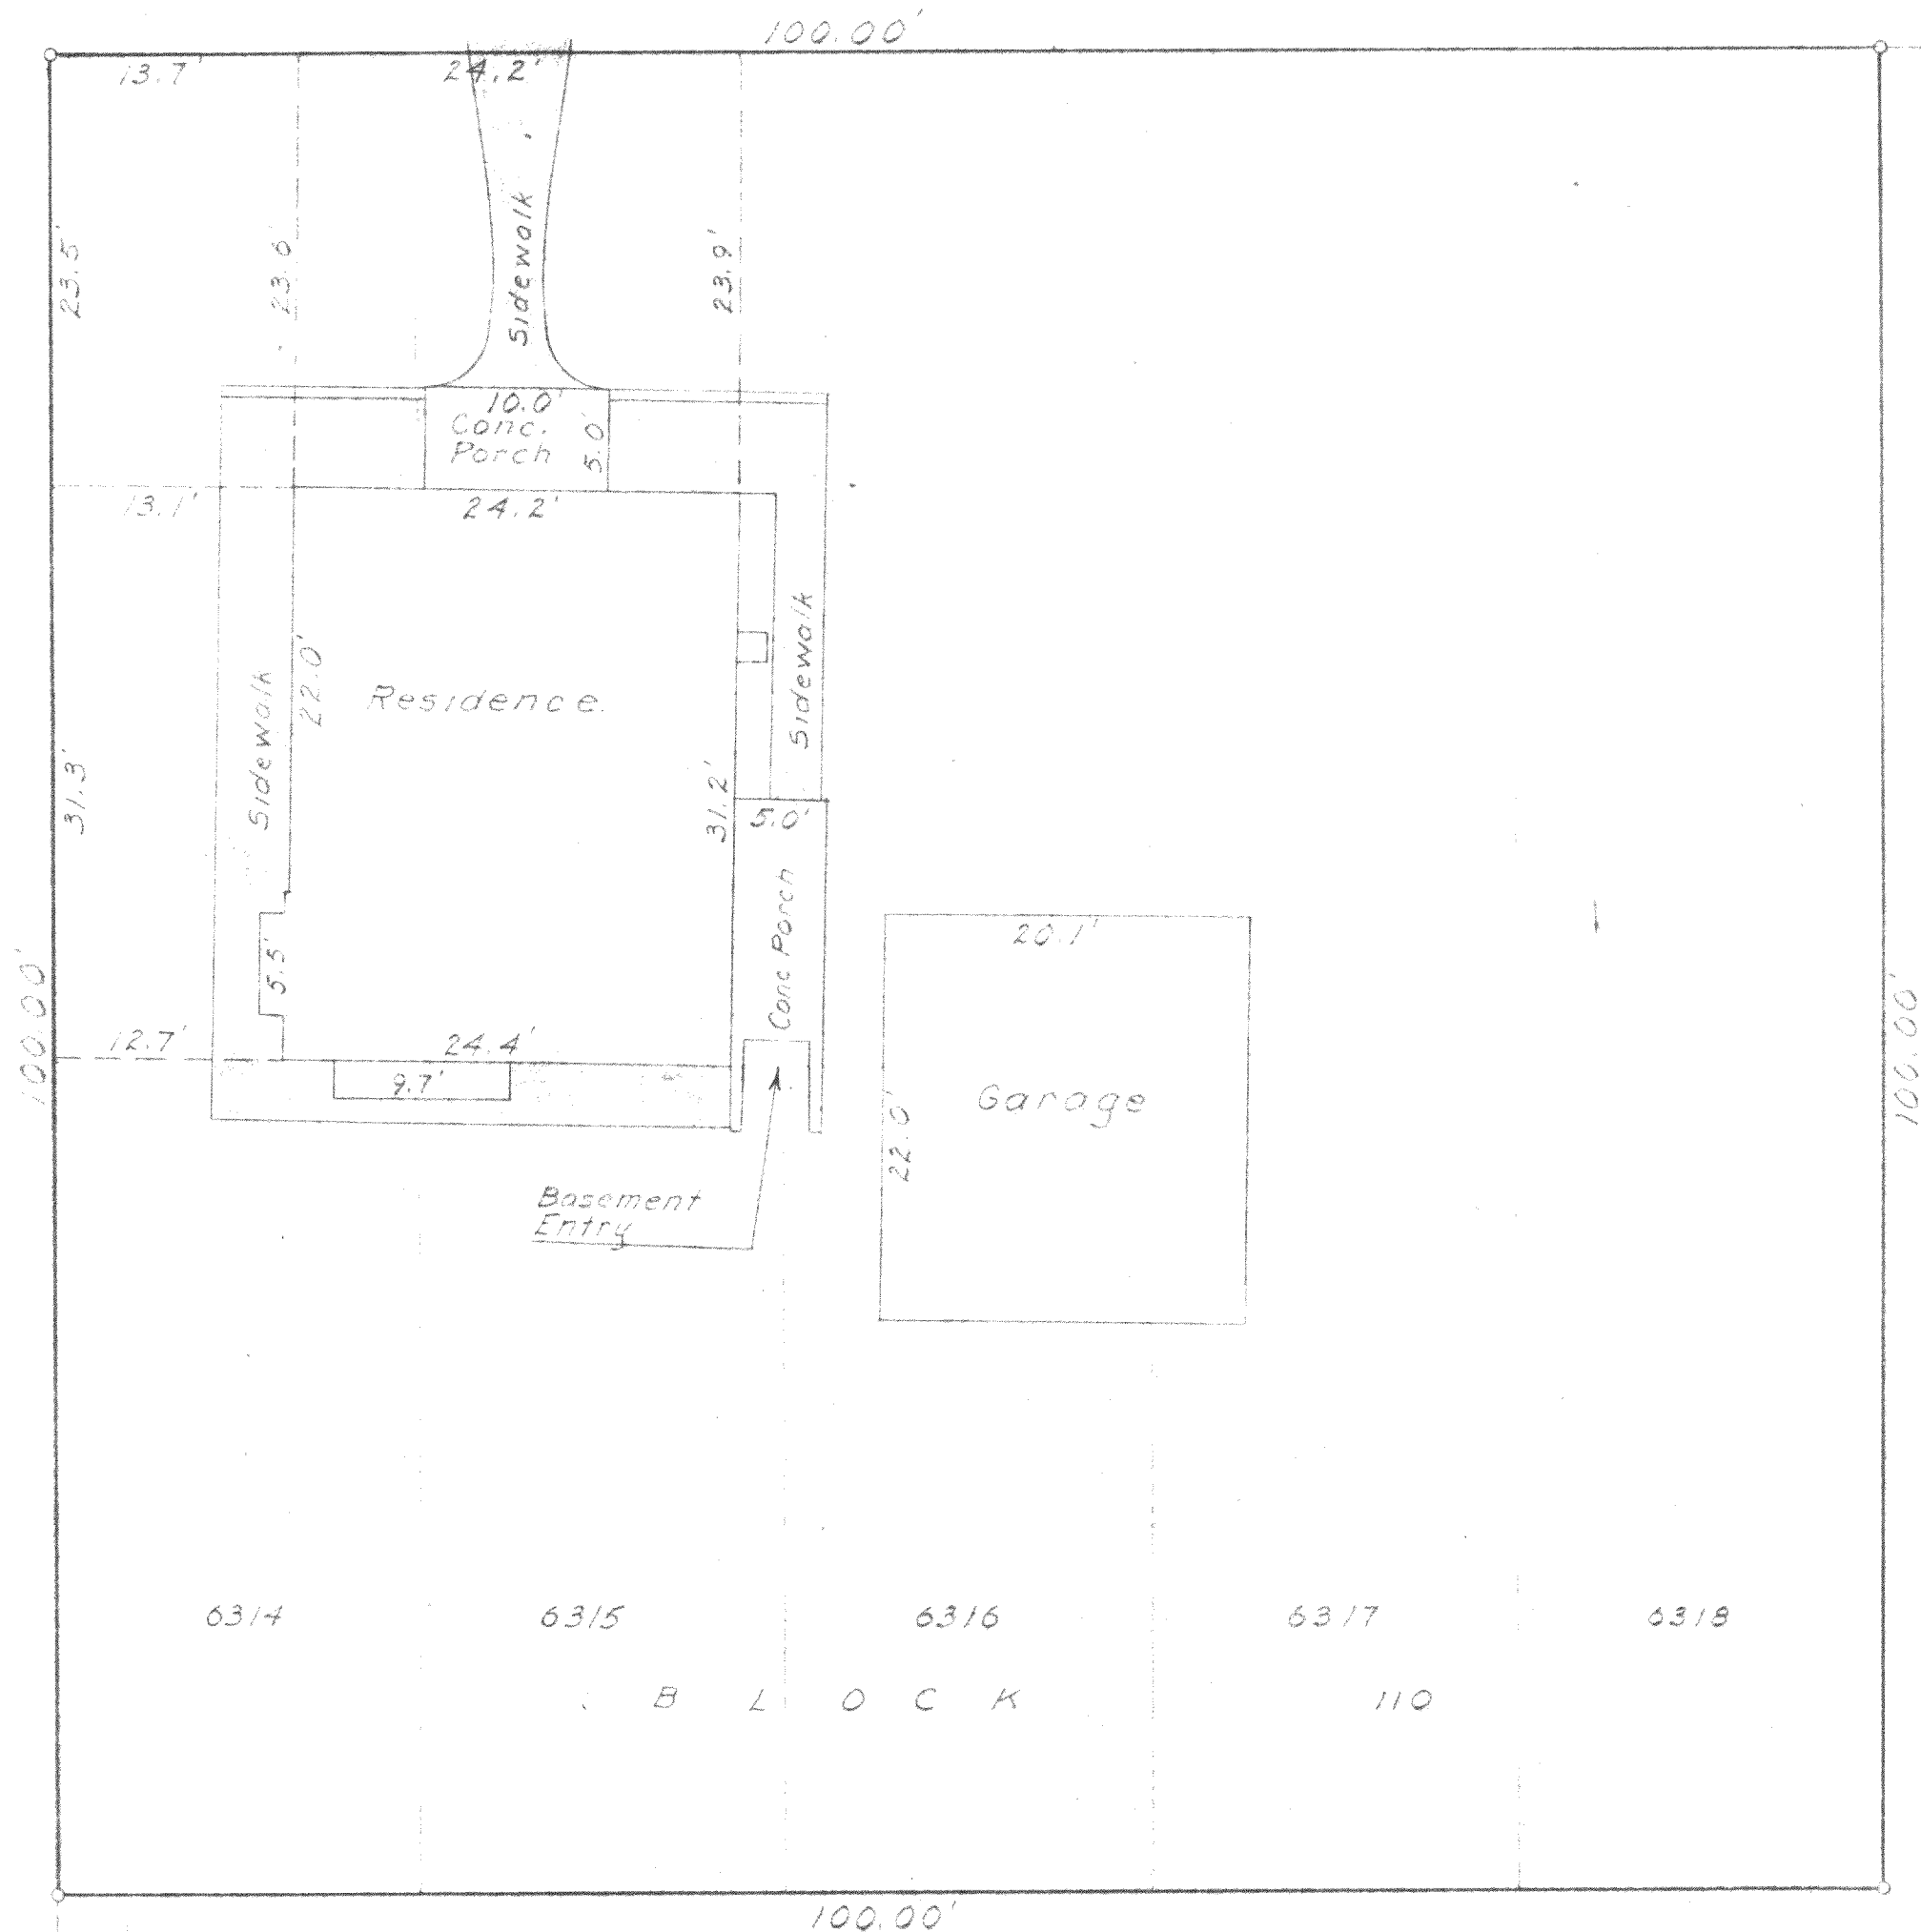

I certify that I have surveyed the above described property and that the above plat is an accurate survey and a true representation thereof and correctly shows the exterior boundary lines and location of buildings and other improvements on said property and the correct measurements thereof.

Dated, this 6th day of June, 1961.

Lloyd L. Jensen
Lloyd L. Jensen, Surveyor

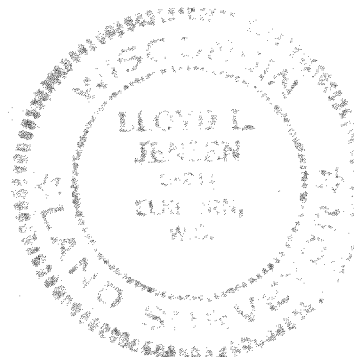

PLAT OF SURVEY
OF
Lots 6314 - 6318, Block 110, Lake Como Beach, located in Section 28, T2N, R17E, Walworth County, Wisconsin.

Lloyd L. Jensen
SURVEYOR

SCALE 1" = 10'

DATE June 1961

JLLB-1309