


GEORGE T. DUNHAM
SURVEYING & SUBDIVIDING
DELAVER, WISCONSIN

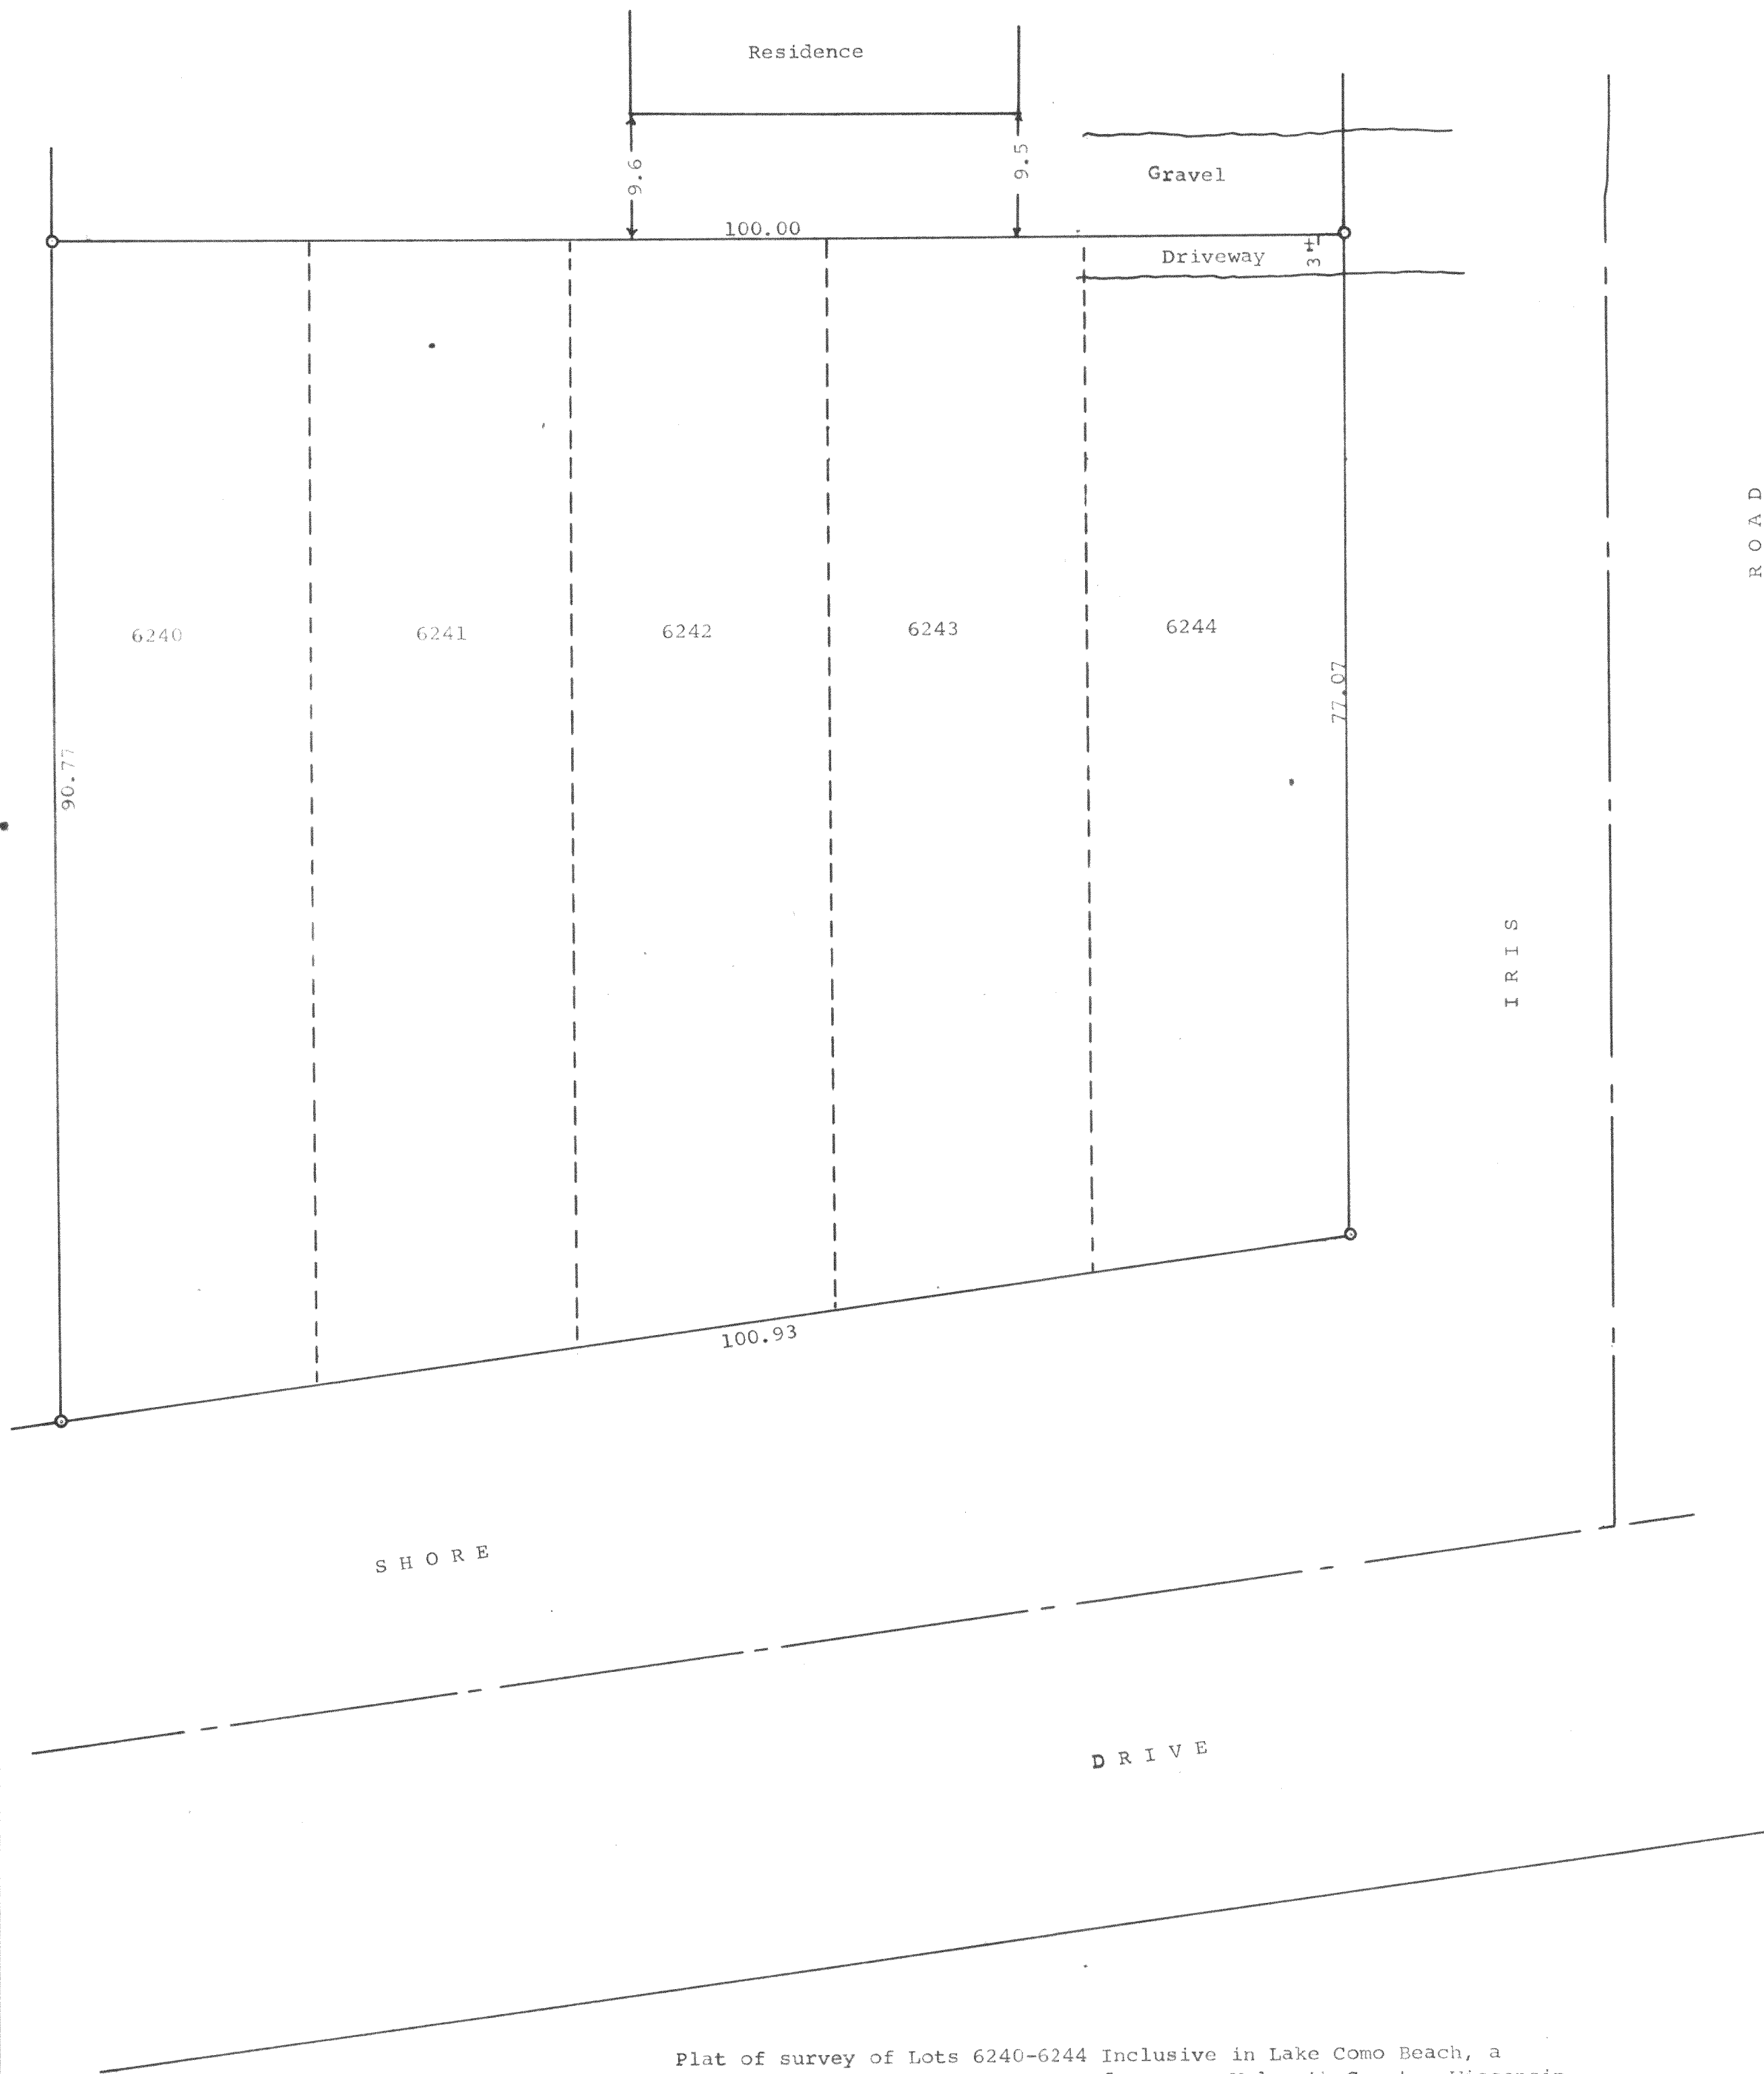

Scale - 1" = 10'
● = Iron Pipe

Plat of survey of Lots 6240-6244 Inclusive in Lake Como Beach, a
Subdivision located in the Town of Geneva, Walworth County, Wisconsin.
July 22, 1966

George T. Dunham
George T. Dunham, Surveyor