

Farris, Hansen & Associates, Inc.

Engineering, Surveying & Land Planning

P.O. BOX 487

715 W. WALWORTH STREET

ELKHORN, WISCONSIN 53121

PLAT OF SURVEY OF LOTS 12099 - 12108 OF
BLOCK 216 OF LAKE COMO BEACH SUBDIVISION TOWN OF
GENEVA, WALWORTH COUNTY, WISCONSIN

Longfellow Dr.

EAST LINE BLOCK 216
ASSIGNED N 00° 20' 04" E

1" = 40'


• IRON PIPE FOUND
• IRON PIPE SET
• IRON RE-BAR SET
(XXX) RECORD DIMENSION

▽ SET NAIL

• IRON REBAR FOUND

WORK ORDERED BY:
RICHARD WALD
RT. 2 BOX 449-9W
LAKE GENEVA, WISCONSIN


Dandelion Rd.

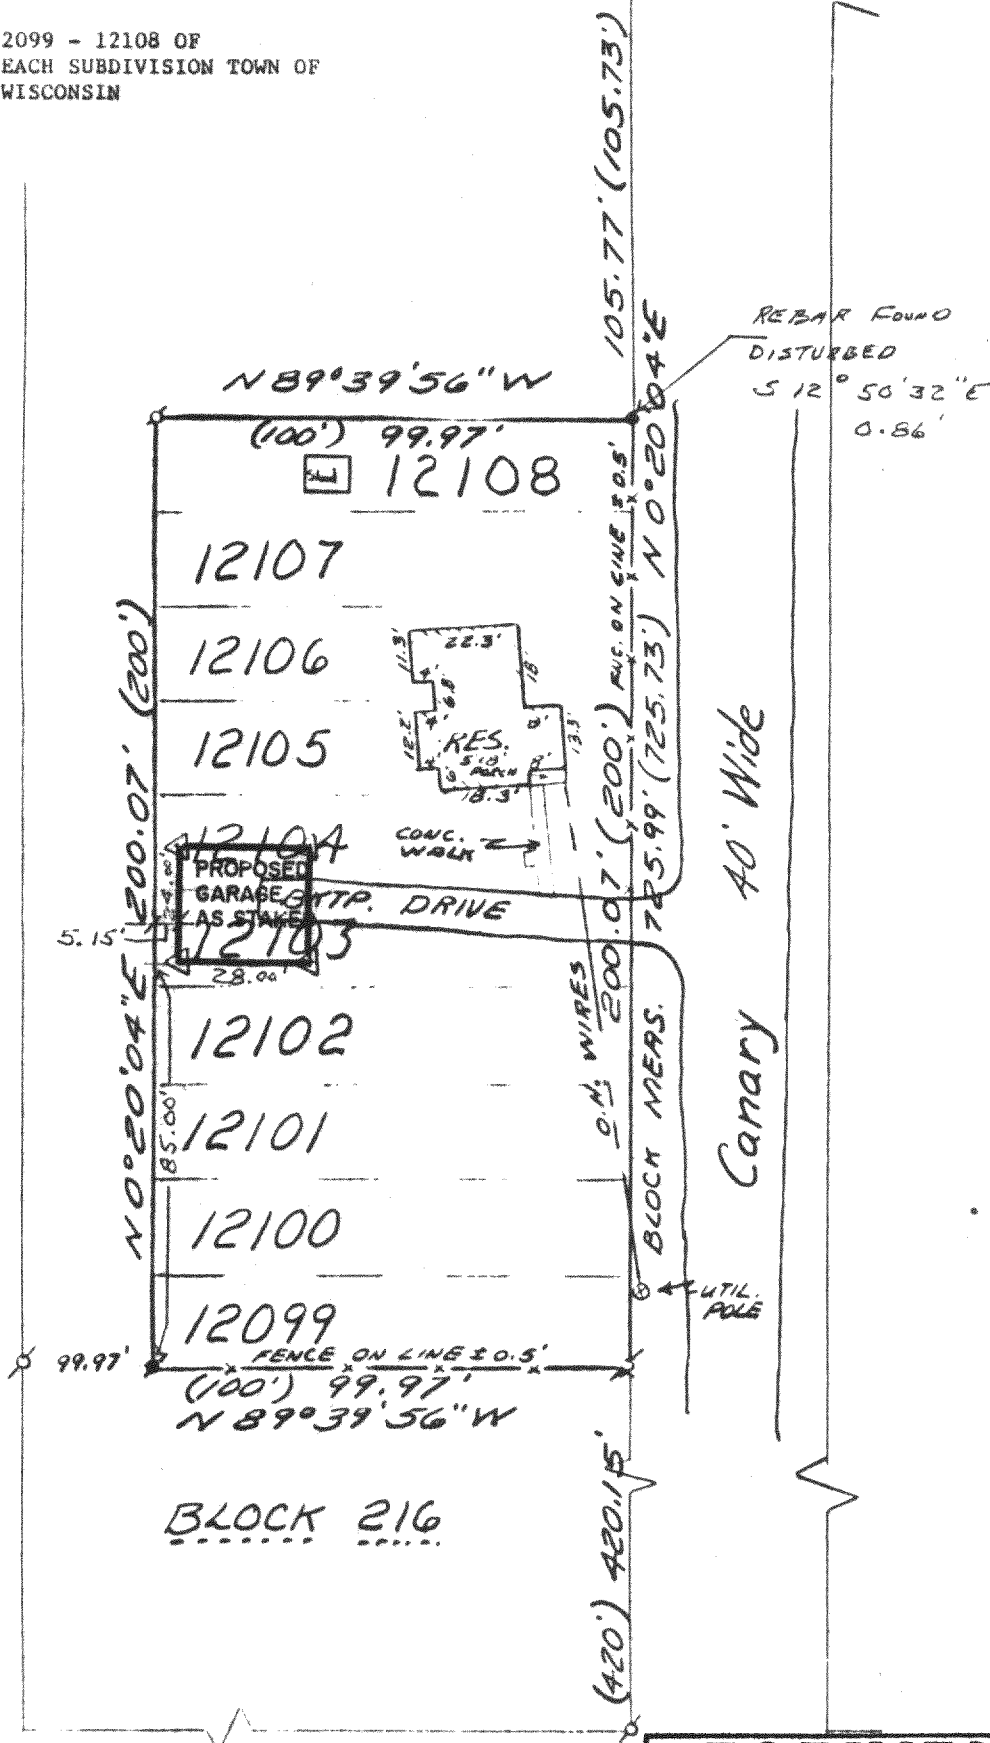

BLOCK 216

Whittier Drive

Drive

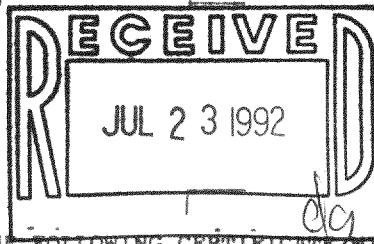


NOTE: COPIES OF THIS MAP TO WHICH THE FOLLOWING CERTIFICATE WILL APPLY ARE BLUE LINE PRINTS SHOWING SURVEYOR'S ORIGINAL SEAL AND SIGNATURE IN BLACK INK. COPIES BY ANY OTHER MEANS MAY HAVE ALTERATIONS WHICH DO NOT REPRESENT THE SURVEYOR'S WORK PRODUCT.

I HEREBY CERTIFY THAT THIS PLAT OF SURVEY IS A TRUE AND ACCURATE REPRESENTATION OF THE BOUNDARY LINES OF THE SUBJECT PARCEL AND SHOWS THE SIZE AND LOCATION OF THE PROPOSED BUILDING AS STAKED ON THE PARCEL SHOWN HEREON, TO THE BEST OF MY PROFESSIONAL KNOWLEDGE AND BELIEF. THIS SURVEY IS MADE FOR THE USE OF THE PRESENT OWNERS OF THE PROPERTY, AND ALSO THOSE WHO PURCHASE, MORTGAGE, OR GUARANTEE THE TITLE THERETO WITHIN ONE YEAR FROM THE DATE HEREOF.

DATED: JULY 1, 1992

Peter S. Gordon
PETER S. GORDON RLS 2101

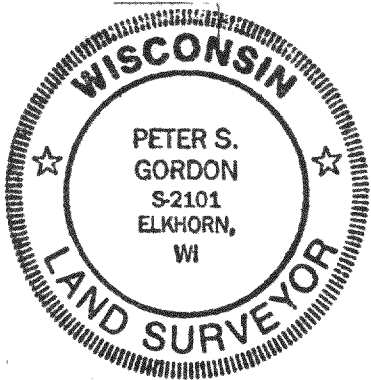

217-990

JLCS-2632