


SURVEYING & SUBDIVIDING
DELAN, WISCONSIN 53115

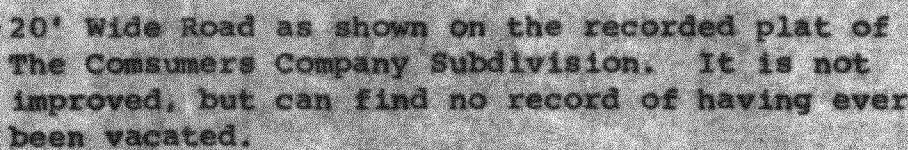

7

X = Cross on concrete found

$\phi = 3/4"$ Iron Pipe Found

Q = 1 1/4" Iron Pipe Found

o = 1½" X 24" Iron Pipe Set

• = 3/4" Iron Pipe Found 1 1/2' below ground. Set 1 1/2" Iron Pipe above, at ground level

Ø = 3/4" X 24" Iron Pipe Set

Bearings referenced to the southwesterly line of Lot 81 with the assumed bearing of N49°44'W.

Survey ordered by:

Marilyn Chapman

2316 South 8th Avenue

North Riverside, IL 60546

described as follows:

[illegible]

(continued)

Beginning at the southwest corner of Lot 81 of Consumers Company Subdivision; thence S44°49'E along the southerly extension of the southwesterly line of said Lot 81, 20.00 feet to the place of beginning; thence continue S44°49'E 70.00 feet; thence northeasterly parallel to the north line of the railroad right of way 63.78 feet to a point located in the southeasterly extension of the northeasterly line of said Lot 81; thence N49°11'12"W 70.00 feet to a point located 20.00 feet S49°11'12"E of the southeast corner of said Lot 81; thence southwesterly along the northerly line of said railroad property, to the place of beginning. SUBJECT TO A 40 foot right of way across the southerly 40 feet of the above described property.

September, 1990

George T. Dunham, Surveyor

