

KOLB LAND CONSULTING, INC.
 LAND SURVEYING · SUBDIVIDING · LAND PLANNING


929 WILLIAMS STREET LAKE GENEVA, WISCONSIN 53147 414-240-3697

PLAT OF SURVEY OF

LOT 2 OF CERTIFIED SURVEY MAP NO. 1378, LOCATED IN THE NORTHEAST 1/4 OF SECTION 26 AND THE SOUTHEAST 1/4 OF SECTION 23, T2N, R17E, TOWN OF GENEVA, WALWORTH COUNTY, WISCONSIN.

NOTE: BEARINGS ARE REFERENCED TO THE WISCONSIN COORDINATE SYSTEM-SOUTH ZONE.


ORDERED BY: SILVANO STEFANI
 101 BROAD STREET
 LAKE GENEVA WI 53147

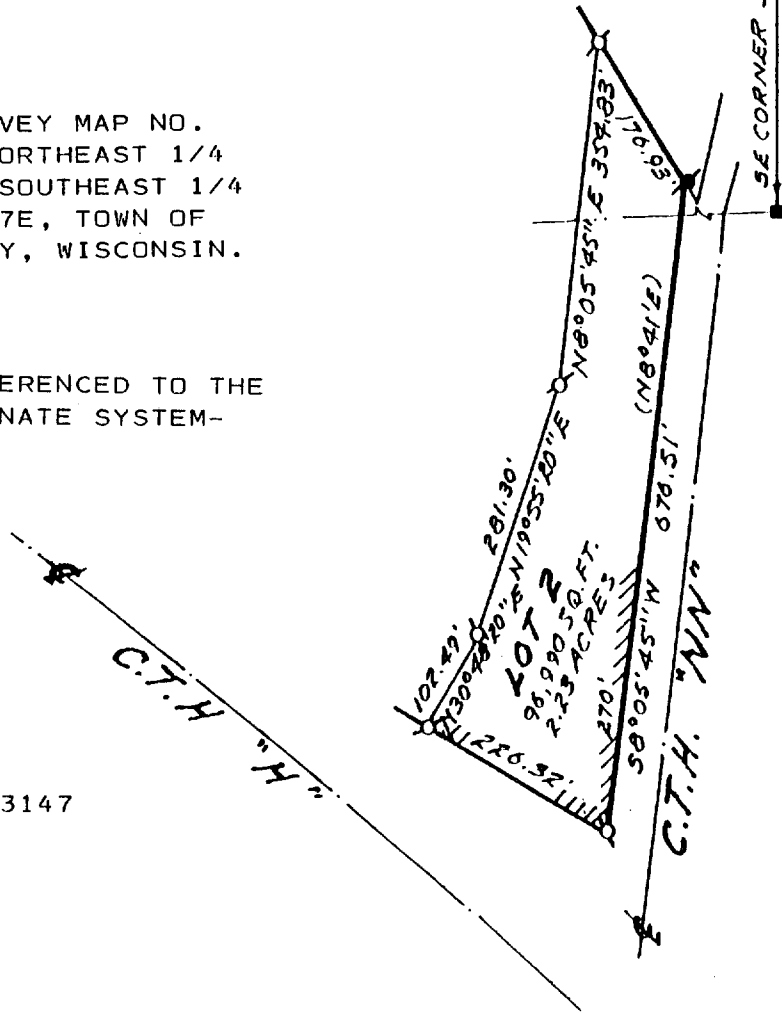

SCALE: 1" = 200'

LEGEND

- ♁ - IRON PIPE FOUND
- - CONC. RIGHT-OF-WAY POST FOUND

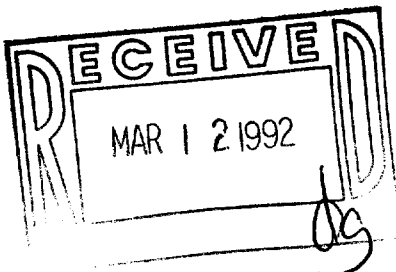

I HEREBY CERTIFY THAT I HAVE SURVEYED THE ABOVE DESCRIBED PROPERTY AND THAT THE ABOVE MAP IS A TRUE REPRESENTATION THEREOF AND SHOWS THE SIZE AND LOCATION OF THE PROPERTY, ITS EXTERIOR BOUNDARIES, THE LOCATION OF ALL VISIBLE STRUCTURES AND DIMENSIONS OF ALL PRINCIPAL BUILDINGS THEREON, BOUNDARY FENCES, APPARENT EASEMENTS, ROADWAYS AND VISIBLE ENCROACHMENTS, IF ANY, TO THE BEST OF MY KNOWLEDGE AND BELIEF.

THIS SURVEY IS MADE FOR THE USE OF THE PRESENT OWNERS OF THE PROPERTY AND ALSO THOSE WHO PURCHASE, MORTGAGE OR GUARANTEE THE TITLE THERETO WITHIN ONE (1) YEAR FROM DATE HEREOF.
 THIS SURVEY IS NOT VALID UNLESS THE SURVEYOR'S SIGNATURE IS IN RED.

HAROLD H. KOLB
 WISCONSIN REGISTERED LAND SURVEYOR. S-187
 DATE: OCTOBER 22, 1991
 REVISE: _____