



217-3066

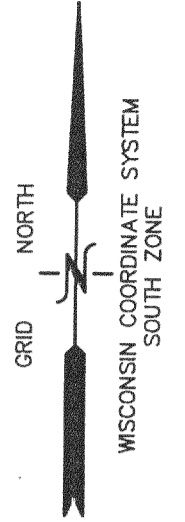

PLAT OF SURVEY
 UNIT 33-02
 GENEVA NATIONAL CONDOMINIUM NO. 33
 LOCATED IN PART OF THE NE 1/4 OF THE NE 1/4 OF
 SECTION 30, TOWN 2 NORTH, RANGE 17 EAST,
 WALWORTH COUNTY, WISCONSIN

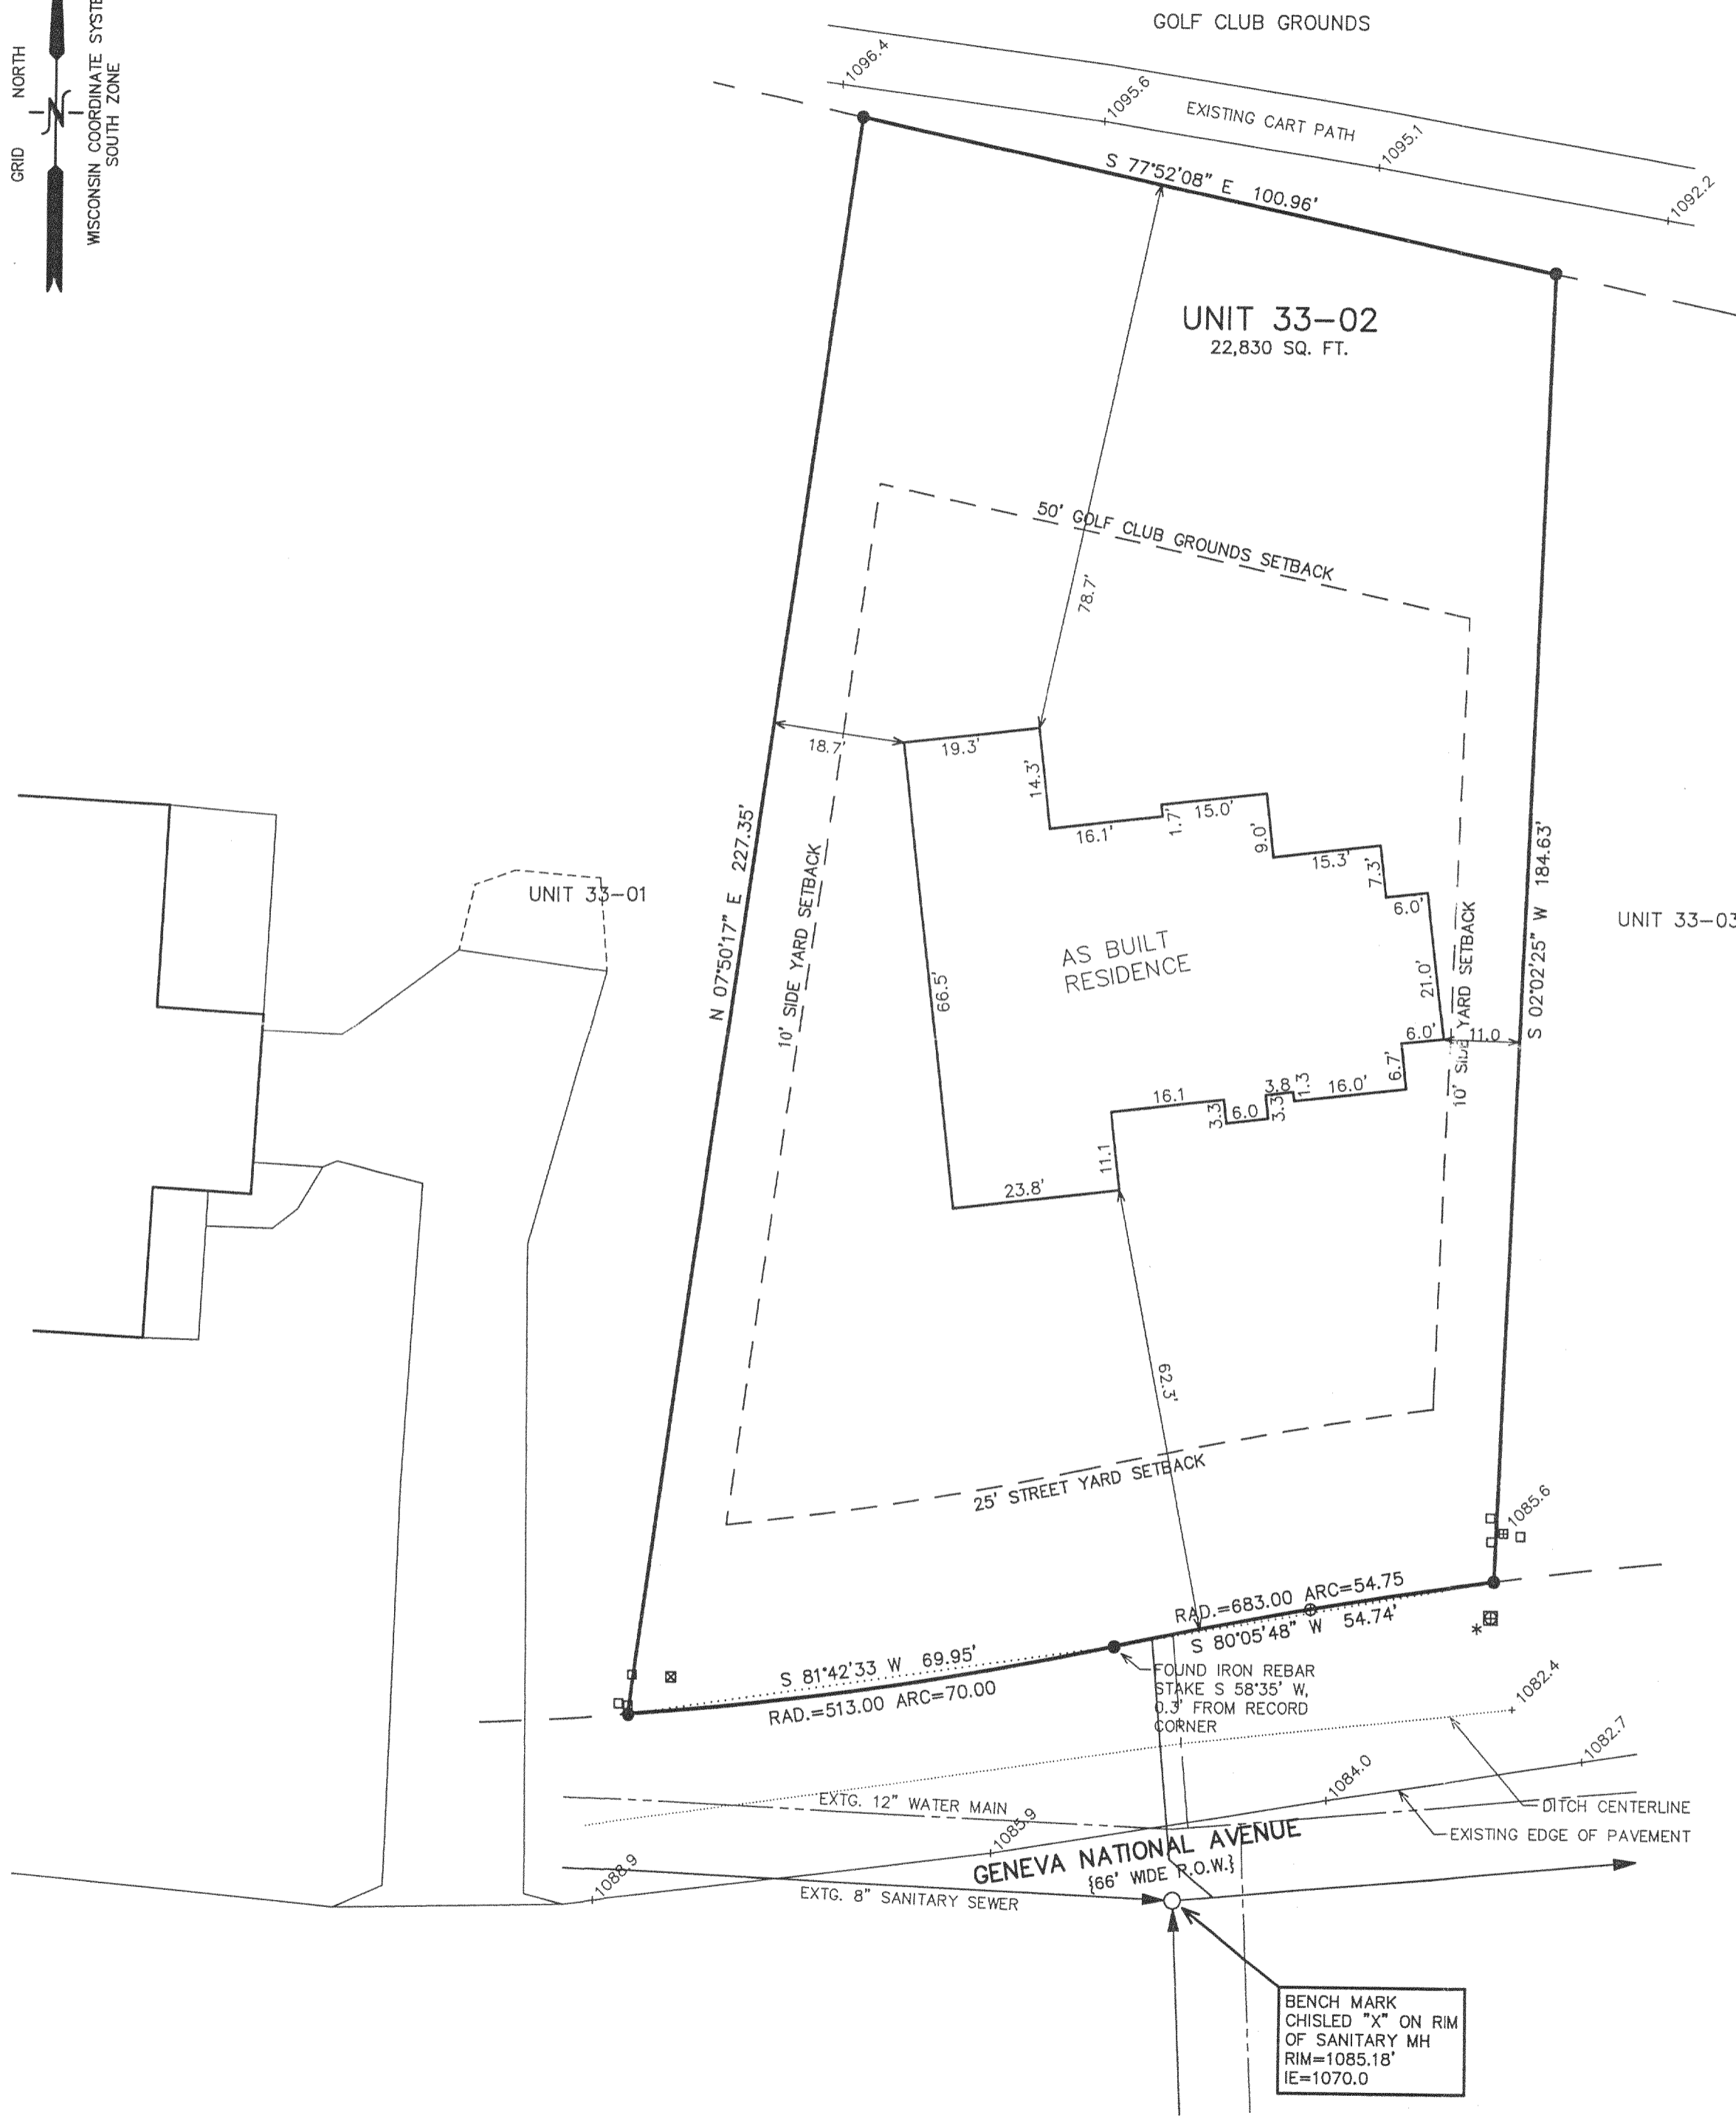

- LEGEND
- = FOUND IRON REBAR STAKE
 - = UTILITY BOX LOCATED
 - ⊠ = TRANSFORMER LOCATED
 - * = FIBER OPTIC WARNING POST LOCATED
 - ⊕ = VALVE LOCATED
 - ⊞ = IRRIGATION CONTROL VALVE LOCATED
 - {XXX} = RECORDED AS


NOTE: COPIES OF THIS MAP TO WHICH THE FOLLOWING CERTIFICATE WILL APPLY SHOW THE SURVEYOR'S ORIGINAL SEAL AND SIGNATURE IN RED INK. COPIES BY ANY OTHER MEANS MAY HAVE ALTERATIONS WHICH DO NOT REPRESENT THE SURVEYOR'S WORK PRODUCT.

I HEREBY CERTIFY THAT THE ABOVE DESCRIBED PROPERTY HAS BEEN SURVEYED UNDER MY DIRECTION AND THAT THE ABOVE MAP IS A TRUE REPRESENTATION THEREOF AND SHOWS THE SIZE AND LOCATION OF THE PROPERTY AND ITS EXTERIOR BOUNDARIES. THIS SURVEY IS MADE FOR THE USE OF THE PRESENT OWNERS OF THE PROPERTY, AND ALSO THOSE WHO PURCHASE, MORTGAGE, OR GUARANTEE THE TITLE THERETO WITHIN ONE YEAR FROM THE DATE HEREOF.

DATED: SEPTEMBER 1, 2004

REVISED 05-24-2005 TO SHOW SIZE & LOCATION OF AS BUILT FOUNDATION

Peter S. Gordon
 PETER S. GORDON R.L.S. 2101

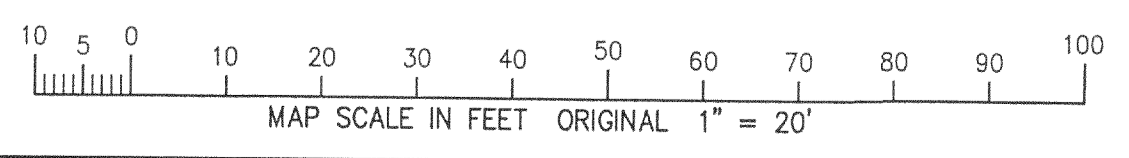

5/24/2005 X:\Projects\3269\COND00_33\UNIT_02\DCAD\REV\SGDECP

WORK ORDERED BY -
 SPRAUER BUILDERS, INC.
 2920 DUFFY LANE
 RIVERWOODS, IL 60015

FARRIS, HANSEN & ASSOCIATES, INC.
 ENGINEERING - ARCHITECTURE - SURVEYING
 7 RIDGWAY COURT P.O. BOX 437
 ELKHORN, WISCONSIN 53121
 OFFICE: (262) 723-2098 FAX: (262) 723-5866

REVISIONS

01/06/2005
 SITE, GRADING,
 DRAINAGE, &
 EROSION
 CONTROL PLAN

PROJECT NO.
 3269.33-02

DATE:
 08/31/2004

SHEET NO.
 1 OF 1

10/1/2005