


PROJECT NO.	3269.10.05
DATE	11/15/2006
SHEET NO.	1 OF 1


REVISIONS
7/16/2007-KB REVISED PROPOSED RESIDENCE SIZE AND LOCATION
7/23/2007 - LK ADVANCE PLAN
7-27-2007 PSG ADD NOTES

FARRIS, HANSEN & ASSOCIATES, INC.
ENGINEERING - ARCHITECTURE - SURVEYING
7 RIDGWAY COURT P.O. BOX 437
ELKHORN, WISCONSIN 53121
OFFICE: (262) 723-2098
FAX: (262) 723-5886

— WORK ORDERED BY —
GEORGE ADAMS
PO BOX 379
FONTANA, WI. 53125

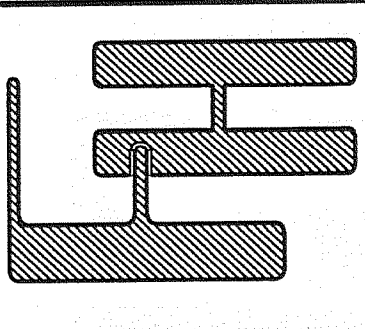

PLAT OF SURVEY
UNIT 10-05
GENEVA NATIONAL CONDOMINIUM
NO. 10
LOCATED IN TOWN 2 NORTH, RANGE 17 EAST
WALWORTH COUNTY, WISCONSIN

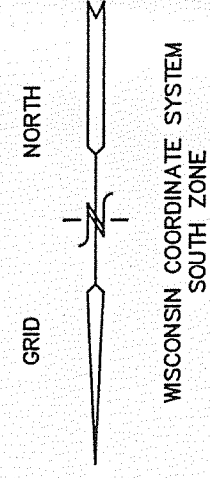


NOTE: COPIES OF THIS MAP TO WHICH THE FOLLOWING CERTIFICATE WILL APPLY SHOW THE SURVEYOR'S ORIGINAL SEAL AND SIGNATURE IN RED INK. COPIES BY ANY OTHER MEANS MAY HAVE ALTERATIONS IN RED INK, WHICH DO NOT REPRESENT THE SURVEYOR'S WORK PRODUCT.

I HEREBY CERTIFY THAT THE ABOVE DESCRIBED PROPERTY HAS BEEN REPRESENTED UNDER MY DIRECTION AND THAT THE ABOVE MAP IS A TRUE REPRESENTATION THEREOF AND SHOWS THE SIZE AND LOCATION OF THE PROPERTY AND ITS EXTERIOR BOUNDARIES. THIS SURVEYOR HAS ALSO THOSE WHO PURCHASE, MORTGAGE, OR GUARANTEE THE TITLE THERETO WITHIN ONE YEAR FROM THE DATE HEREOF.

DATED: NOVEMBER 15, 2006

PETER S. GORDON R.L.S. 2101

REVISED 08-23-2007
TO SHOW SIZE & LOCATION OF
AS BUILT FOUNDATION

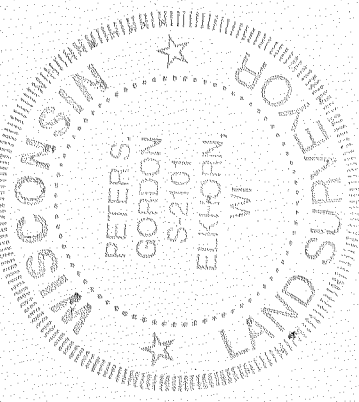

NOTE: BASEMENT SEWER TO REQUIRE
BASEMENT GRINDER PUMP WITH ALL
WASTEWATER PUMPED UP TO GRAVITY
SERVICE CONNECTION POINT

--LIMITED BUILDING BOX

LEGEND

☐ = SET IRON REBAR STAKE

● = FOUND IRON REBAR STAKE

{XXX} = RECORDED AS

LINE	BEARING	DISTANCE
L1	N 44°47'28" W	40.81
L2	N 87°39'13" W	76.23

GENERAL LOCATION OF 8' UNPAVED
WALKWAY EASEMENT
TO BE FIELD SELECTED FOR
ROUTE BY DECLARANT (CENTERLINE
TRAIL TO BECOME CENTERLINE
OF EASEMENT AFTER
CONSTRUCTION) PATH MAY RUN
OFF SITE ONTO CLUB COTTAGES
OR HIGHLANDS (MAY BE ALTERED)

CONDOMINIUM NO. 8
HIGHLANDS

UNIT 10-06

BOUNDARY DETAIL
SCALE: 1"=100'