
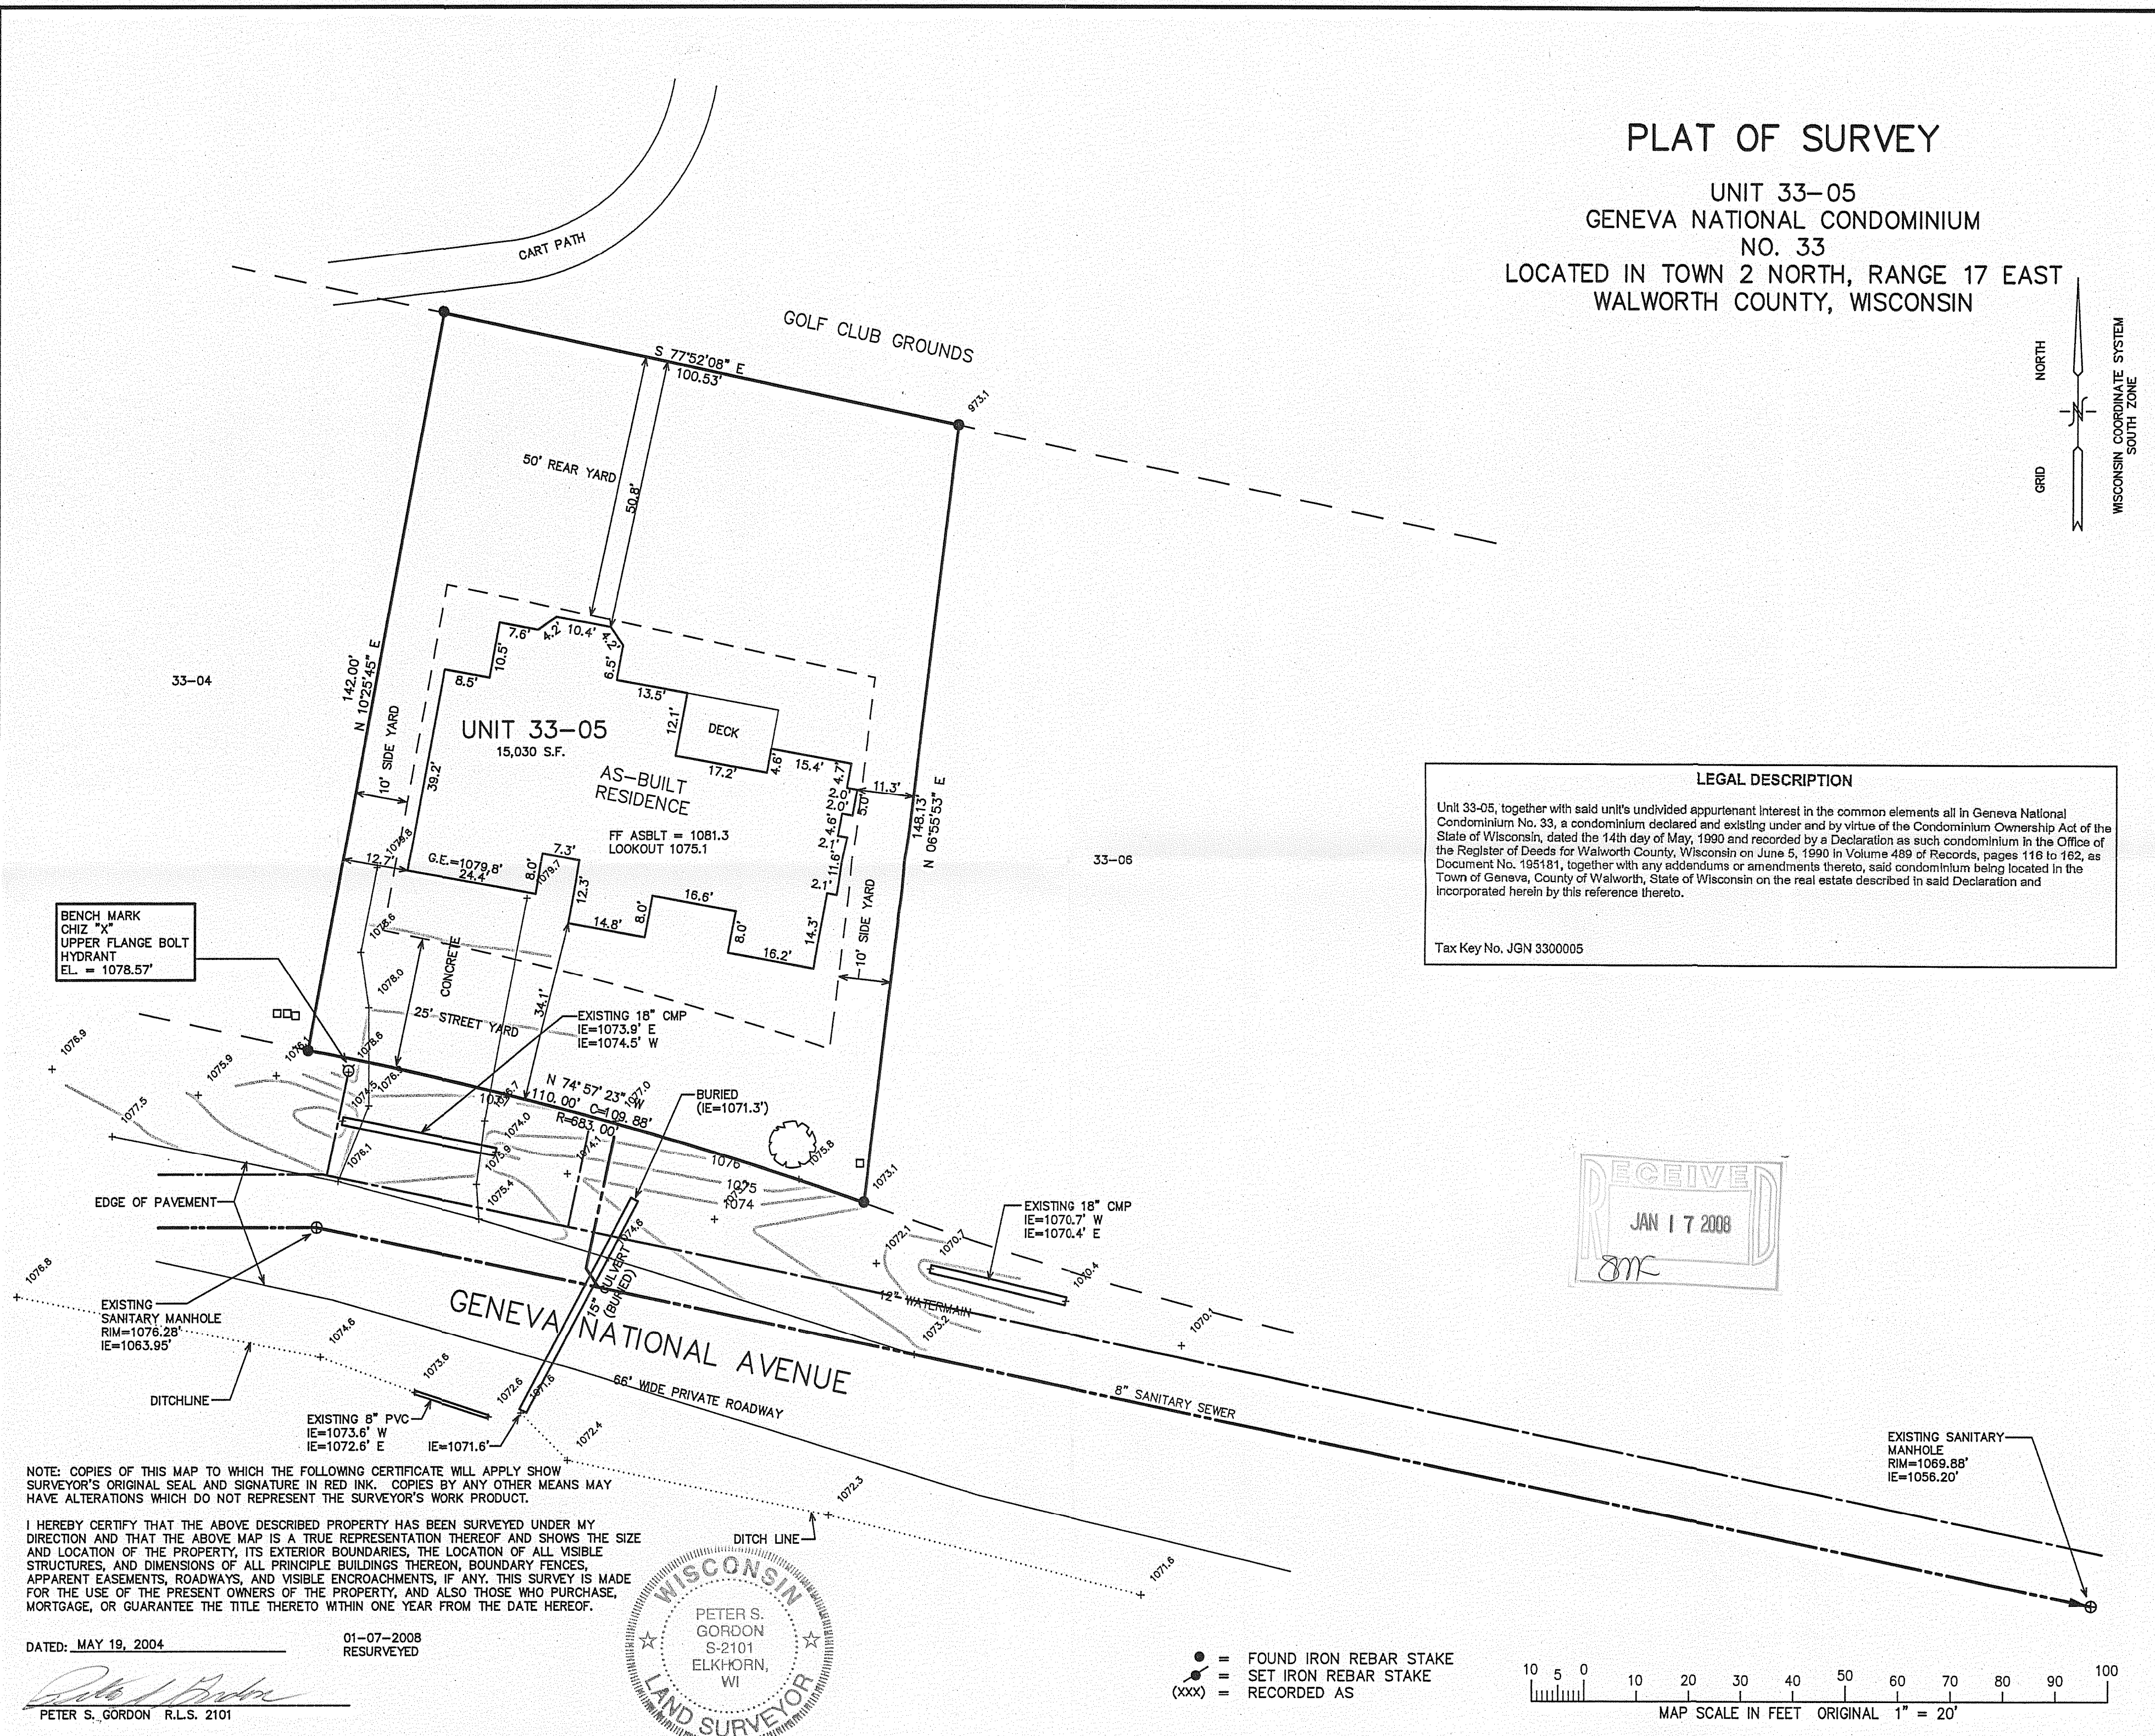


ORDERED BY MTM & SONS CONST.
1772 WOODLAND CIRCLE
LAKE GENEVA, WI. 53147

PLAT OF SURVEY


UNIT 33-05
GENEVA NATIONAL CONDOMINIUM
NO. 33
LOCATED IN TOWN 2 NORTH, RANGE 17 EAST
WALWORTH COUNTY, WISCONSIN

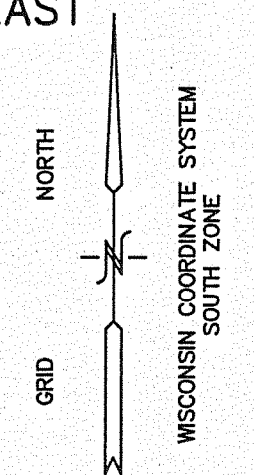

LEGAL DESCRIPTION

Unit 33-05, together with said unit's undivided appurtenant interest in the common elements all in Geneva National Condominium No. 33, a condominium declared and existing under and by virtue of the Condominium Ownership Act of the State of Wisconsin, dated the 14th day of May, 1990 and recorded by a Declaration as such condominium in the Office of the Register of Deeds for Walworth County, Wisconsin on June 5, 1990 in Volume 489 of Records, pages 116 to 162, as Document No. 195181, together with any addendums or amendments thereto, said condominium being located in the Town of Geneva, County of Walworth, State of Wisconsin on the real estate described in said Declaration and incorporated herein by this reference thereto.

Tax Key No. JGN 3300005

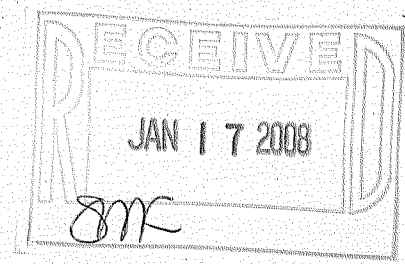


BENCH MARK
CHIZ "X"
UPPER FLANGE BOLT
HYDRANT
EL = 1078.57'

NOTE: COPIES OF THIS MAP TO WHICH THE FOLLOWING CERTIFICATE WILL APPLY SHOW SURVEYOR'S ORIGINAL SEAL AND SIGNATURE IN RED INK. COPIES BY ANY OTHER MEANS MAY HAVE ALTERATIONS WHICH DO NOT REPRESENT THE SURVEYOR'S WORK PRODUCT.


I HEREBY CERTIFY THAT THE ABOVE DESCRIBED PROPERTY HAS BEEN SURVEYED UNDER MY DIRECTION AND THAT THE ABOVE MAP IS A TRUE REPRESENTATION THEREOF AND SHOWS THE SIZE AND LOCATION OF THE PROPERTY, ITS EXTERIOR BOUNDARIES, THE LOCATION OF ALL VISIBLE STRUCTURES, AND DIMENSIONS OF ALL PRINCIPLE BUILDINGS THEREON, BOUNDARY FENCES, APPARENT EASEMENTS, ROADWAYS, AND VISIBLE ENCROACHMENTS, IF ANY. THIS SURVEY IS MADE FOR THE USE OF THE PRESENT OWNERS OF THE PROPERTY, AND ALSO THOSE WHO PURCHASE, MORTGAGE, OR GUARANTEE THE TITLE THERETO WITHIN ONE YEAR FROM THE DATE HEREOF.

DATED: MAY 19, 2004 01-07-2008
RESURVEYED

Peter S. Gordon
PETER S. GORDON R.L.S. 2101

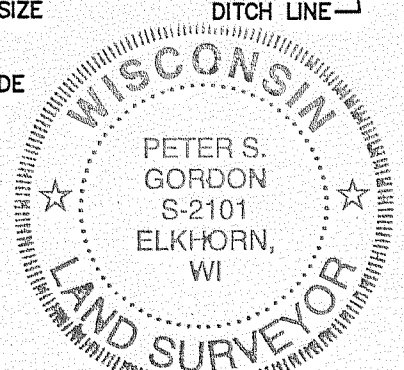

- = FOUND IRON REBAR STAKE
- = SET IRON REBAR STAKE
- (xxx) = RECORDED AS

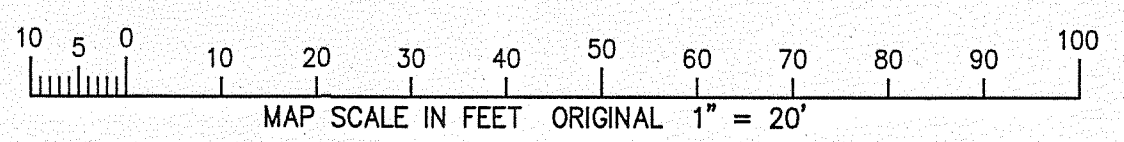

FARRIS, HANSEN & ASSOCIATES, INC
Engineering, Architecture, Surveying
7 Ridgway Court P.O. Box 437
ELKHORN, WISCONSIN 53121
Office: (262) 723-2098
Fax: (262) 723-5886

REVISIONS
07/27/2004
SITE, GRADING,
DRAINAGE, &
EROSION
CONTROL PLAN
11/24/2004
SHOW SIZE &
LOCATION OF
AS-BUILT
RESIDENCE
04/18/2006
SHOW AS-BUILT
DITCHLINE

PROJECT NO.
3269.33-05
DATE:
05-18-04
SHEET NO.
1 OF 1

JGN 33-5

217-3470