

PREPARED FOR
BOB KANONIK
1749 N. WELLS
UNIT 2006
CHICAGO IL. 60614




PLAT OF SURVEY

- OF -


KROTT SURVEYING INC.

N3705 WILLOW BEND LANE
LAKE GENEVA WI. 53147
PHONE # (262)248-3697
FAX # (262)249-0639


LOT 2 OF C.S.M. 3511 LOCATED IN THE SOUTHEAST 1/4 OF THE NORTHWEST 1/4
OF SECTION 28, T2N, R17E, WALWORTH COUNTY, WISCONSIN.

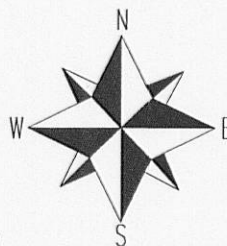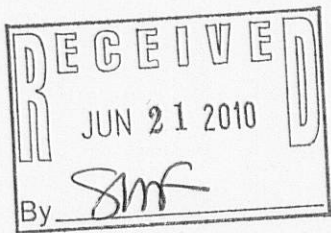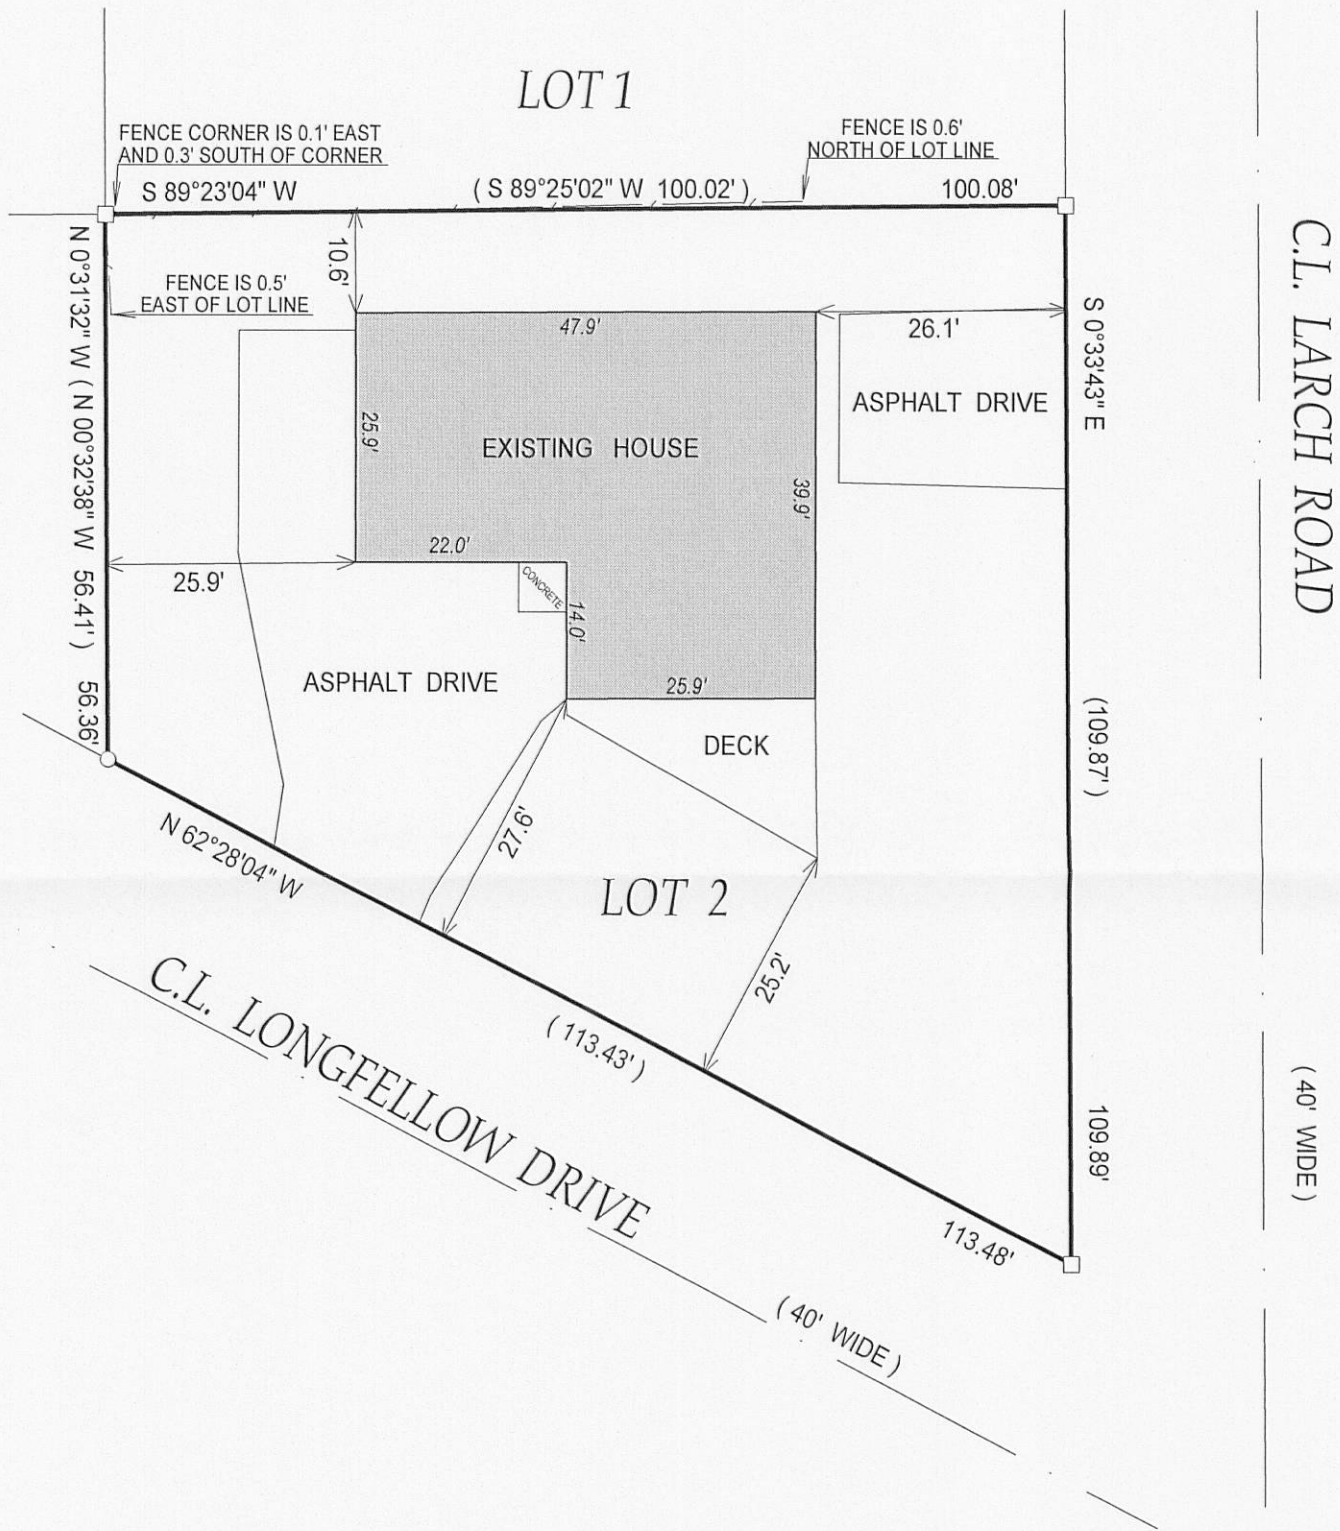

SCALE 1" = 20'

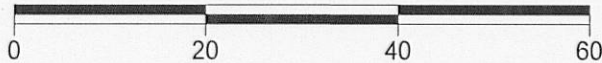

NOTE: BEARINGS ARE REFERENCED TO THE RECORD C.S.M.

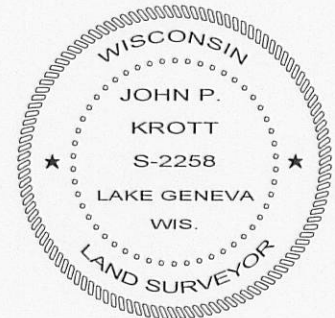

John P. Krott

JOHN KROTT S - 2258
Wisconsin Registered Land Surveyor
(original if signed in red)

DATED THIS 20th DAY OF APRIL 2010.

LEGEND

- FOUND IRON PIPE
- FOUND IRON BAR

(XX) RECORDED AS
TAX ID # JA351100002
JOB # 03-031A UD

I have surveyed the above-described property and the above map is a true representation thereof and shows the size and location of the property, its exterior boundaries, the location and dimensions of all structures thereon, fences apparent easements and roadways and visible encroachments, if any.

This survey is made for the exclusive use of the present owners of the property, and also those who purchase, mortgage, or insure the title thereto within one (1) year from date hereof; and as to them I warrant the accuracy of said survey map.

217 3117