
PREPARED FOR PAMALA HANSON - MILLER


## PLAT OF SURVEY

- OF -

LOT 2 OF WALWORTH COUNTY CERTIFIED SURVEY MAP No. 160 RECORDED IN VOLUME 1, PAGE 160 OF CERTIFIED SURVEYS, AT THE WALWORTH COUNTY REGISTER OF DEEDS, BEING A PART OF THE NE 1/4 OF THE NW 1/4 OF SECTION 35, TOWN 2 NORTH, RANGE 17 EAST, TOWN OF GENEVA, COUNTY OF WALWORTH AND STATE OF WISCONSIN. TOGETHER WITH A NON - EXCLUSIVE EASEMENT FOR INGRESS AND EGRESS AS SHOWN ON SAID CERTIFIED SURVEY No. 160.

PATHFINDER SURVEYING INC. (formerly) J.K. SURVEYING INC. P.O BOX 322 LAKE GENEVA, WI. 53147 WWW.PATHFINDERSURVEYING.NET 262-248-8303

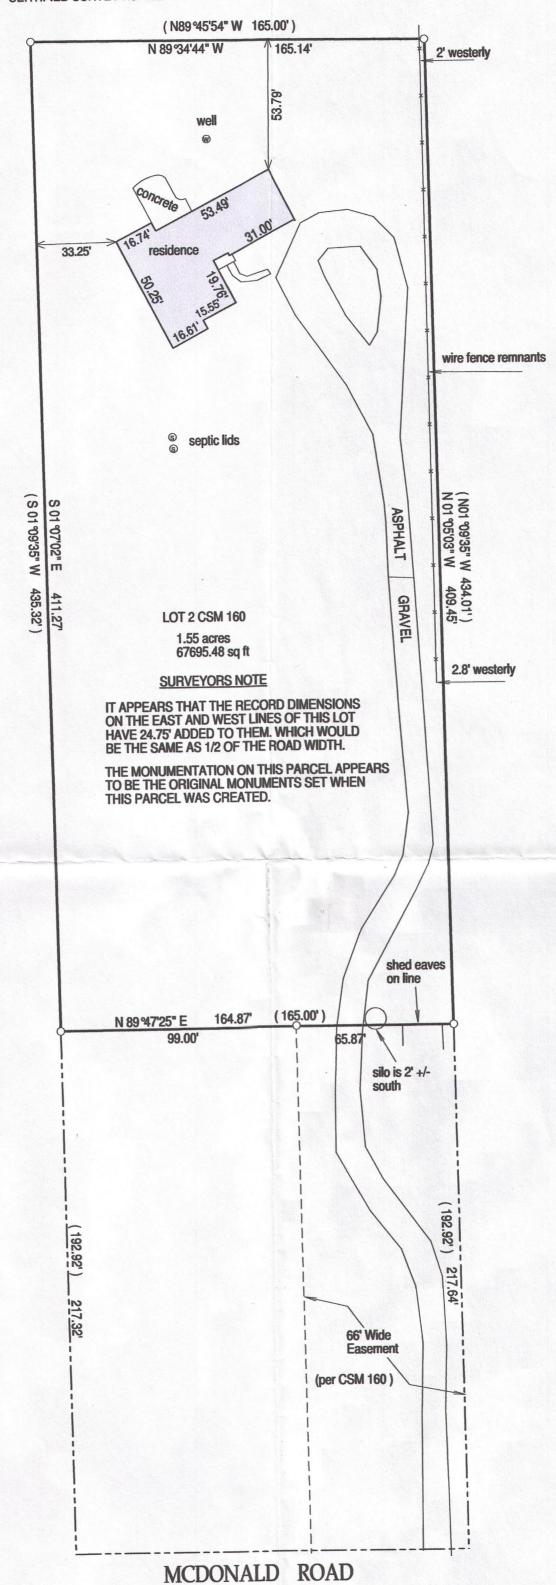

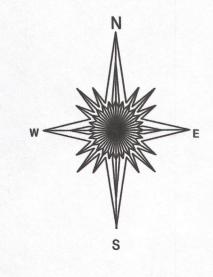


( )= recorded as

- $\Box$  = found iron bar
- = found iron pipe
- = set iron pipe
- = set iron bar SCALE 1" = 40'

JOB # 14-238

TAX ID # JA16000002

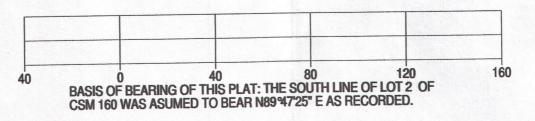


(49.5' WIDE)

I hereby certify that I have surveyed the above-described property and the above map is a is a true representation thereof and shows the size and location of the property, its exterior boundaries, the location and dimensions of all structures thereon, fences, apparant easements and roadways and visible encroachments if any.

This survey is made for the present owners of the property, and those who purchase, mortgage, or guarantee the title thereto, within one year from the data hazarf

DATED THIS 5TH DAY OF OCTOBER, 2014.



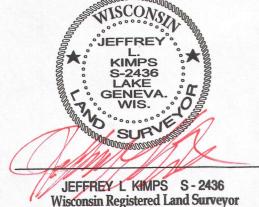

JEFFREY L KIMPS S - 2436 Wisconsin Registered Land Surveyor ( original if signed in red )