

FARRIS, HANSEN & ASSOCIATES, INC.

ENGINEERING — ARCHITECTURE — SURVEYING
7 RIDGWAY COURT — P.O. BOX 437 — ELKHORN, WISCONSIN 53121
PHONE: (262) 723-2098 FAX: (262) 723-5886



— WORK ORDERED BY —
ODLING CONSTRUCTION
4941 TOWNHALL ROAD
DELAVER, WI. 53115

PLAT OF SURVEY

LOT 1 OF CERTIFIED SURVEY MAP NO. 2155
LOCATED IN THE NW 1/4 & THE SW 1/4 OF THE SW 1/4 SECTION 19
TOWN 2 NORTH, RANGE 17 EAST
WALWORTH COUNTY, WISCONSIN

ASSIGNED EAST LINE LOT 1
S 00°03'18" E

STATE TRUNK HIGHWAY "6"

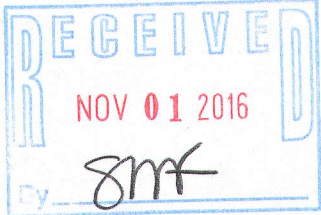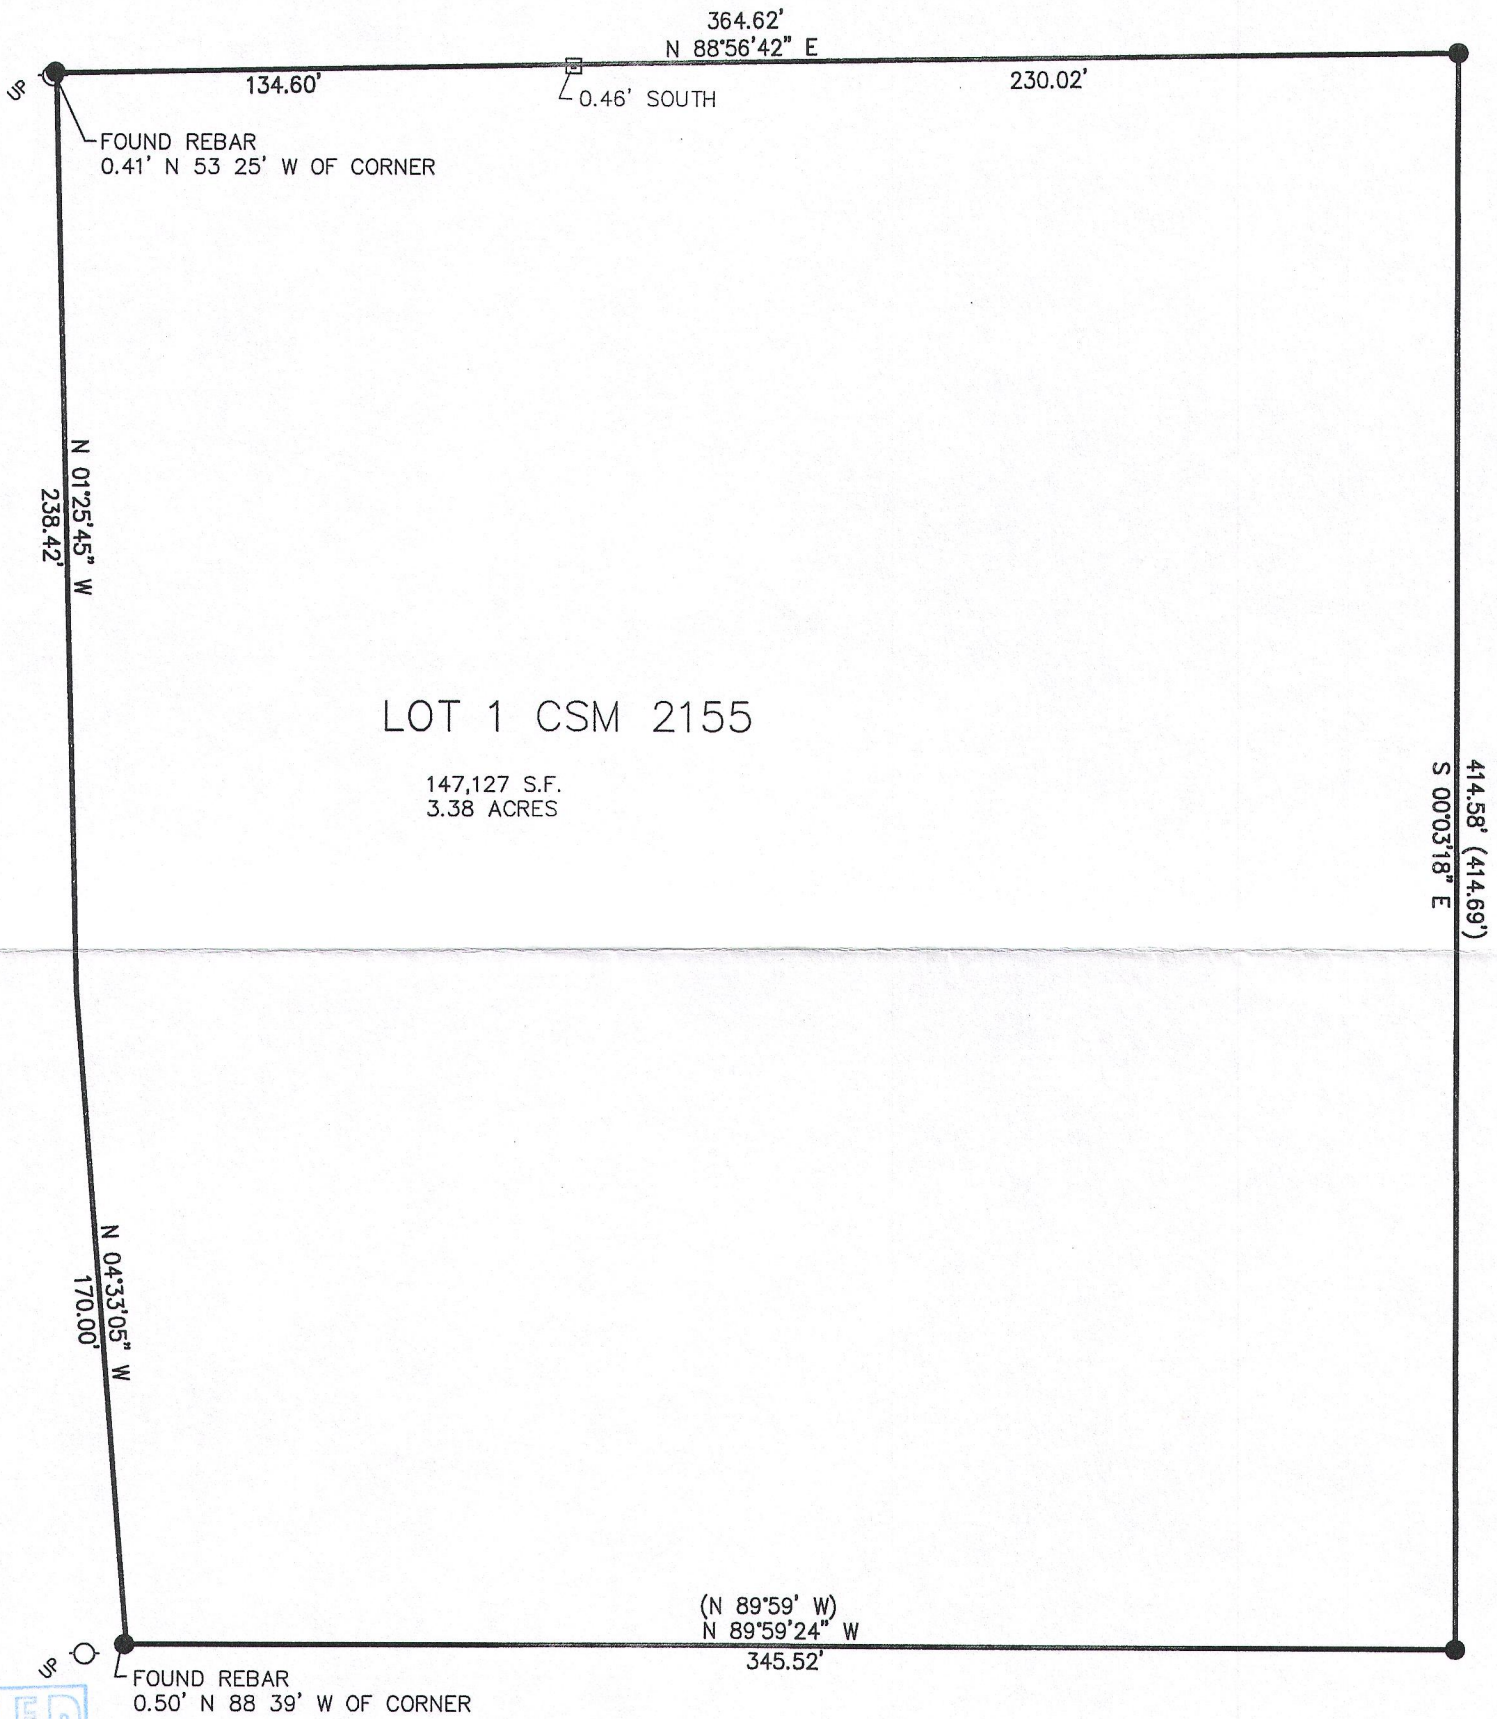


100 90 80 70 60 50 40 30 20 10 0 50 100
MAP SCALE IN FEET ORIGINAL 1" = 50'

LEGEND

NOTE: COPIES OF THIS MAP TO WHICH THE FOLLOWING CERTIFICATE WILL APPLY SHOW THE SURVEYOR'S ORIGINAL SEAL AND SIGNATURE IN RED INK. COPIES BY ANY OTHER MEANS MAY HAVE ALTERATIONS WHICH DO NOT REPRESENT THE SURVEYOR'S WORK PRODUCT.

I HEREBY CERTIFY THAT THE ABOVE DESCRIBED PROPERTY HAS BEEN SURVEYED UNDER MY DIRECTION AND THAT THE ABOVE MAP IS A TRUE REPRESENTATION THEREOF AND SHOWS THE SIZE AND LOCATION OF THE PROPERTY AND ITS EXTERIOR BOUNDARIES. THIS SURVEY IS MADE FOR THE USE OF THE PRESENT OWNERS OF THE PROPERTY, AND ALSO THOSE WHO PURCHASE, MORTGAGE, OR GUARANTEE THE TITLE THERETO WITHIN ONE YEAR FROM THE DATE HEREOF.

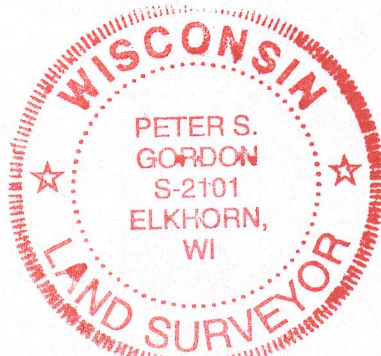

- = FOUND IRON REBAR STAKE
- = FOUND CONCRETE MONUMENT
- (XXX) = RECORDED AS

DATED: OCTOBER 3, 2016

PETER S. GORDON P.L.S. 2101

PROJECT: 3596.16
DATE: 10-03-2016
SHEET 1 OF 1