


NOTE:  
1. BASIS OF BEARING: THE WISCONSIN STATE PLANE COORDINATE SYSTEM, NAD-83, SOUTH ZONE.  
2. FIELD WORK COMPLETED JUNE 30TH, 2021  
3. BUILDING SURVEYED TO THE EXTERIOR OF SIDING.  
4. FIELD CREW CHIEF: RAY MCARDLE

LEGEND

- FOUND 1" IRON PIPE
- EXISTING BUILDING
- EXISTING DECK
- EXISTING CONCRETE
- ⊙ EXISTING WELL
- UTILITY POLE
- XB - METAL FENCE
- SEPTIC EASEMENT

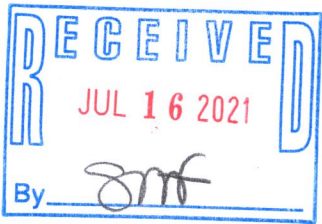


PLAT OF SURVEY

A PARCEL OF LAND LOCATED IN THE NORTHEAST 1/4 OF THE NORTHWEST 1/4 OF SECTION 35 IN TOWNSHIP 2 NORTH, RANGE 17 EAST, IN THE TOWN OF GENEVA, WALWORTH COUNTY, WISCONSIN.



SCALE: 1"=30'

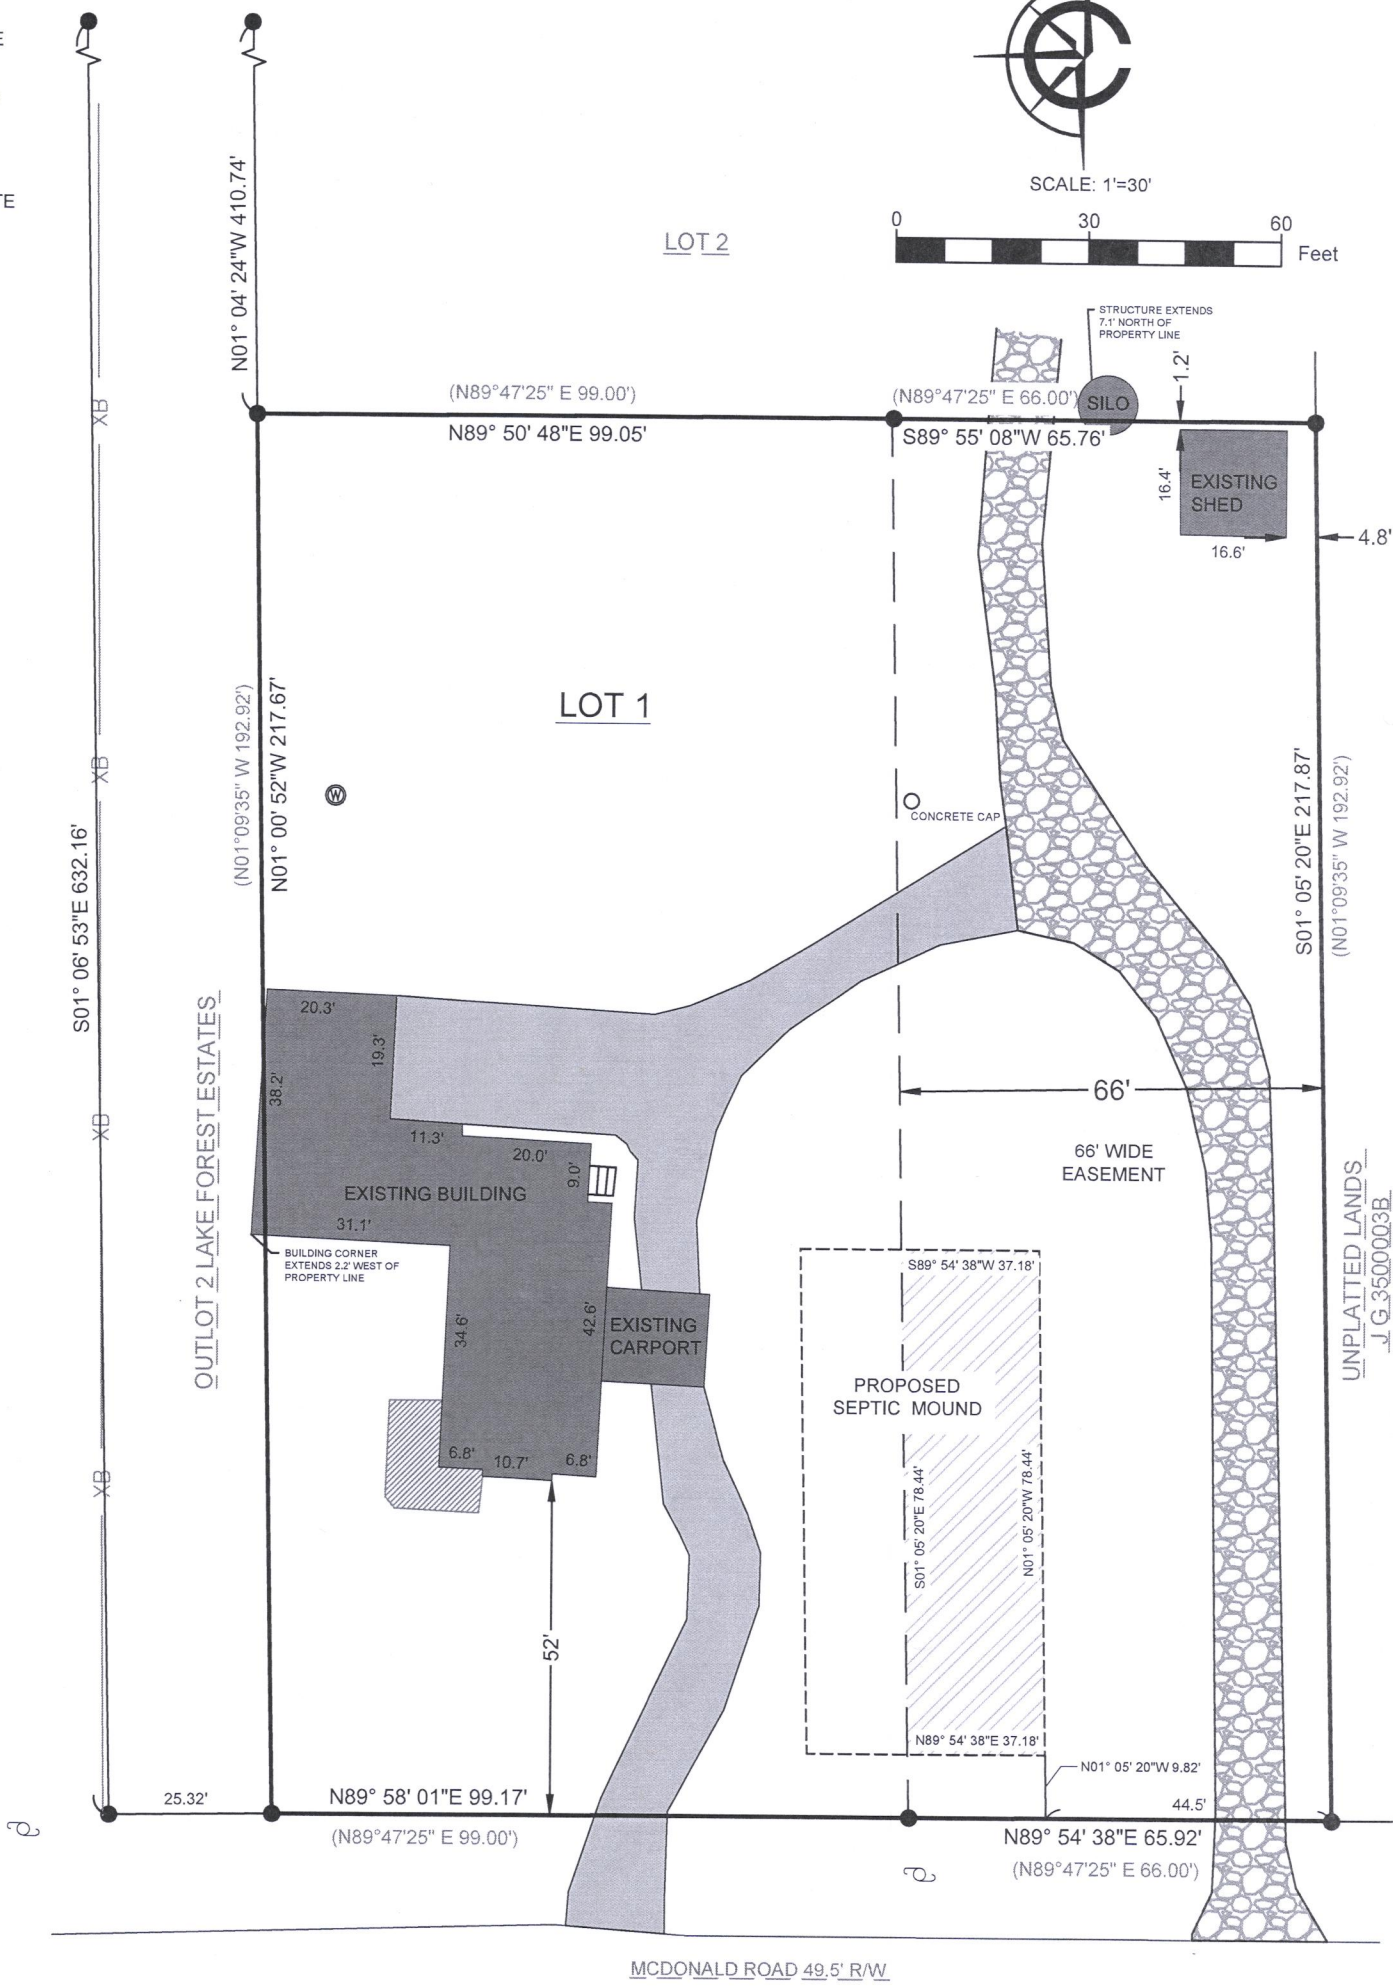

LEGAL DESCRIPTION:

A PARCEL OF LAND LOCATED IN THE NORTHEAST 1/4 OF THE NORTHWEST 1/4 OF SECTION 35 IN TOWNSHIP 2 NORTH, RANGE 17 EAST, IN THE TOWN OF GENEVA, WALWORTH COUNTY, WISCONSIN, MORE PARTICULARLY DESCRIBED AS:

LOT 1 CERT SURVEY NO. 160 RECORDED IN DOCUMENT#P652691 IN THE WALWORTH COUNTY REGISTER OF DEEDS.

SURVEY ORDERED BY:


NEIL NARUT

PROPERTY ADDRESS:

W3194 McDONALD ROAD  
LAKE GENEVA, WI 53147

SURVEYOR:

PAUL H. VAN HENKELUM, PLS  
CARDINAL ENGINEERING LLC

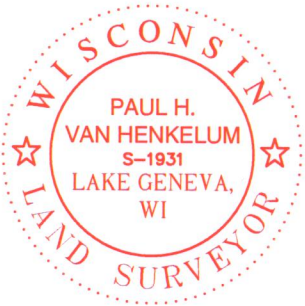

"I HEREBY CERTIFY THAT I HAVE SURVEYED THE ABOVE DESCRIBED PROPERTY AND THE MAP IS A TRUE AND CORRECT REPRESENTATION OF ITS EXTERIOR BOUNDARIES AND SHOWS THE SIZE AND LOCATION OF ALL VISIBLE STRUCTURES, APPARENT EASEMENTS AND ENCROACHMENTS, IF ANY."

*Paul H. Van Henkelum*  
PAUL H. VAN HENKELUM, PLS #1931

*7/2/2021*  
DATE



CARDINAL ENGINEERING LLC  
DESIGNING IN TRUE DIRECTIONS

PO BOX 281 - 1200 LA SALLE ST.  
LAKE GENEVA, WI 53147  
262-757-8776  
CARDINALENGINEERINGWI.COM

DATE: 07/02/2021 JOB No. 21427  
SHEET 1 OF 1 JDB

JA 160-1

217-4817