


KOLB LAND CONSULTING, INC.
 LAND SURVEYING • SUBDIVIDING • LAND PLANNING

LAKE GENEVA, WISCONSIN 53147



WHITEWATER, WISCONSIN 53190

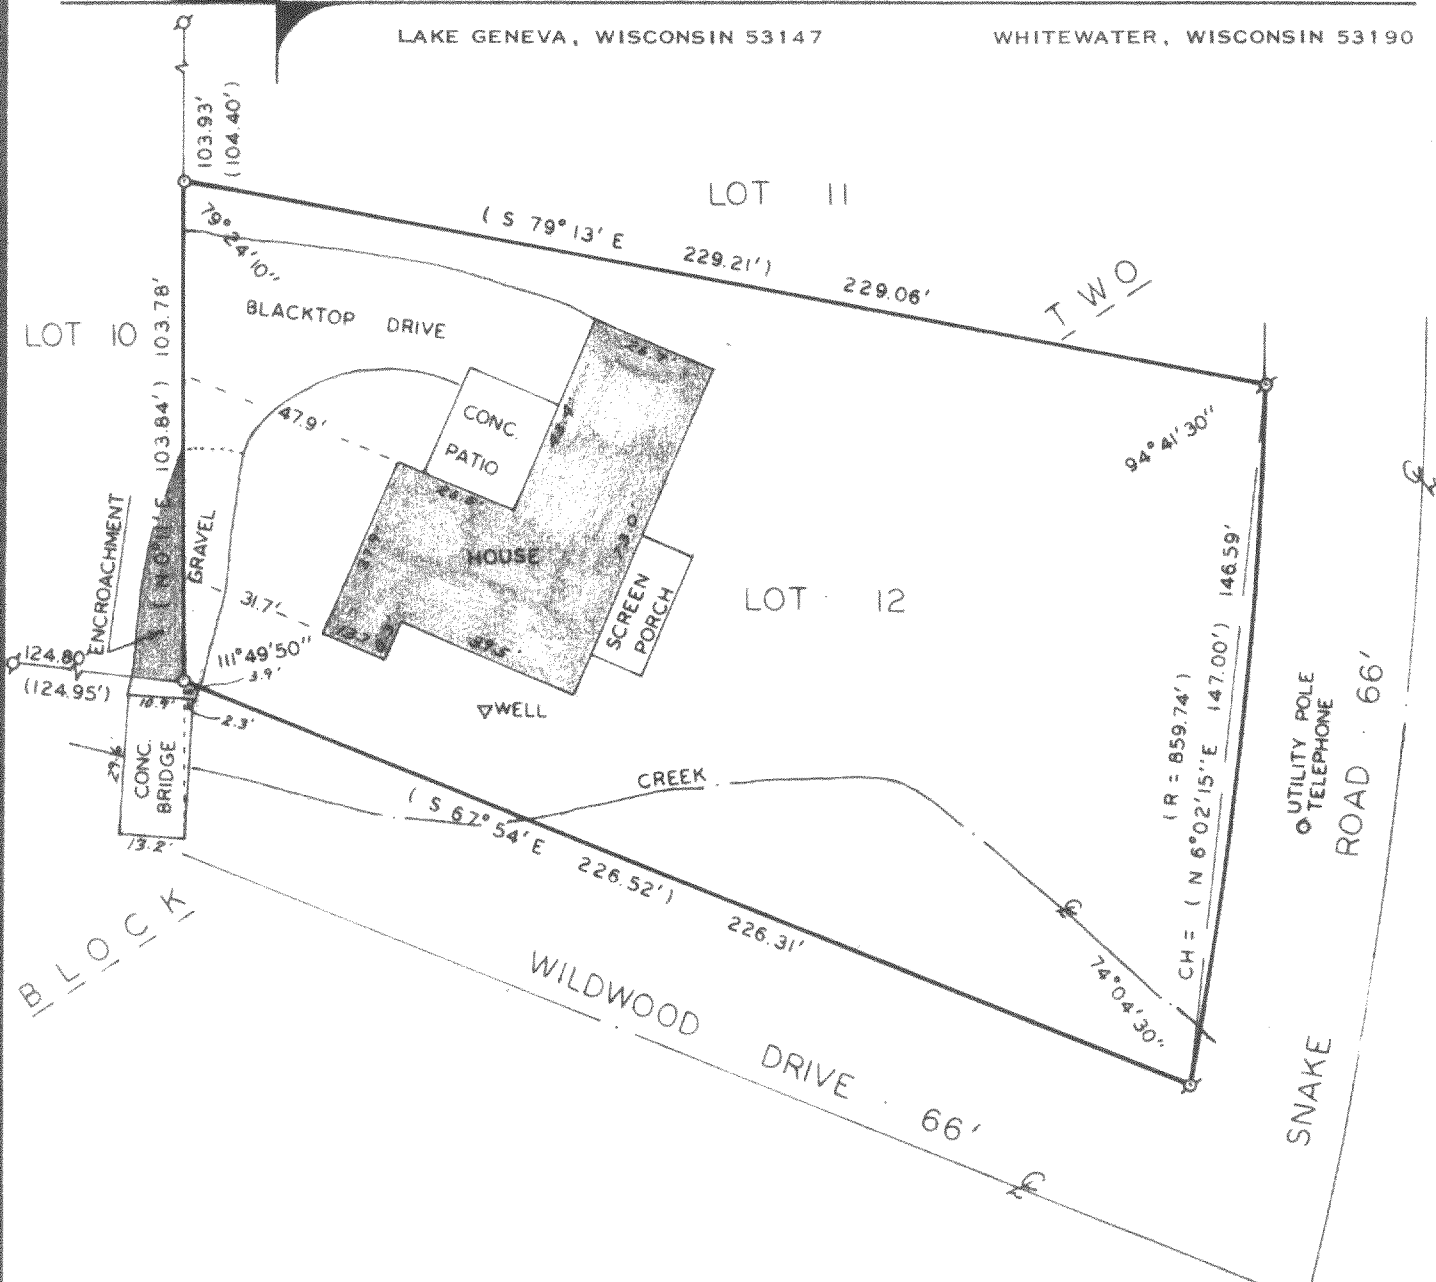

PLAT OF SURVEY OF

LOT 12, BLOCK TWO OF GENEVA BAY ESTATES,
 TOWN 2 NORTH, RANGE 17 EAST, WALWORTH
 COUNTY, WISCONSIN.

OWNER: MIKE KEEFE C/O KEEFE REAL ESTATE
 704 MAIN STREET
 LAKE GENEVA, WI 53147

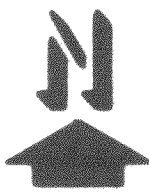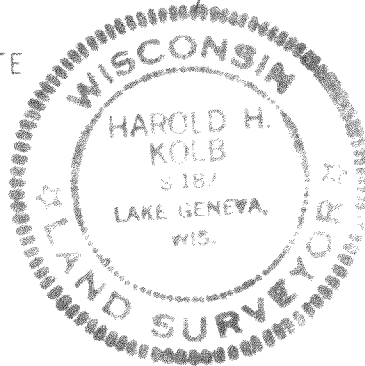

SCALE - 1"=40'

- LEGEND
- ⊗ - IRON PIPE FOUND
 - - IRON PIPE SET
 - () - RECORDED AS

I, HAROLD H. KOLB, DO HEREBY CERTIFY
 THAT I HAVE SURVEYED THE PROPERTY
 HEREON DESCRIBED ACCORDING TO THE
 OFFICIAL RECORDS, AND THAT THE PLAT
 HEREON IS A CORRECT REPRESENTATION
 OF THE LOT LINES TO THE BEST OF MY
 KNOWLEDGE AND BELIEF.

Harold H. Kolb
 HAROLD H. KOLB
 WISCONSIN REGISTERED LAND SURVEYOR, S-187
 DATE Jun. 26, 1985

217-586-K